


11523

TURNPIKE

OHIO

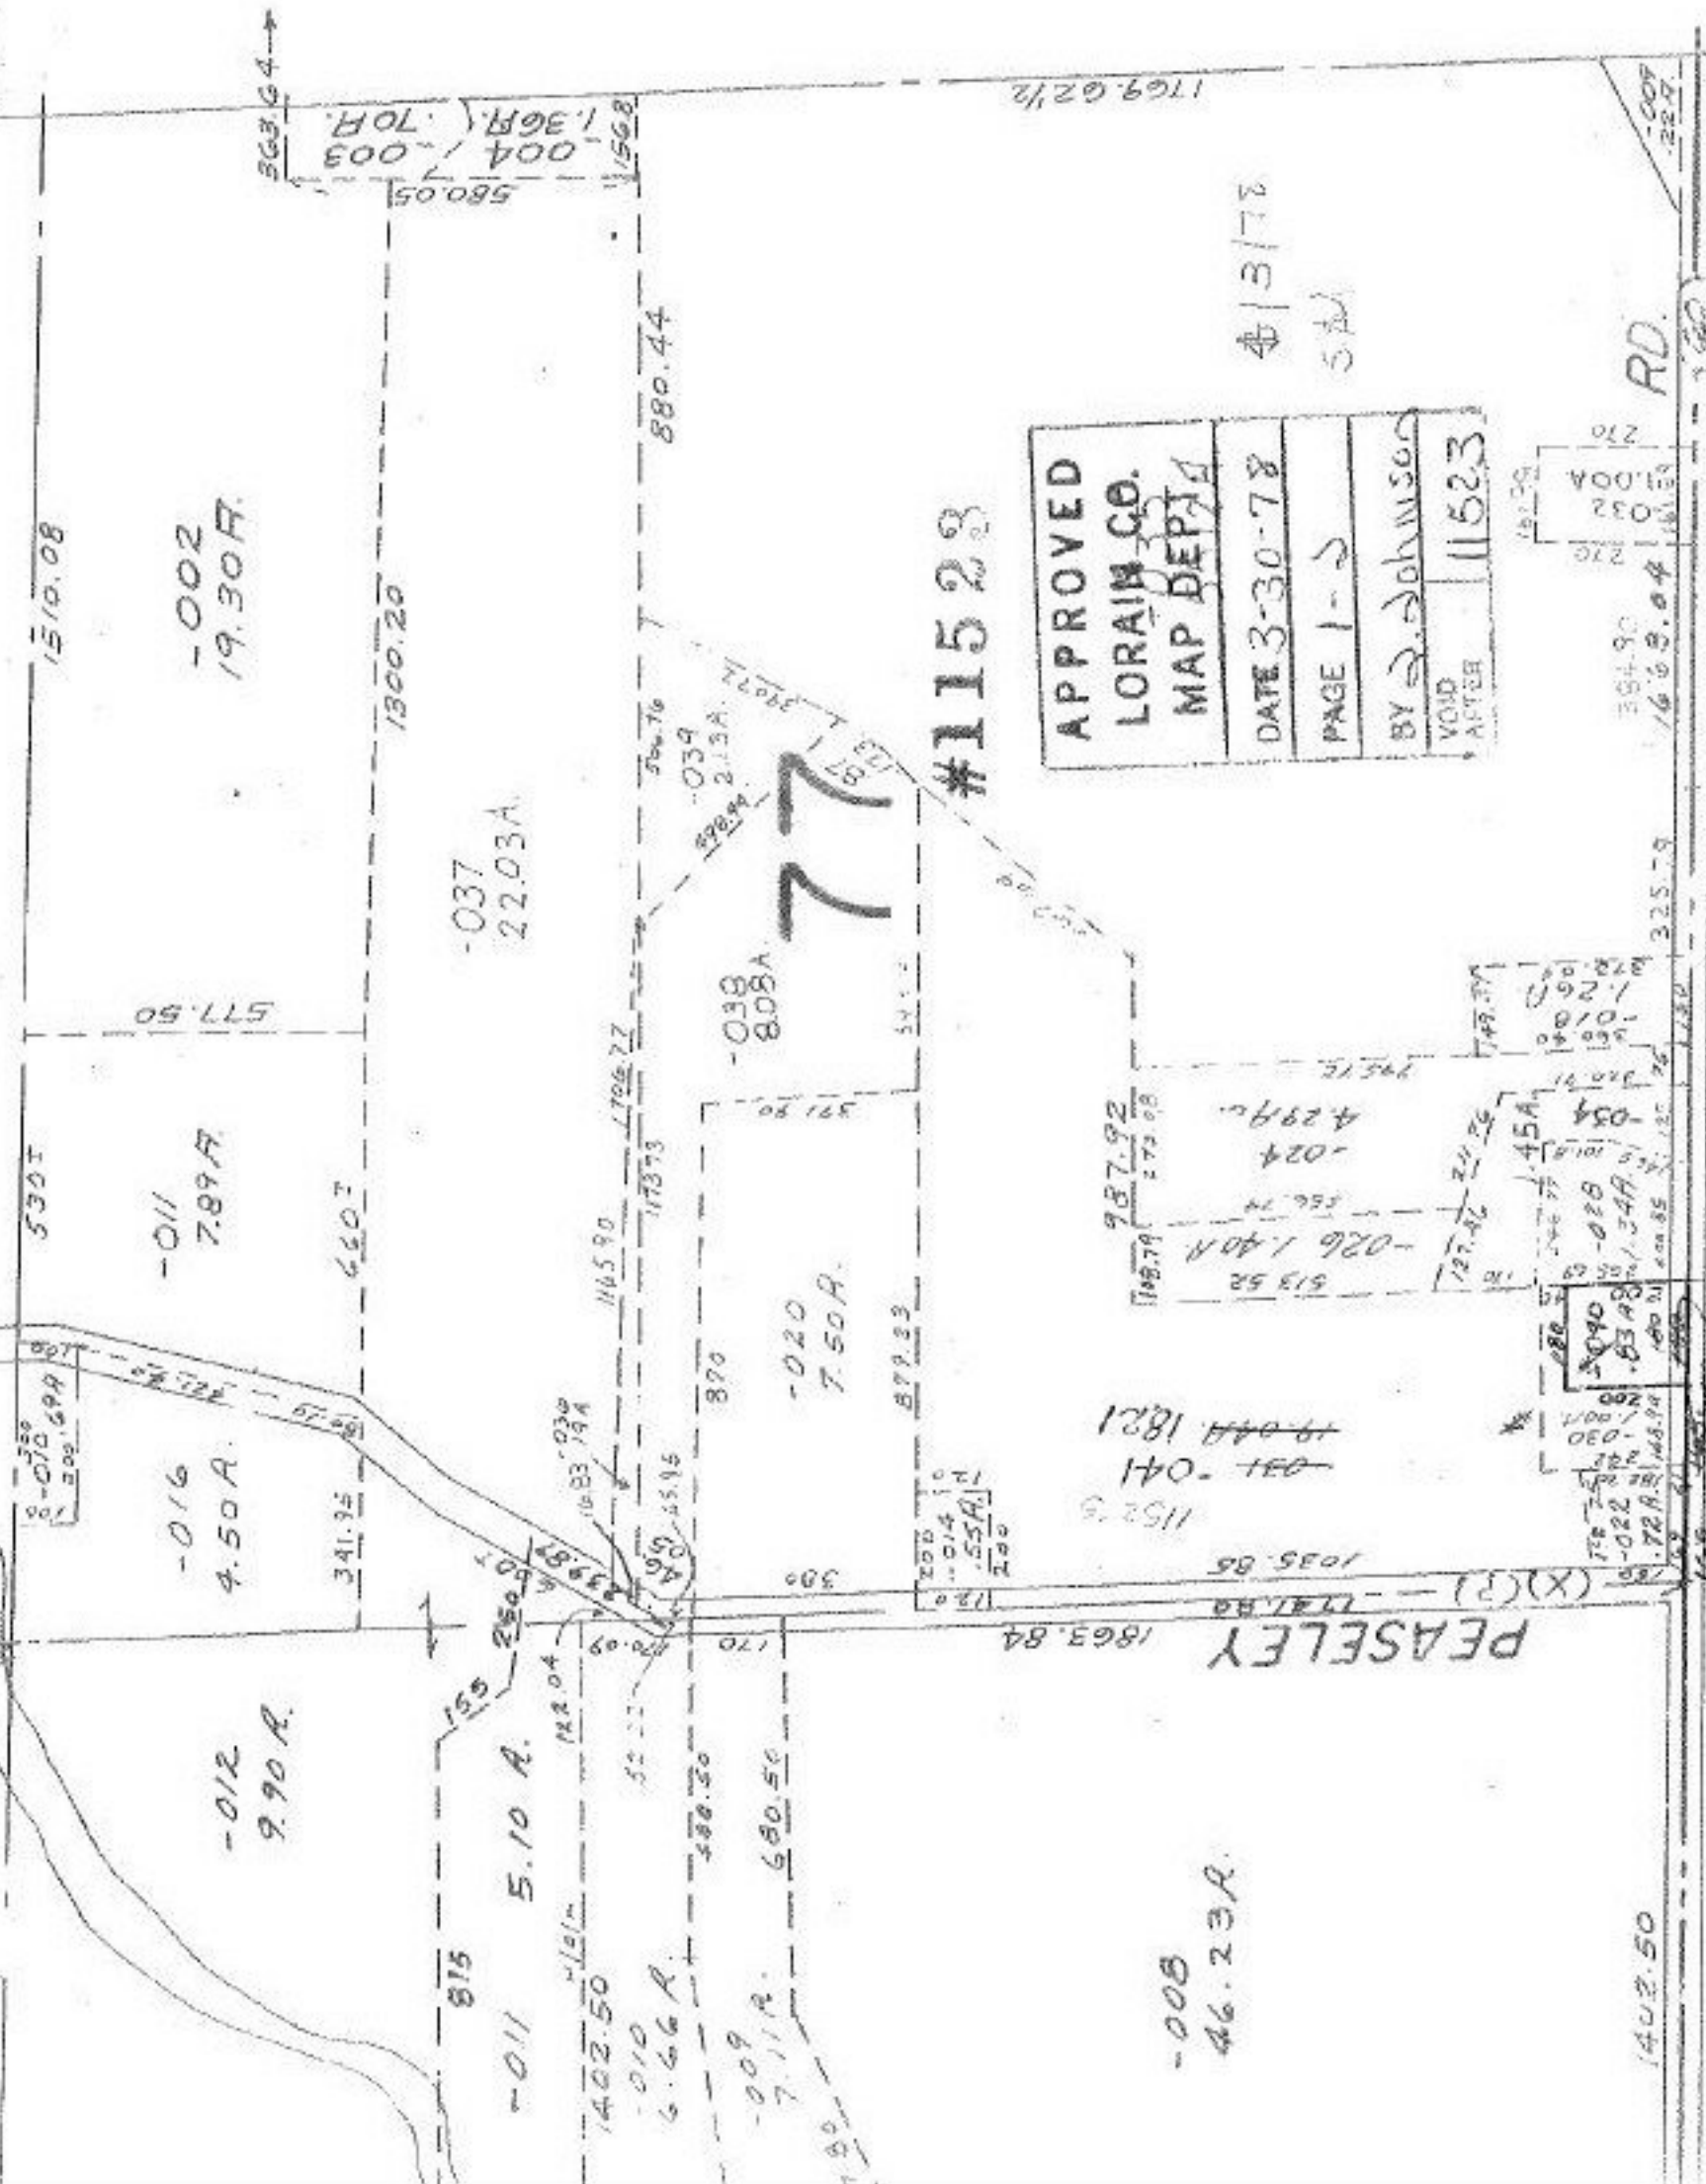

#11523

APPROVED
 LORAIN CO.
 MAP DEPT

DATE 3-30-78
 PAGE 1-2
 BY S. Johnson
 VOID AFTER 11523

4/3/78
S.A.J.

RD.

PEASELEY

1863.84

-008
46.23 R.

-012
9.90 R.

-016
4.50 A.

-011
7.89 A.

-037
22.03 A.

-038
8.08 A.

77

-020
7.50 A.

-002
19.30 R.

1402.50

16994 180

354.90
 1663.04
 270
 0.04
 270
 161.53

1769.02 1/2

563.64

580.05

1300.20

1510.08

5301

571.50

6607

880.44

1706.77

1465.90

870

879.33

300

200

130

1035.85

1741.80

1863.84

170

52.22

488.30

680.50

1402.50

123.04

123.04

