


#11524

APPROVED
LORAIN CO.
MAP DEPT.
DATE 3-30-78
PAGE 6-65
BY *Amelise*
VOID
AFTER 11524

Q. T. 4-9-78

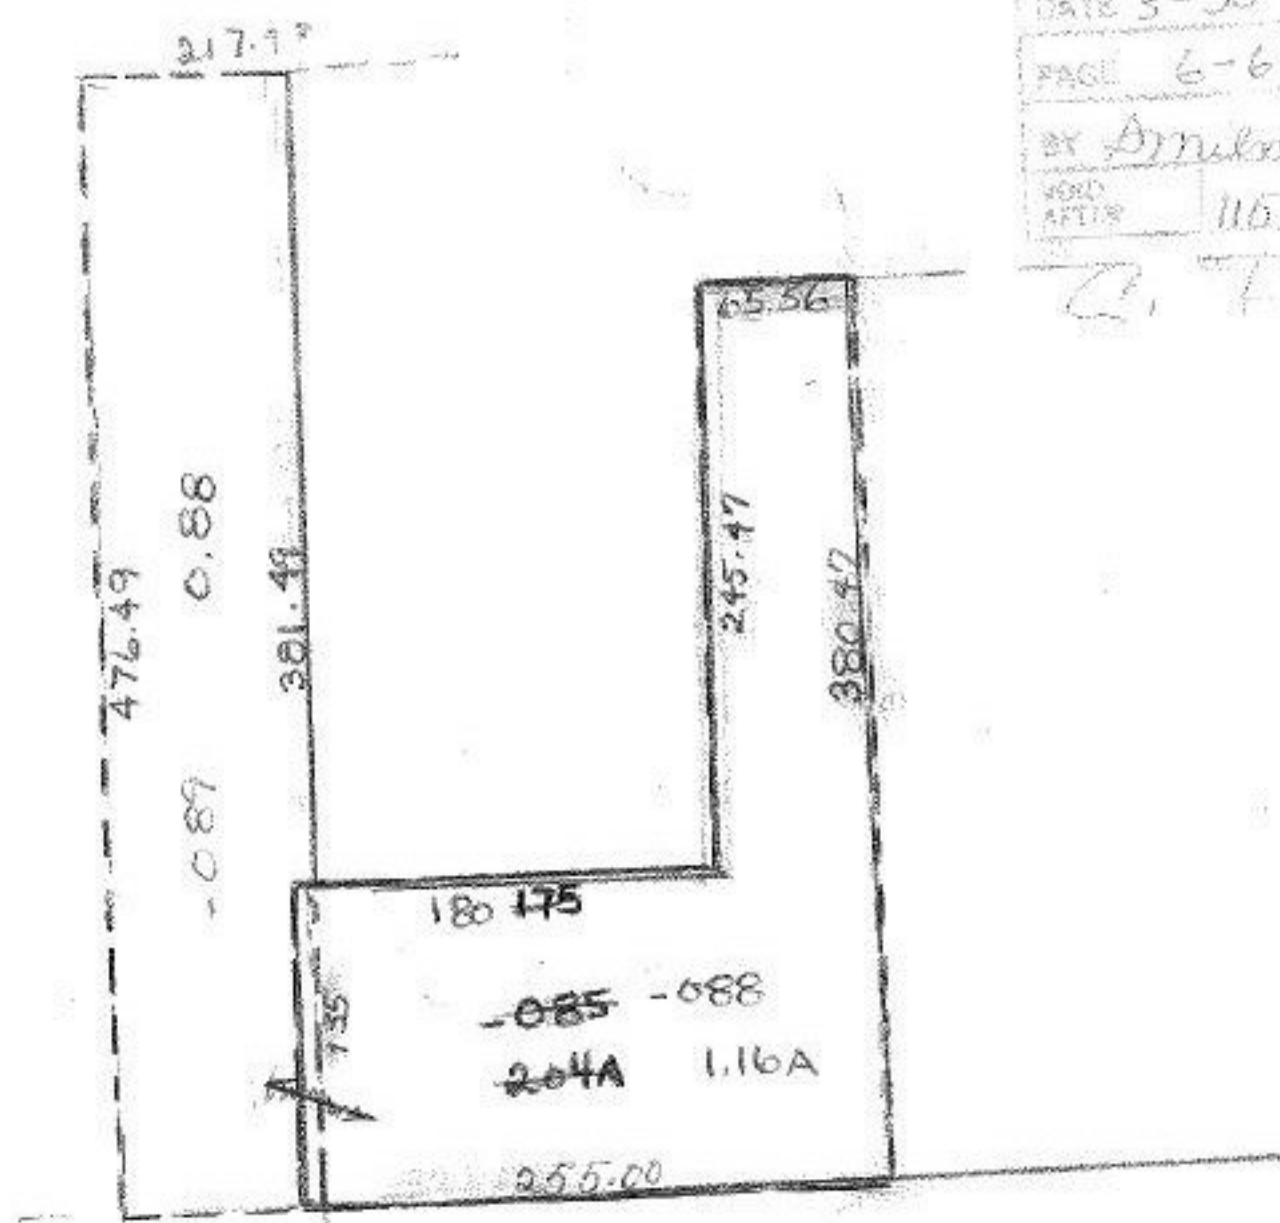

327.12
255.00

72.12