

L #11527


APPROVED LORAIN CO. MAP DEPT.	
DATE	3-31-78
PAGE	3-00-016 ^B
BY	DM [Signature]
VOID AFTER	#11527

4-6-78

J.V.

-003
3.63 A.

80727

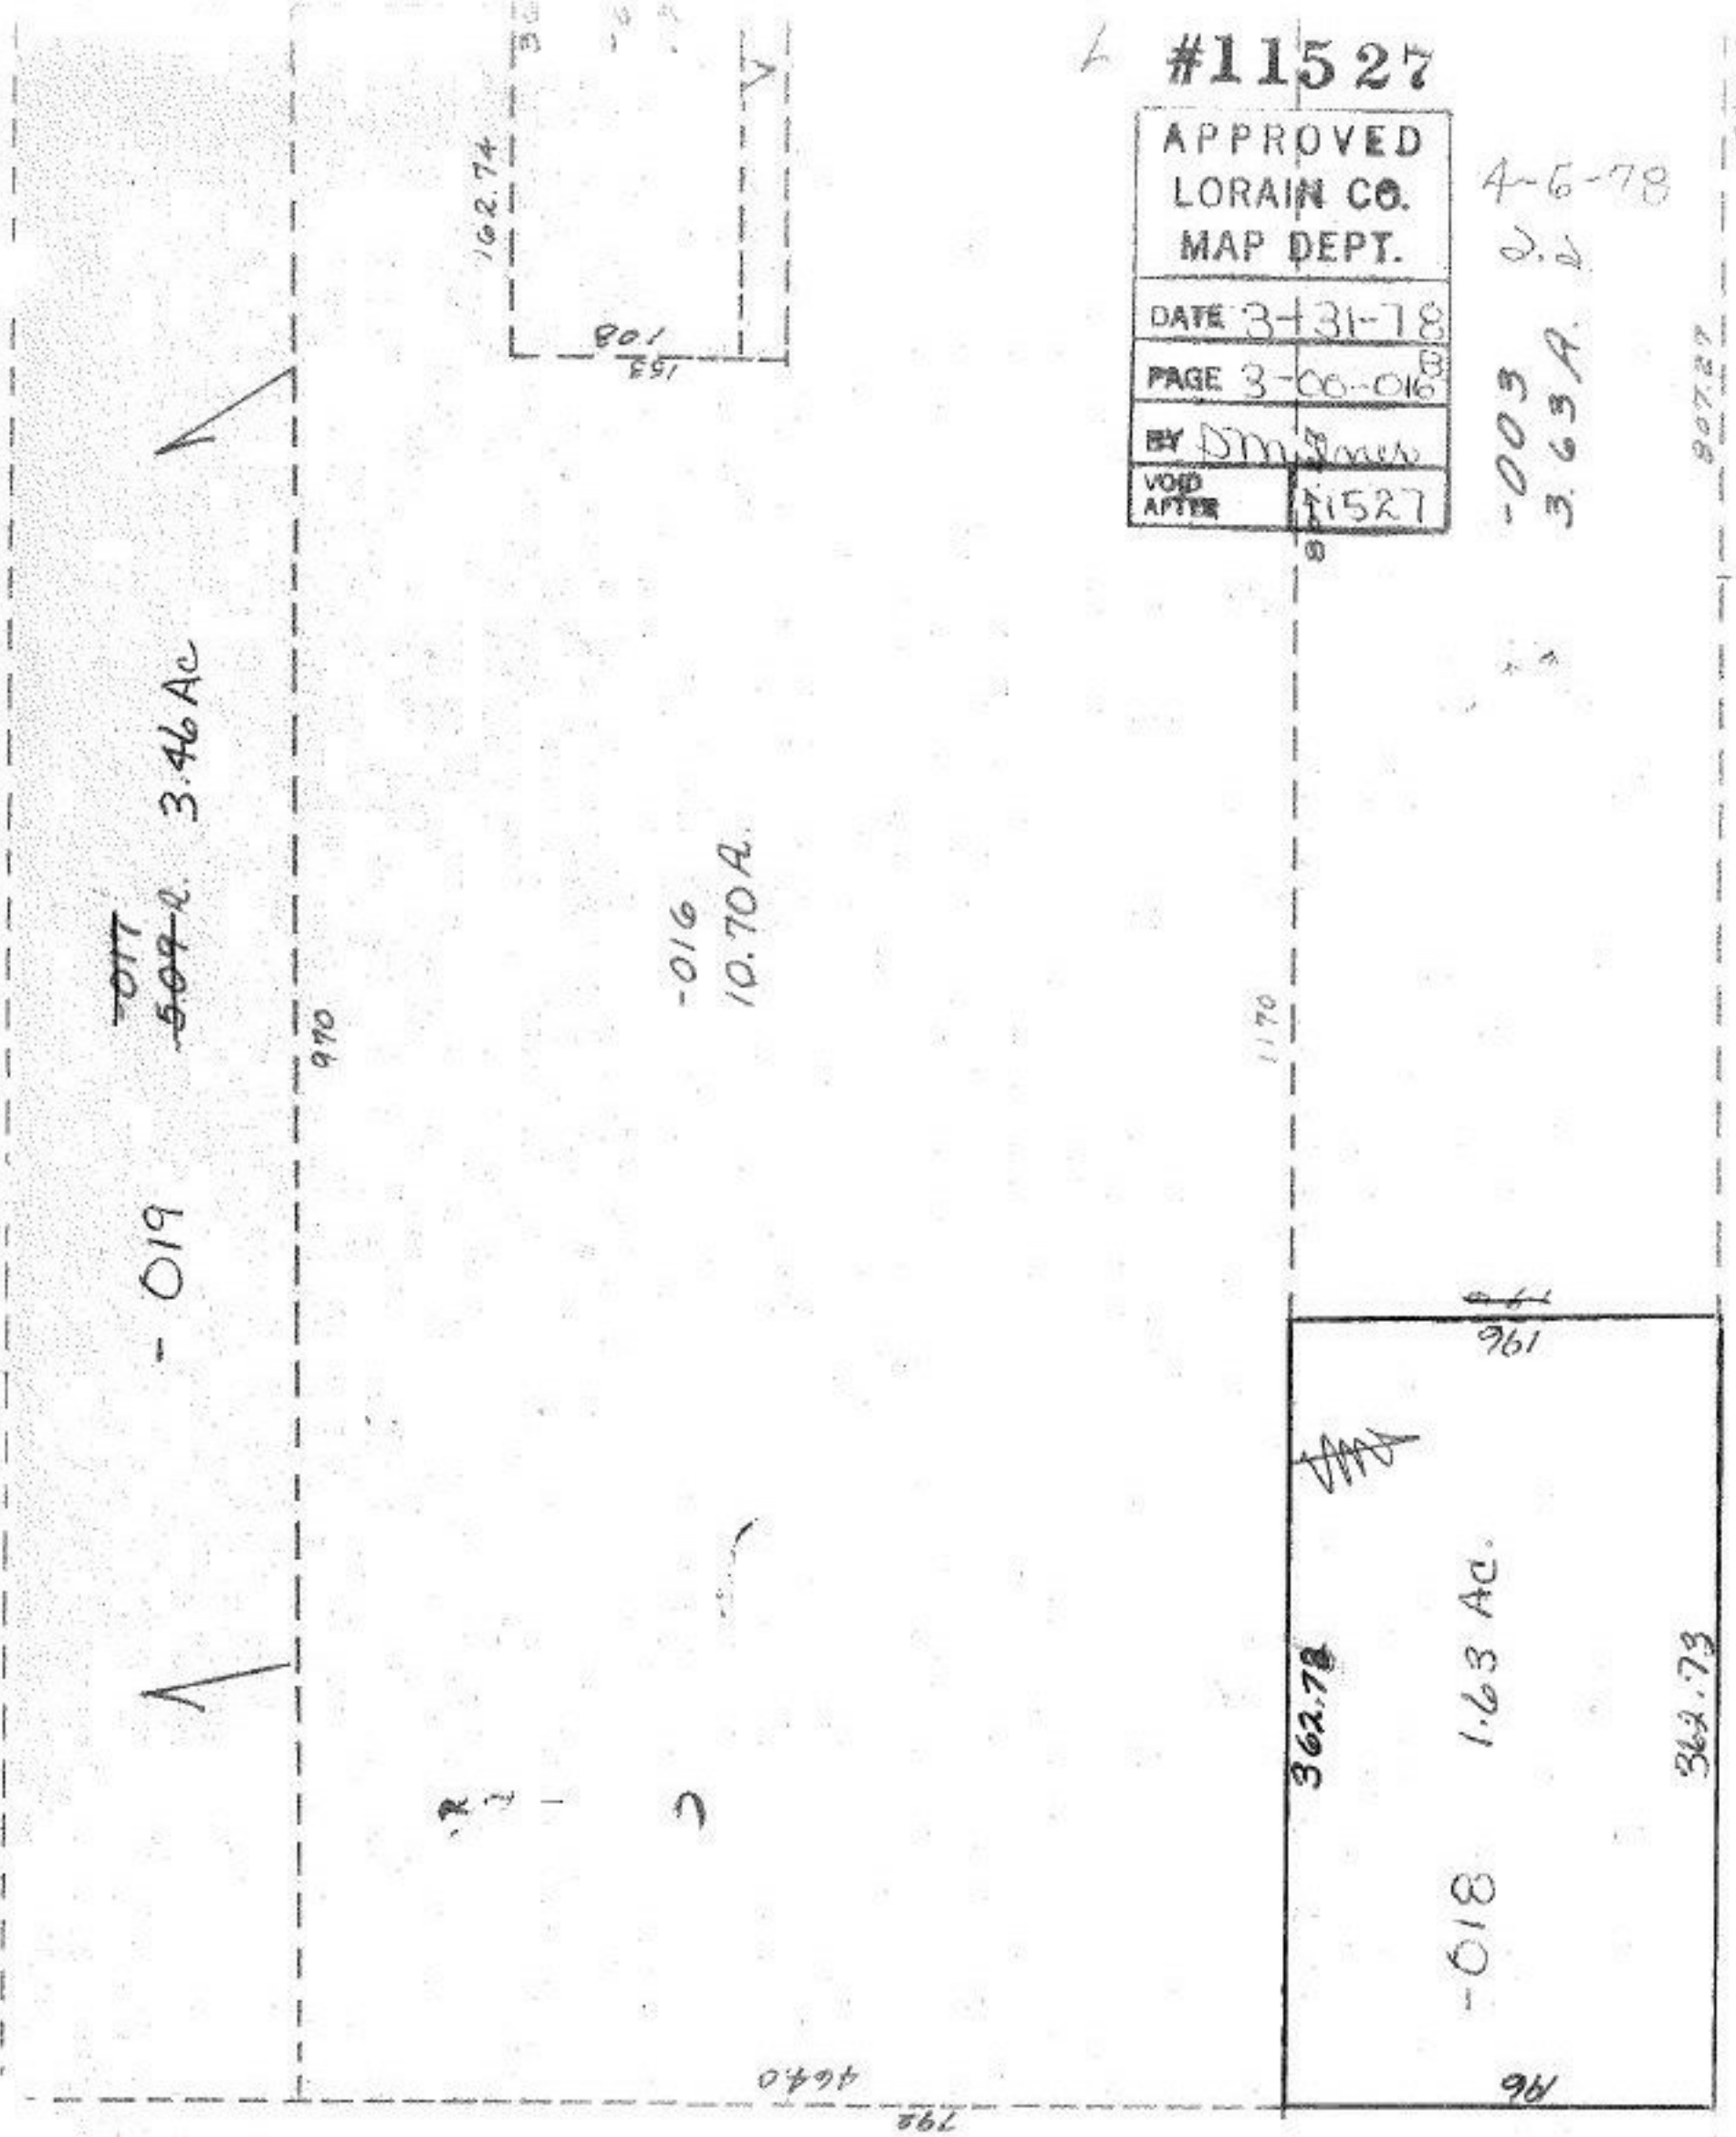

~~017~~
~~509 A.~~ 3.46 AC

-019

970

162.74

362.73
153

-016

10.70 A.

464.0

1170

362.78

-018 1.63 AC.

961

362.73

96

110
319 80