


11558

Moore




Alley Vac. By Ord #8613 12-16-63

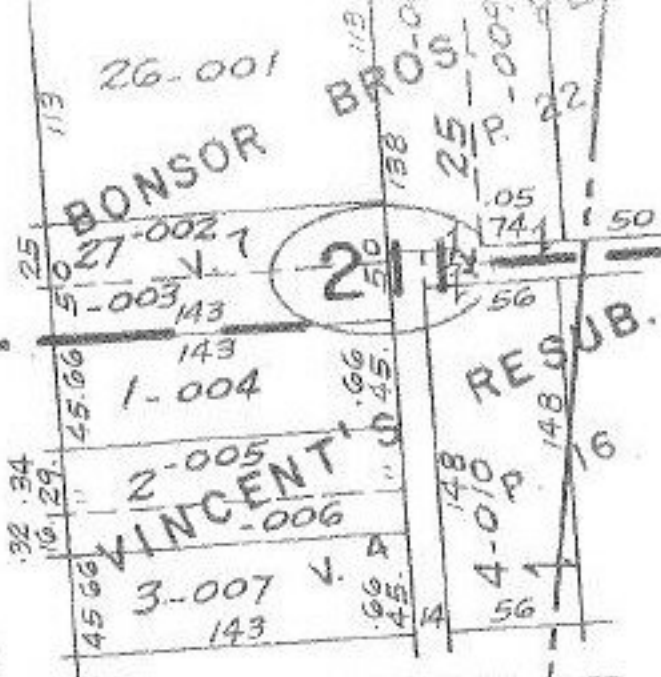

#11558

APPROVED
LORAIN CO.
MAP DEPT.
DATE 4/20/78
PAGE 2-01-003 J
BY T. M. Mann
VOID AFTER 11558

Cit. 5-12-78

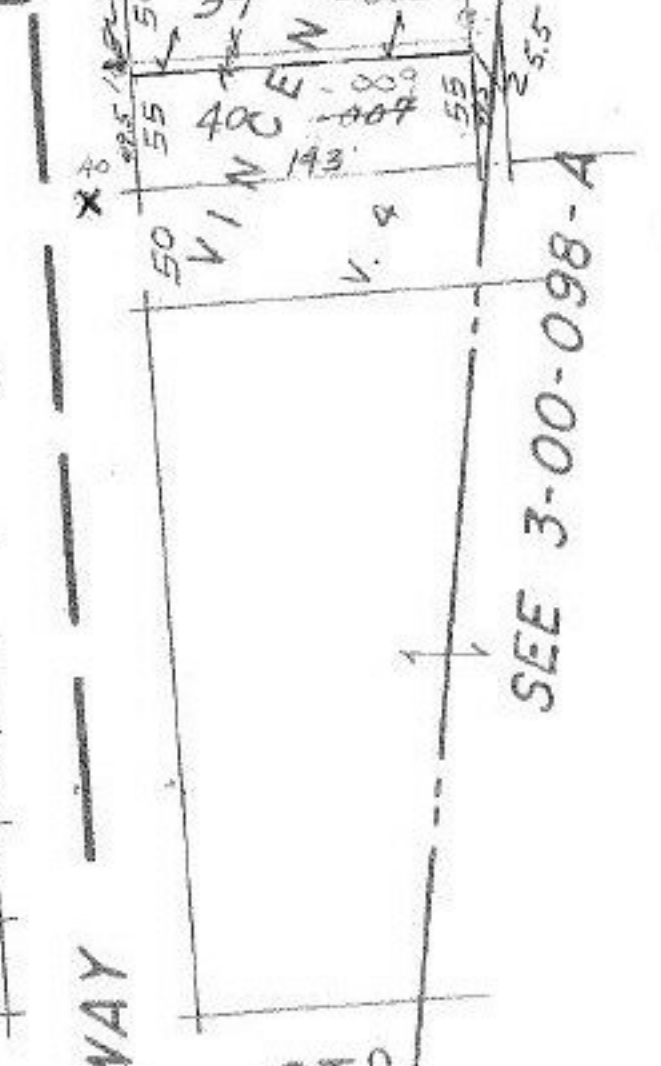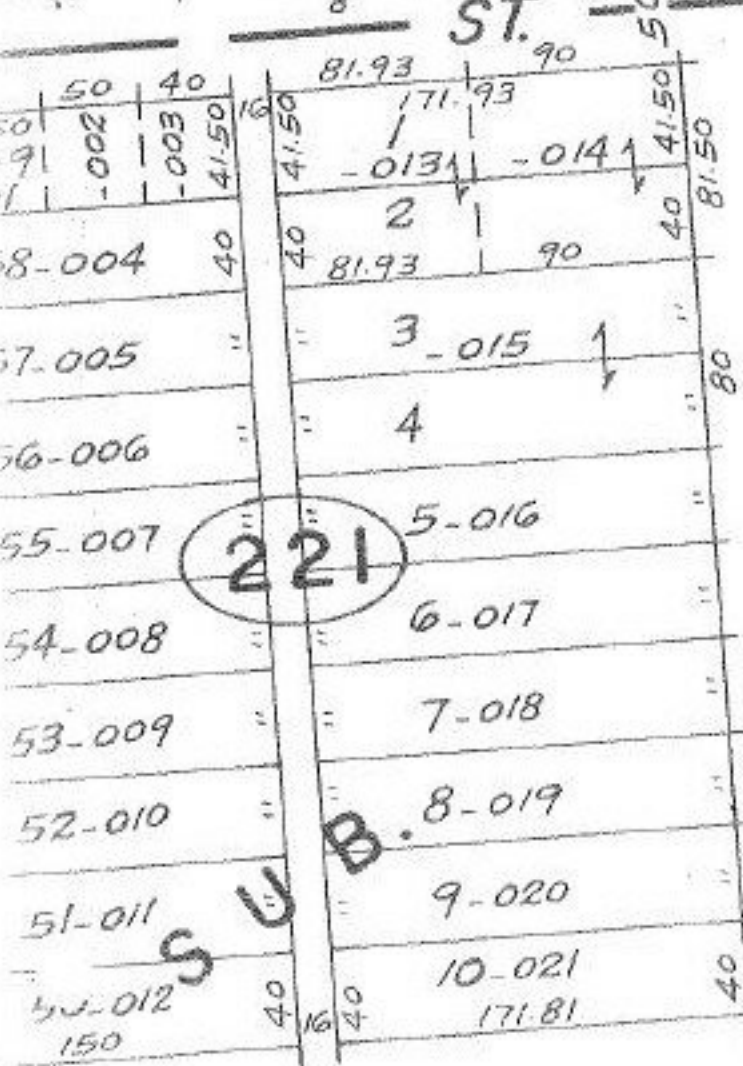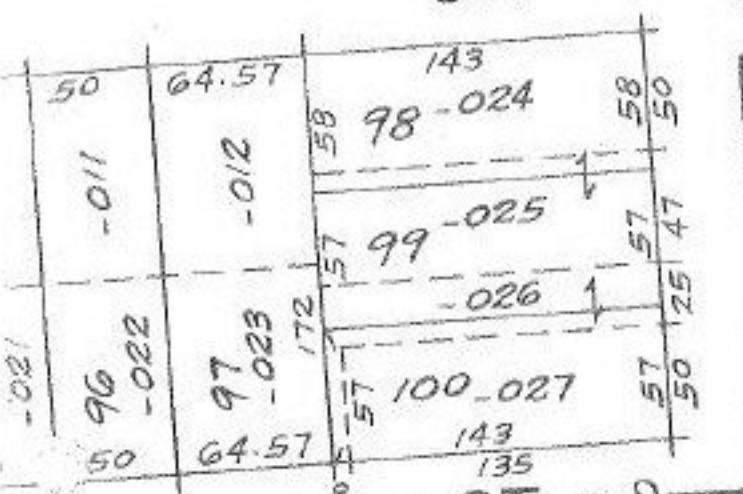

SEE 3-00-098-A

