

NOM
5-26-78

1126 20
11564

#11564

APPROVED	
LORAIN CO.	
MAP DEPT.	
DATE	4/18/78
PAGE	11-00-006-B
BY	T. McNeil
VOID AFTER	11564

5-18-78
2-2


~~008~~

~~46.50A~~

~~030~~

~~45.54A~~

FLYING STUBS

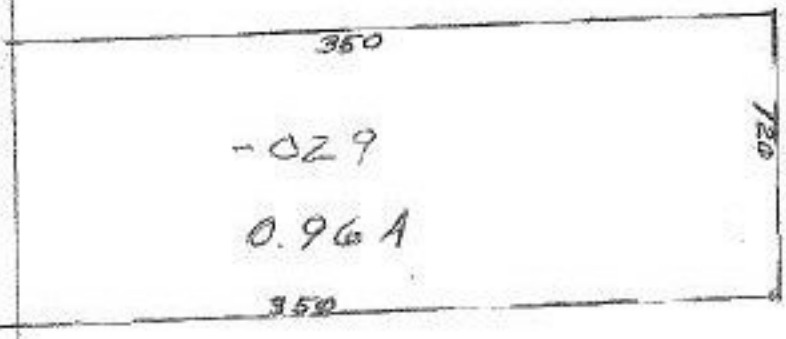

82

