


11576

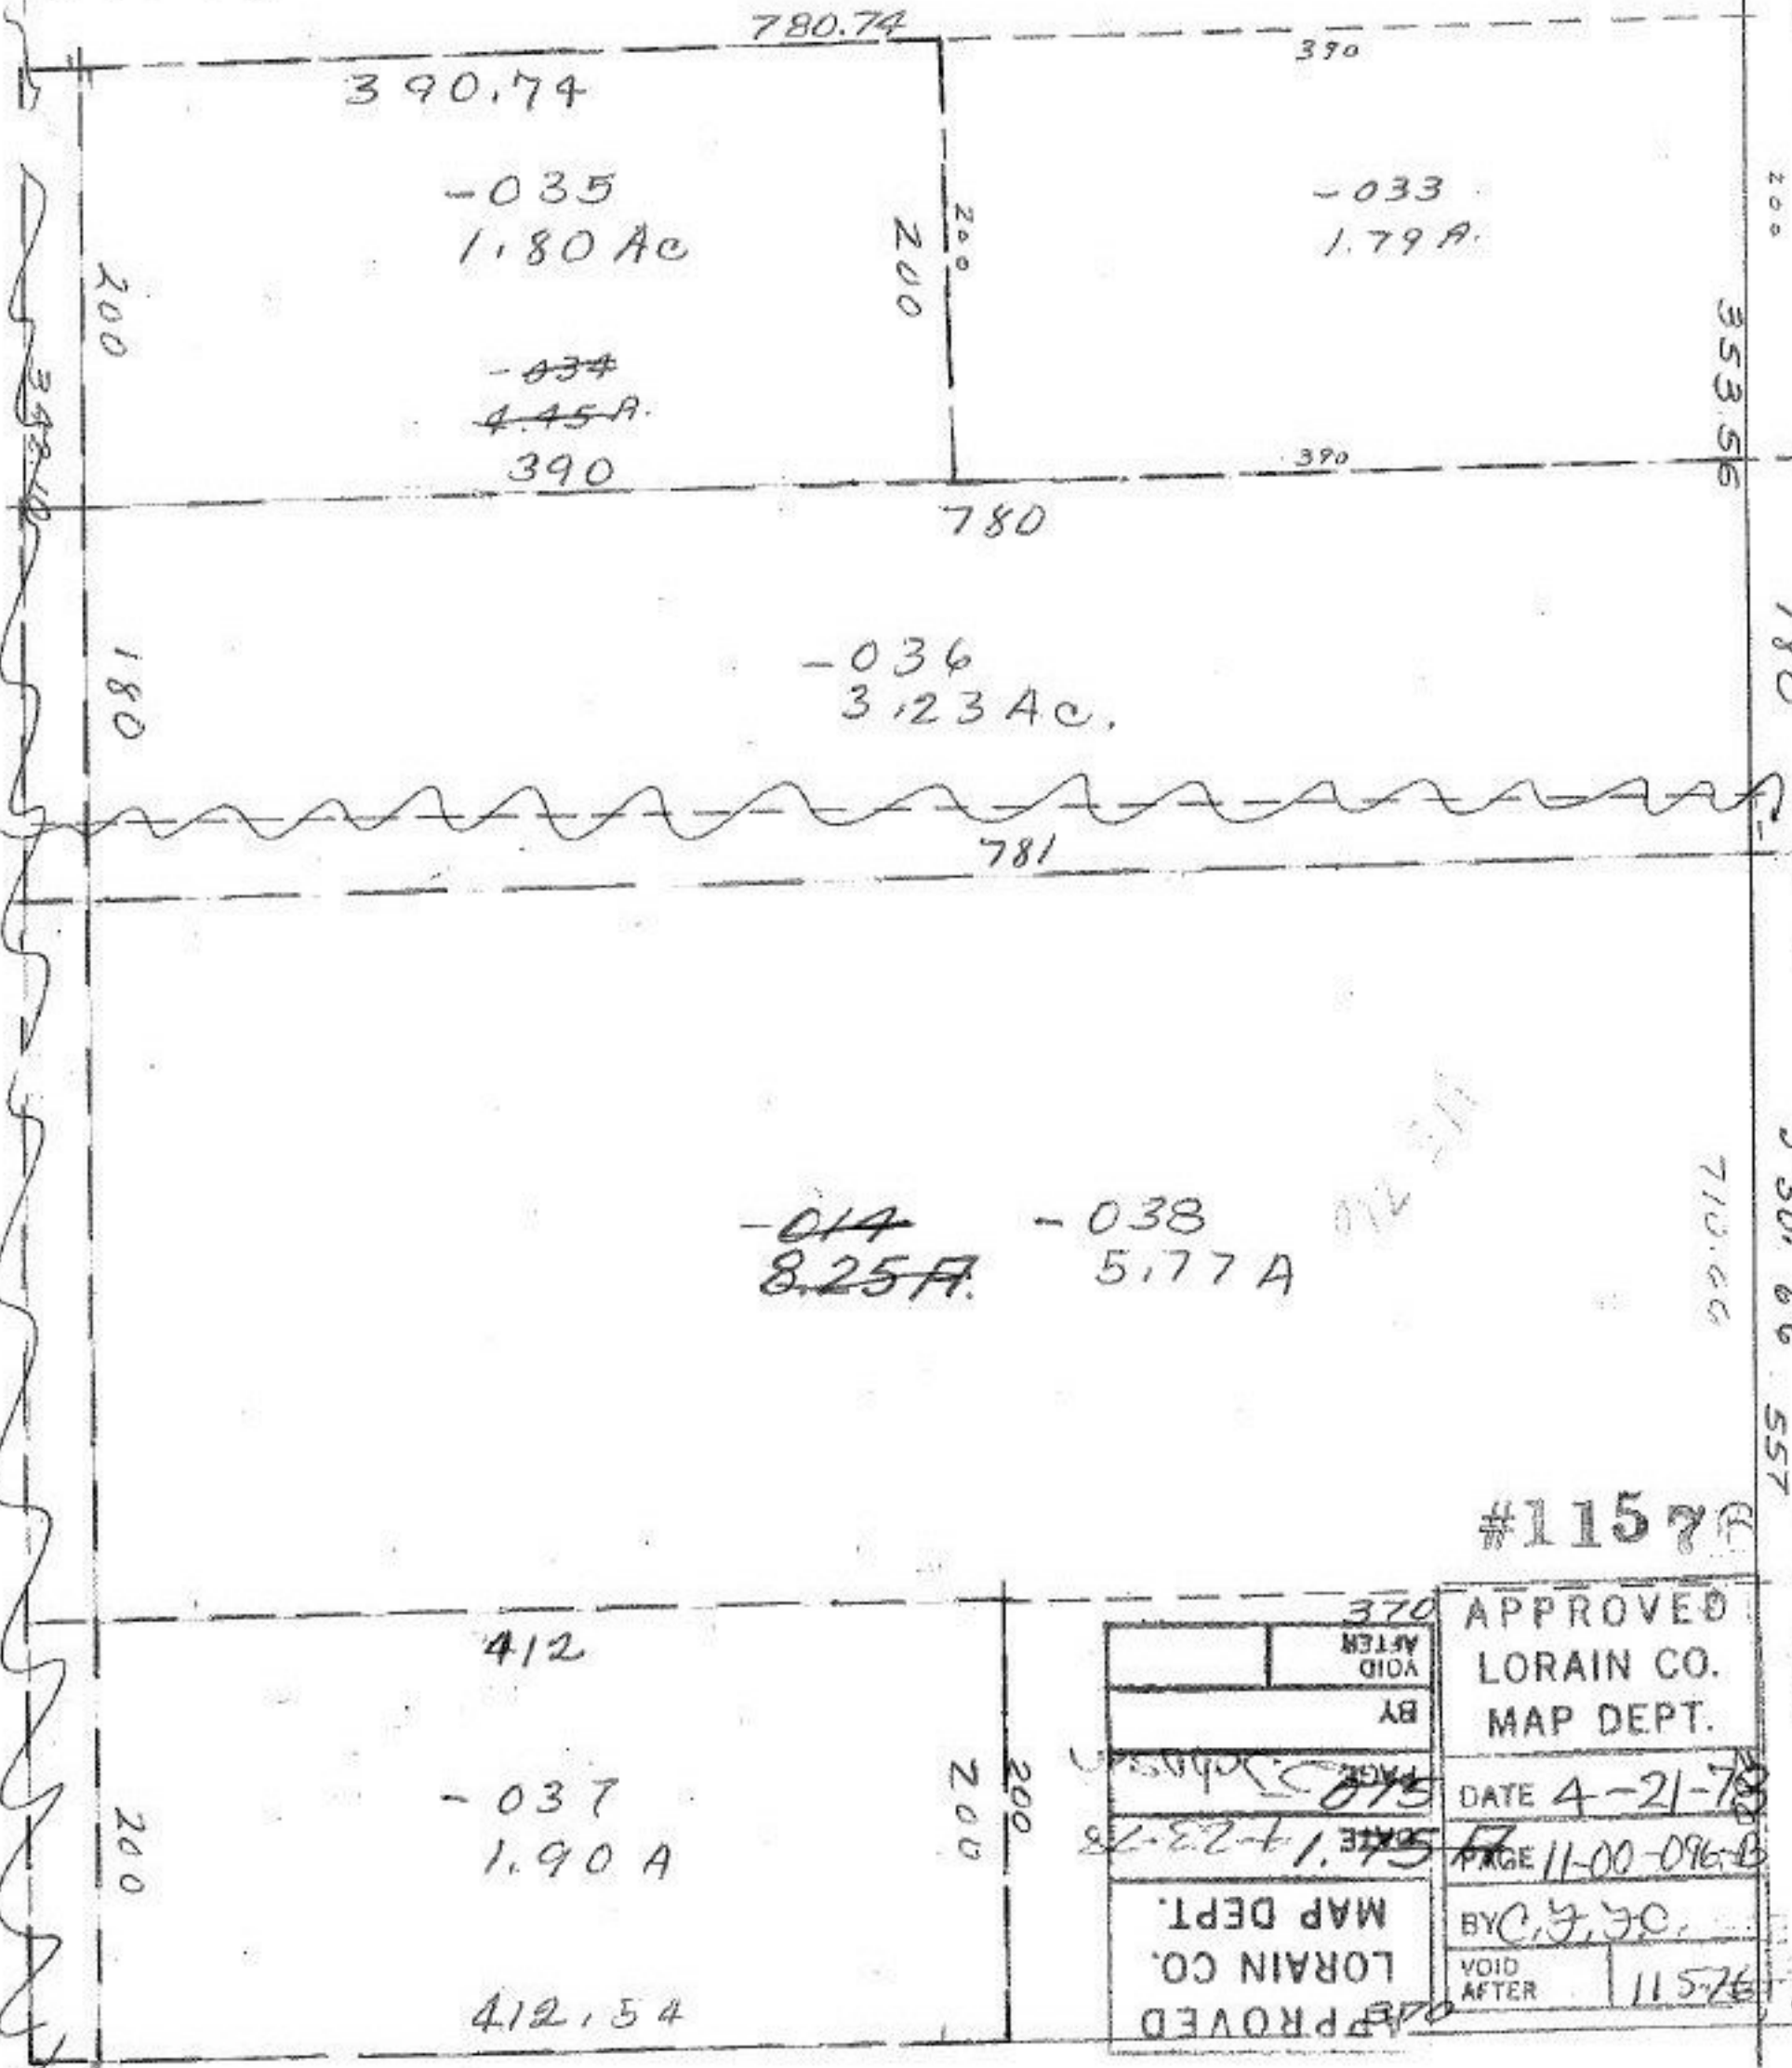

-035
1.80 Ac

-033
1.79 Ac

~~-034~~
~~4.45 Ac~~
390

-036
3.23 Ac

~~-034~~ -038
8.25 Ac 5.77 Ac

412
-037
1.90 Ac

412.54

#11576

APPROVED	VOID AFTER	APPROVED	VOID AFTER
LORAIN CO.	BY	LORAIN CO.	BY C. F. JOHNSON
MAP DEPT.	DATE	MAP DEPT.	DATE 4-21-78
	11-00-096		

11576

#11576