


#11601
NOCTM

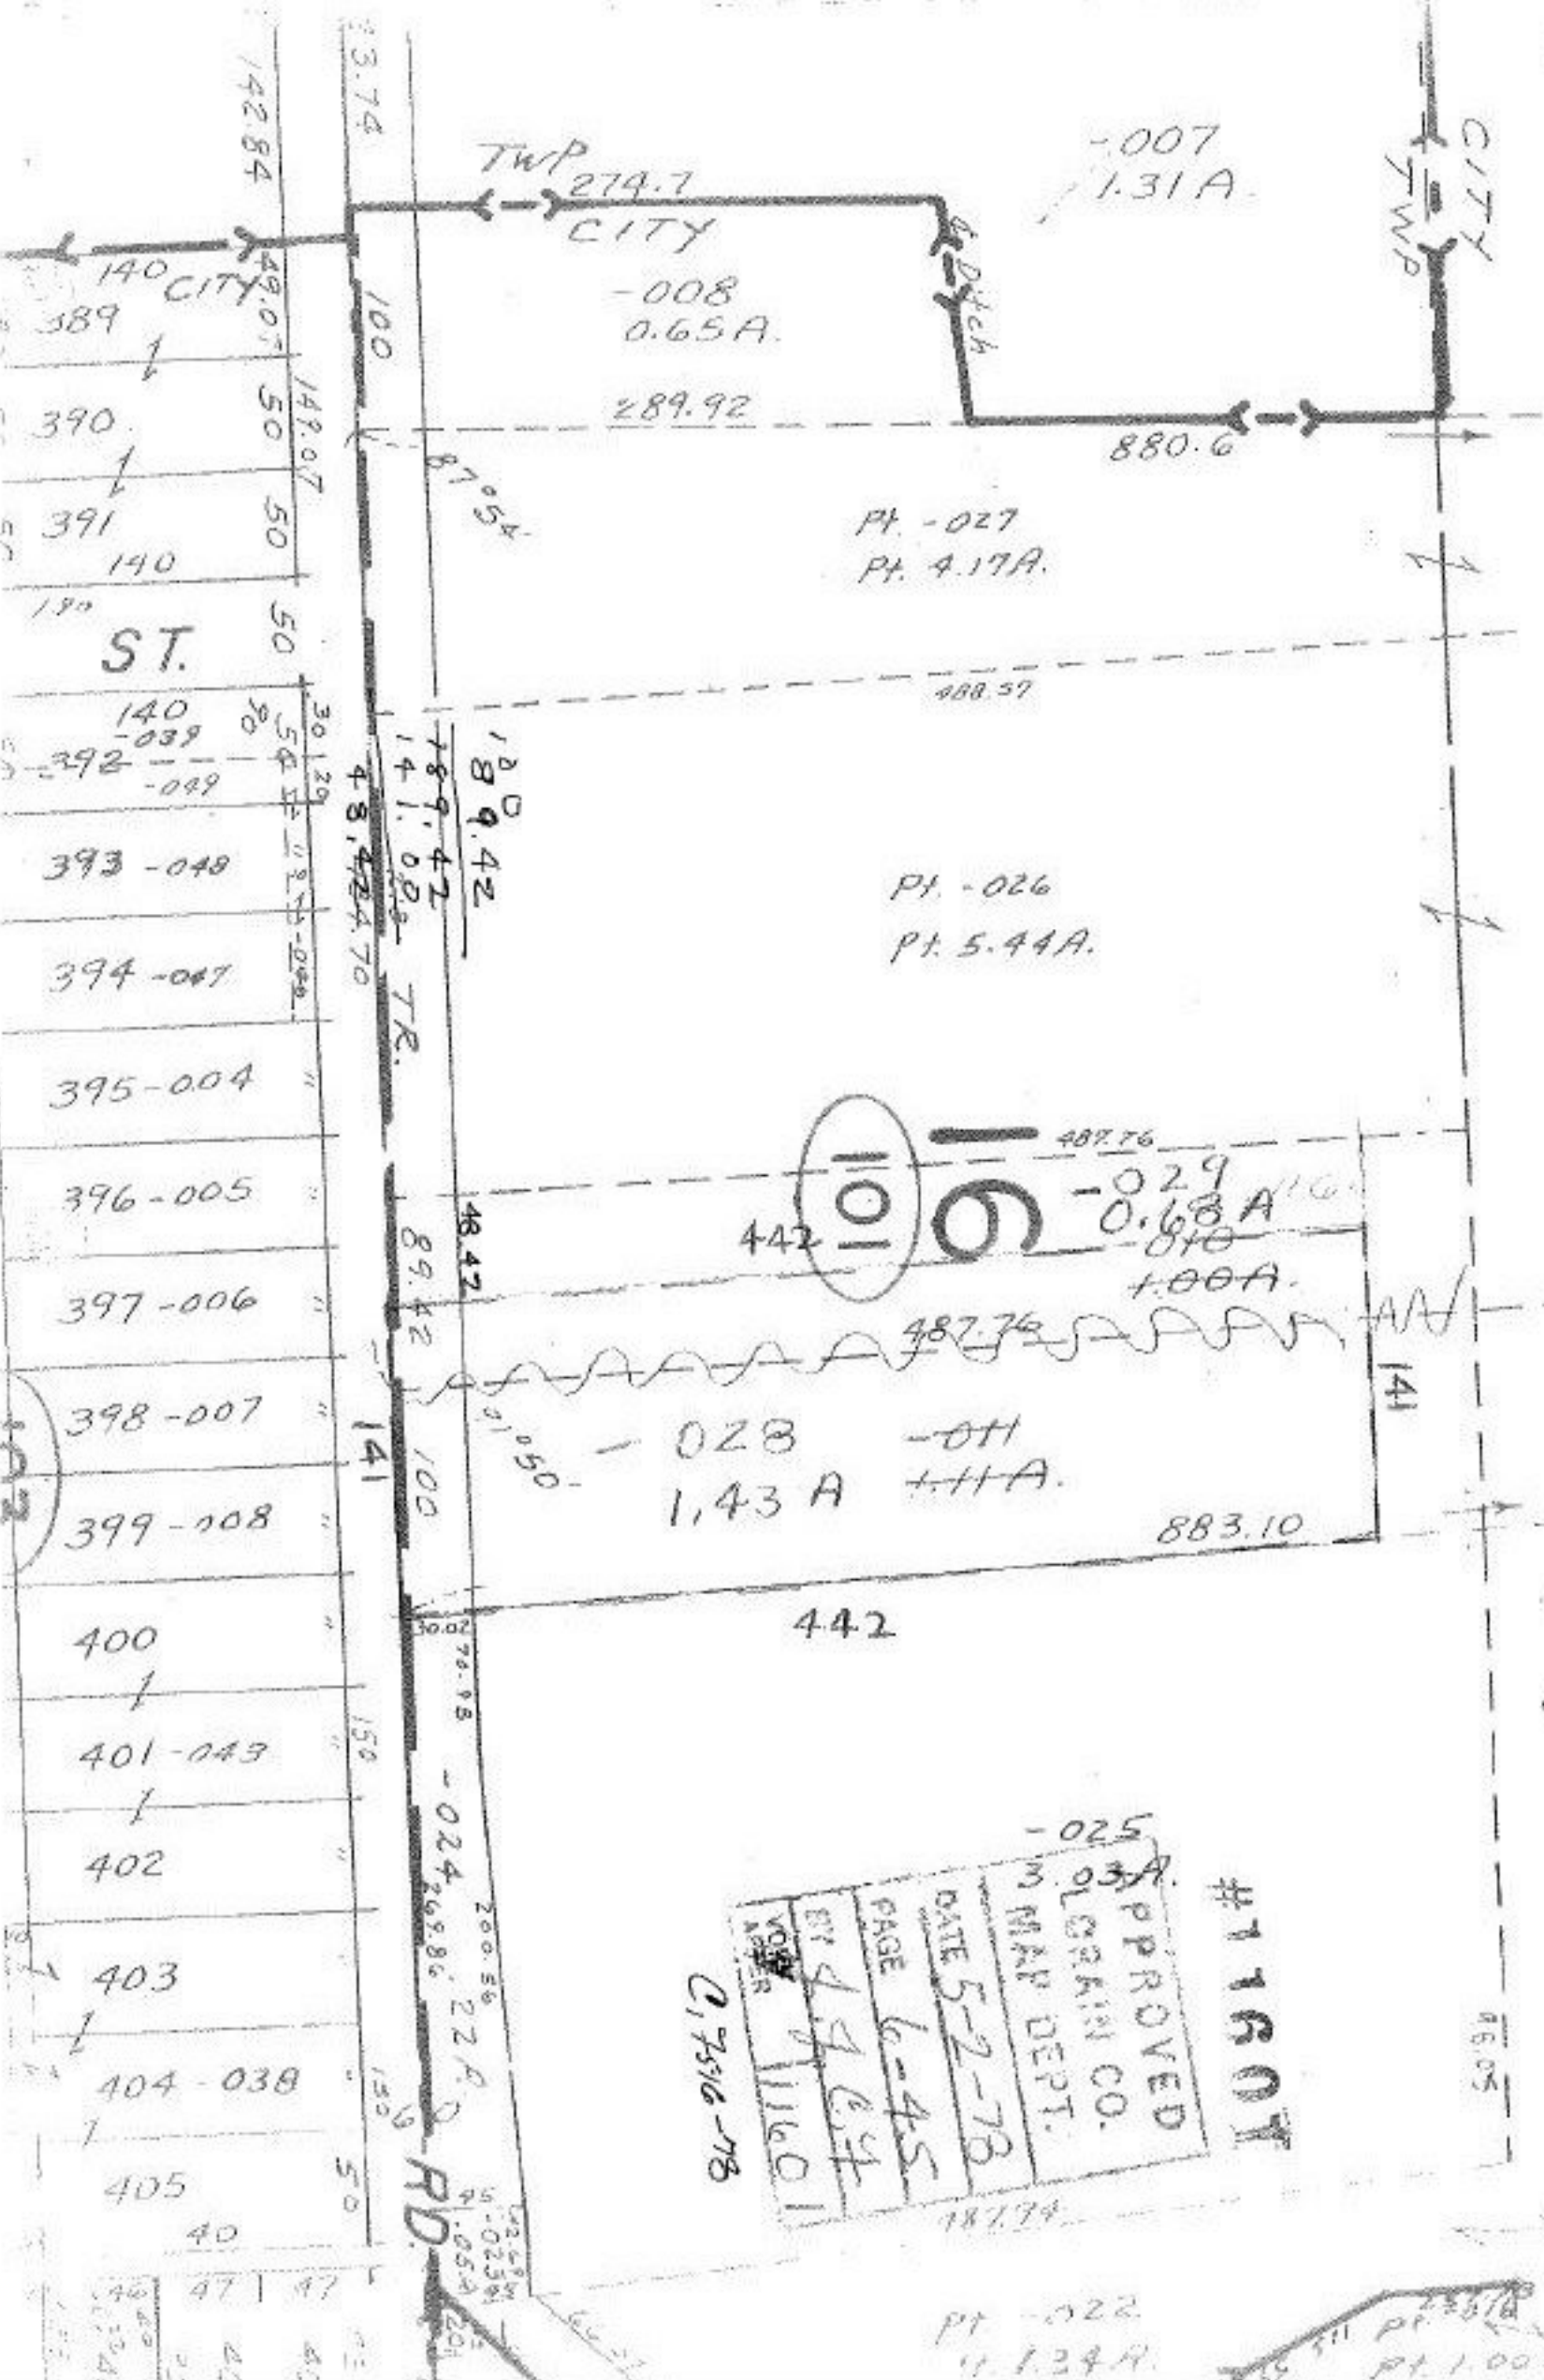

SEE 6-27

APPROVED
 COLGRIFF CO.
 MAP DEPT.
 DATE 5-2-78
 PAGE 6-45
 BY J.E.H.
 VOYER 11601
 APPROVER C.7516-78

#11601

PT. -022
1.13 A.
PT. 1.00 A.