


11612

MOORE

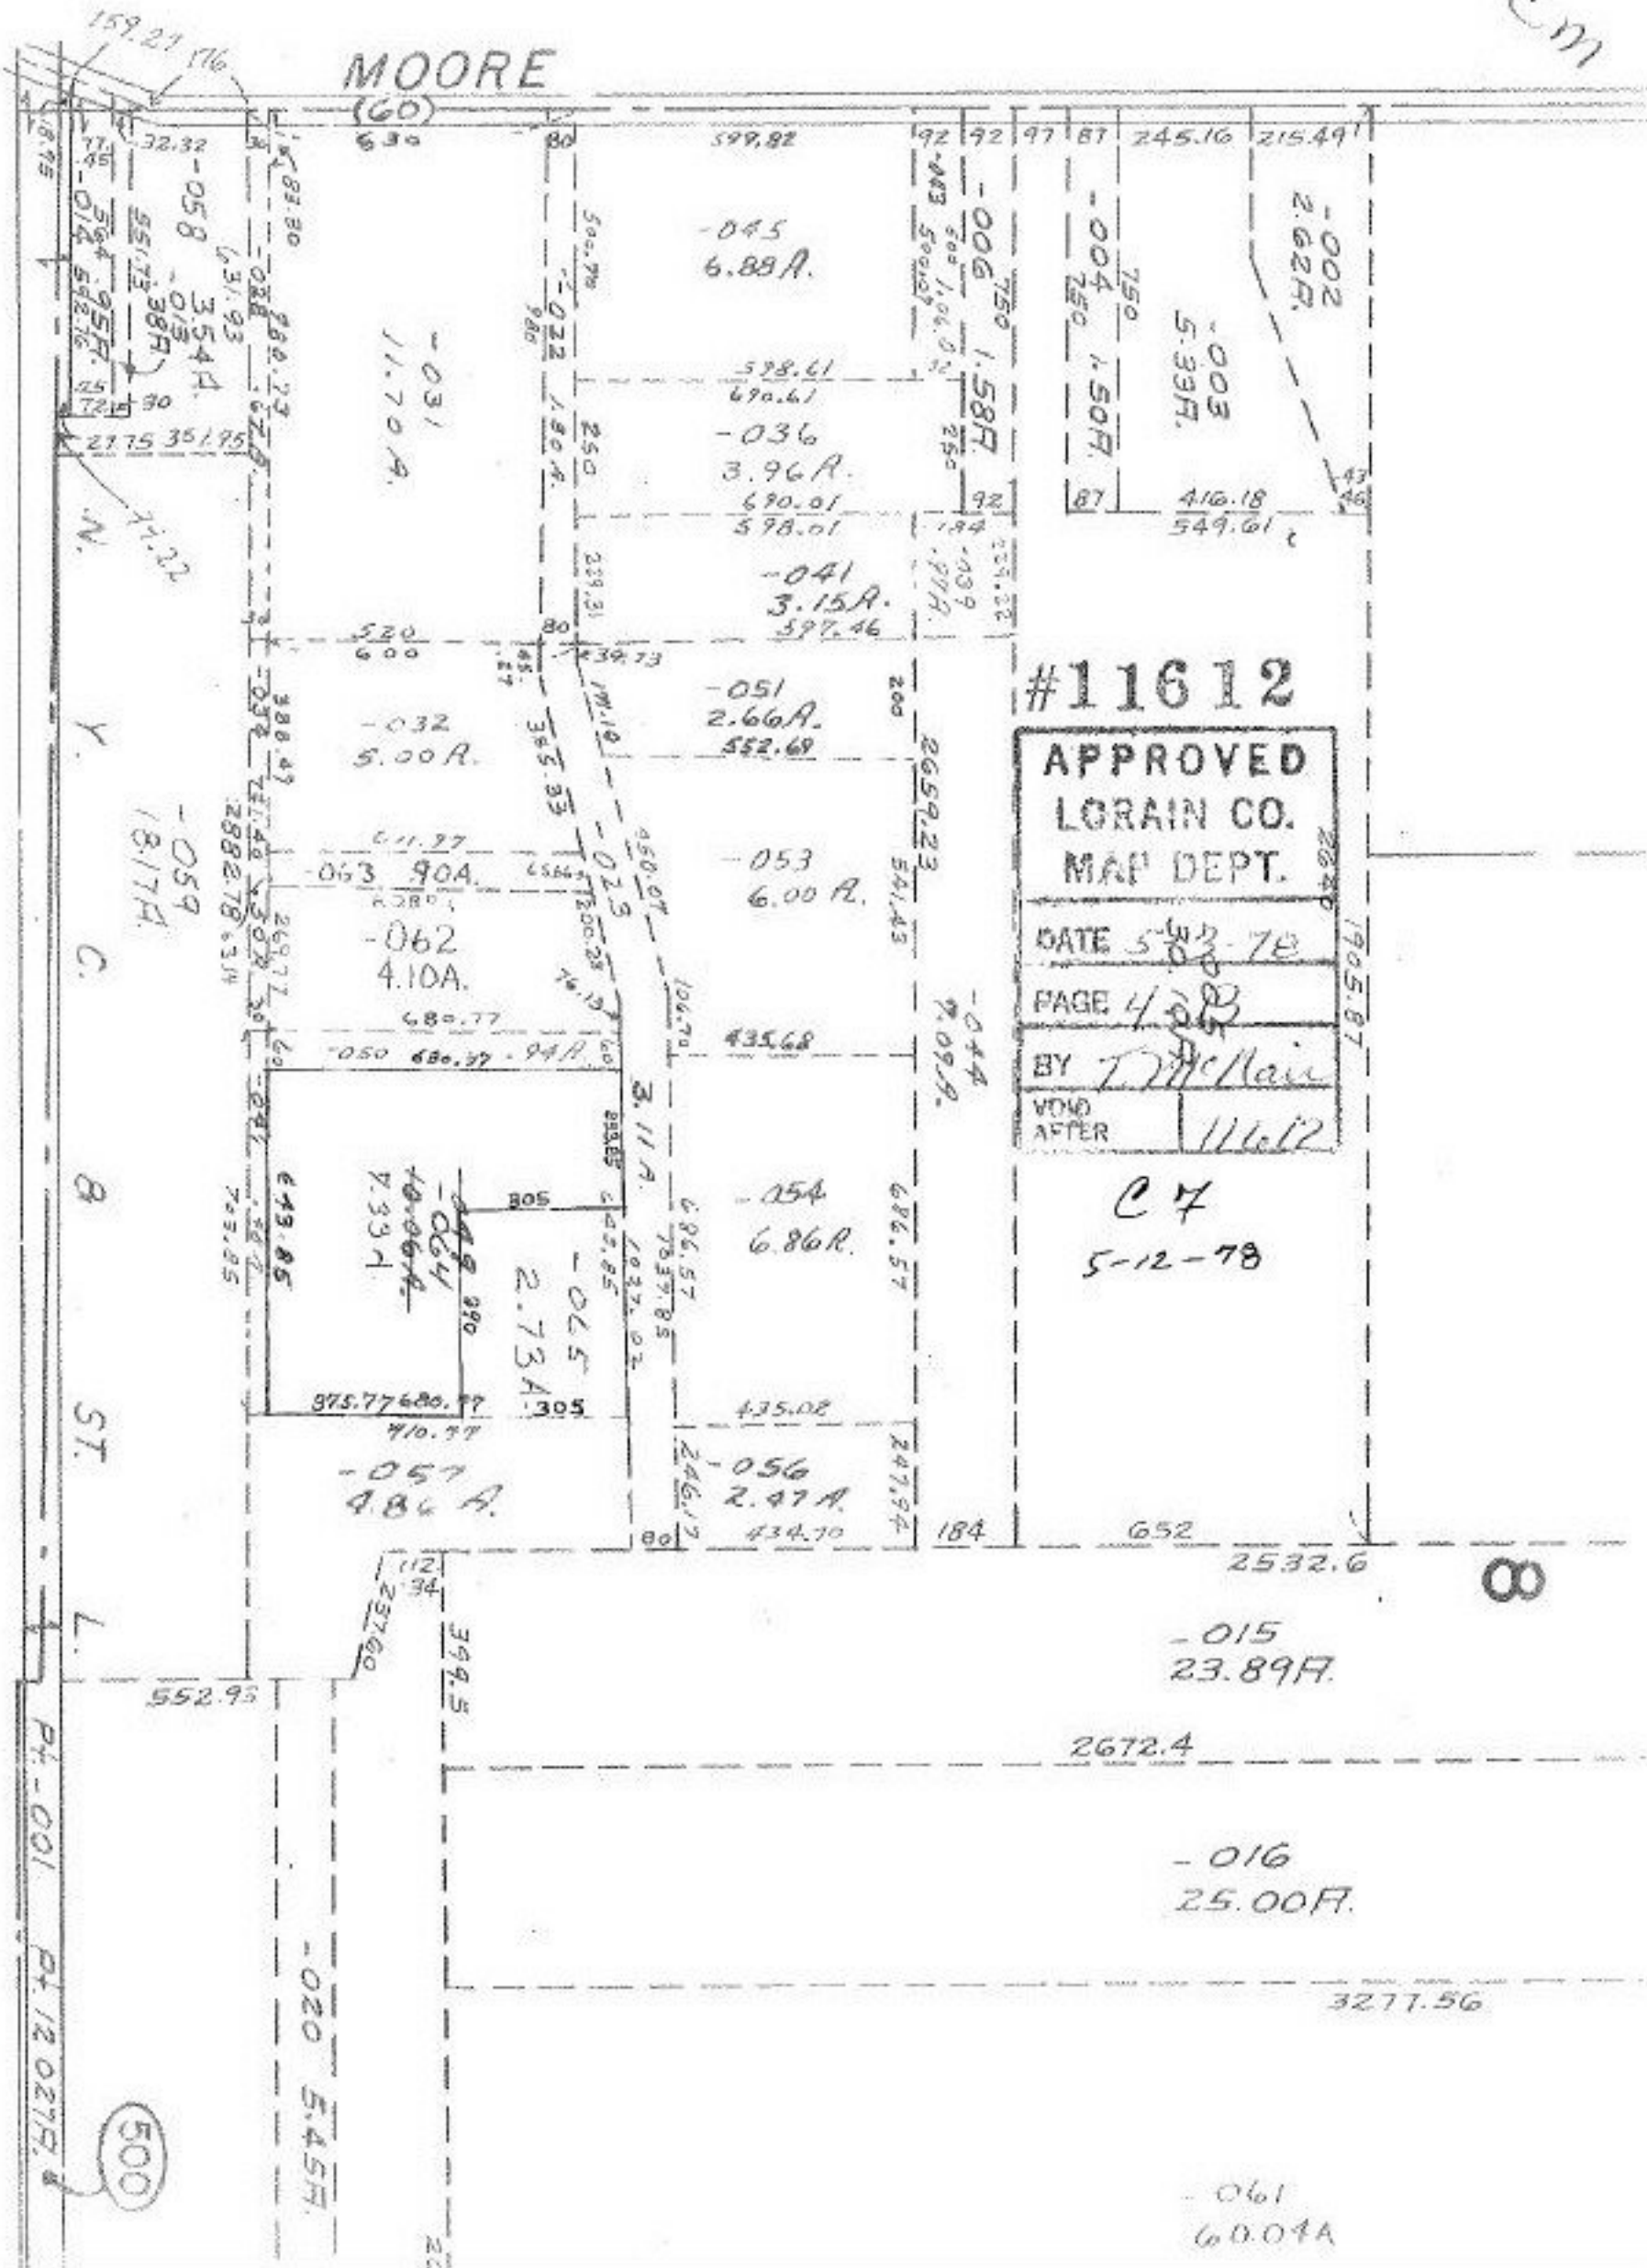

#11612

APPROVED
 LORAIN CO.
 MAP DEPT.
 DATE 5-13-78
 PAGE 4
 BY T. McLean
 VOID AFTER 11612

C7
5-12-78

SEE 4

500

Pt - 001 Pt 120279