


SEE

3-00-007-A

#11613

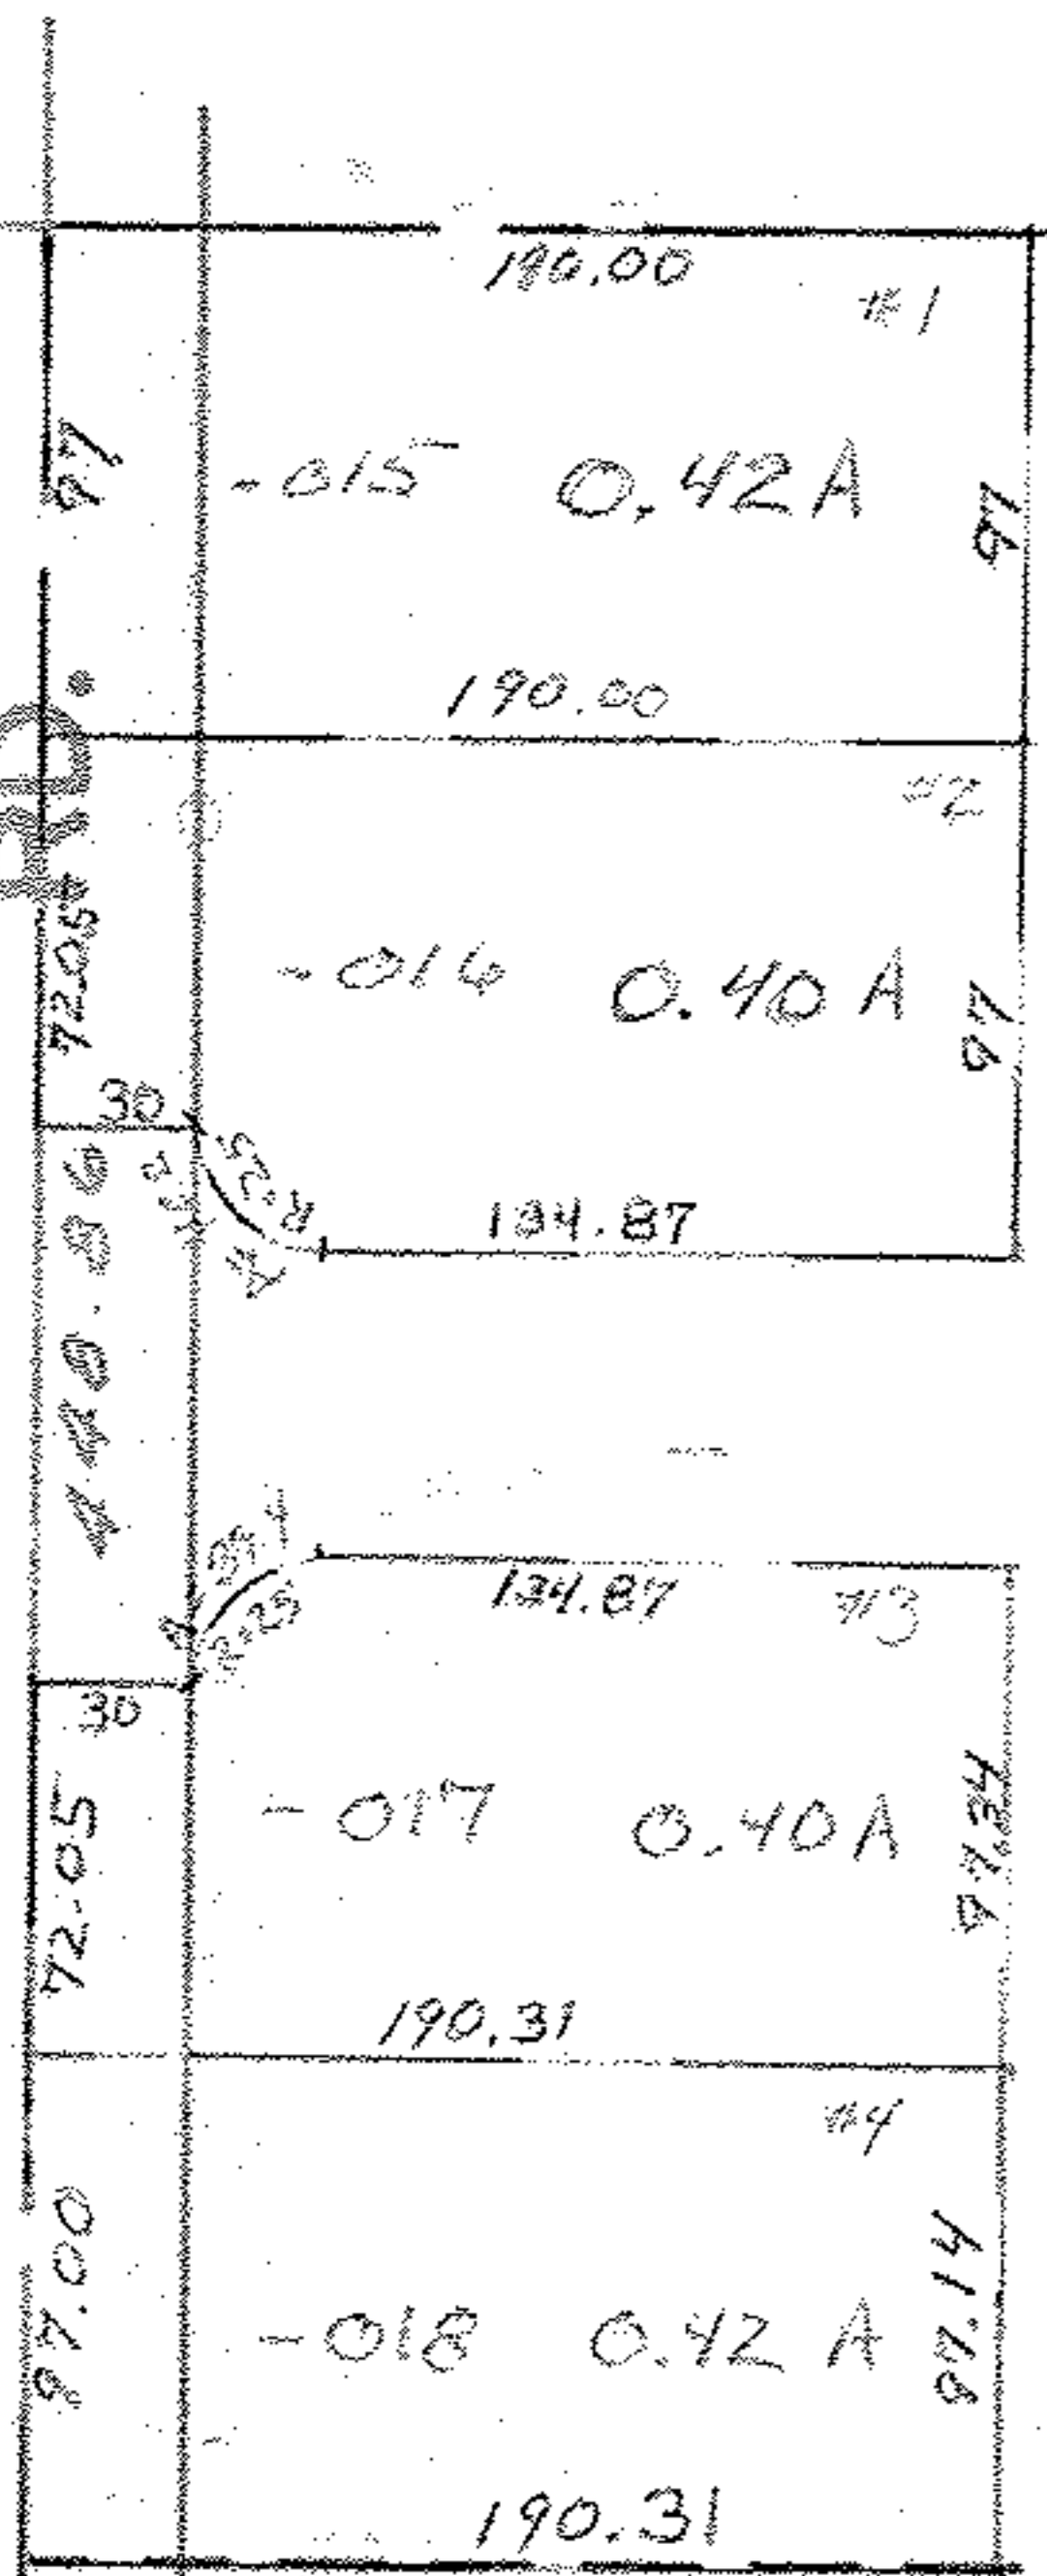

#11613

APPROVED
LORAIN CO.
MAP DEPT.

DATE 5-5-78

PAGE 3-00-006-A

BY T. McAnis

VOID AFTER 11613


C. 7
5-12-78

Pt. -019
23.36A

11613
~~Pt. -001~~
~~Pt. 25.00A.~~

CHANGE
ACREAGE →

3-00-006-B

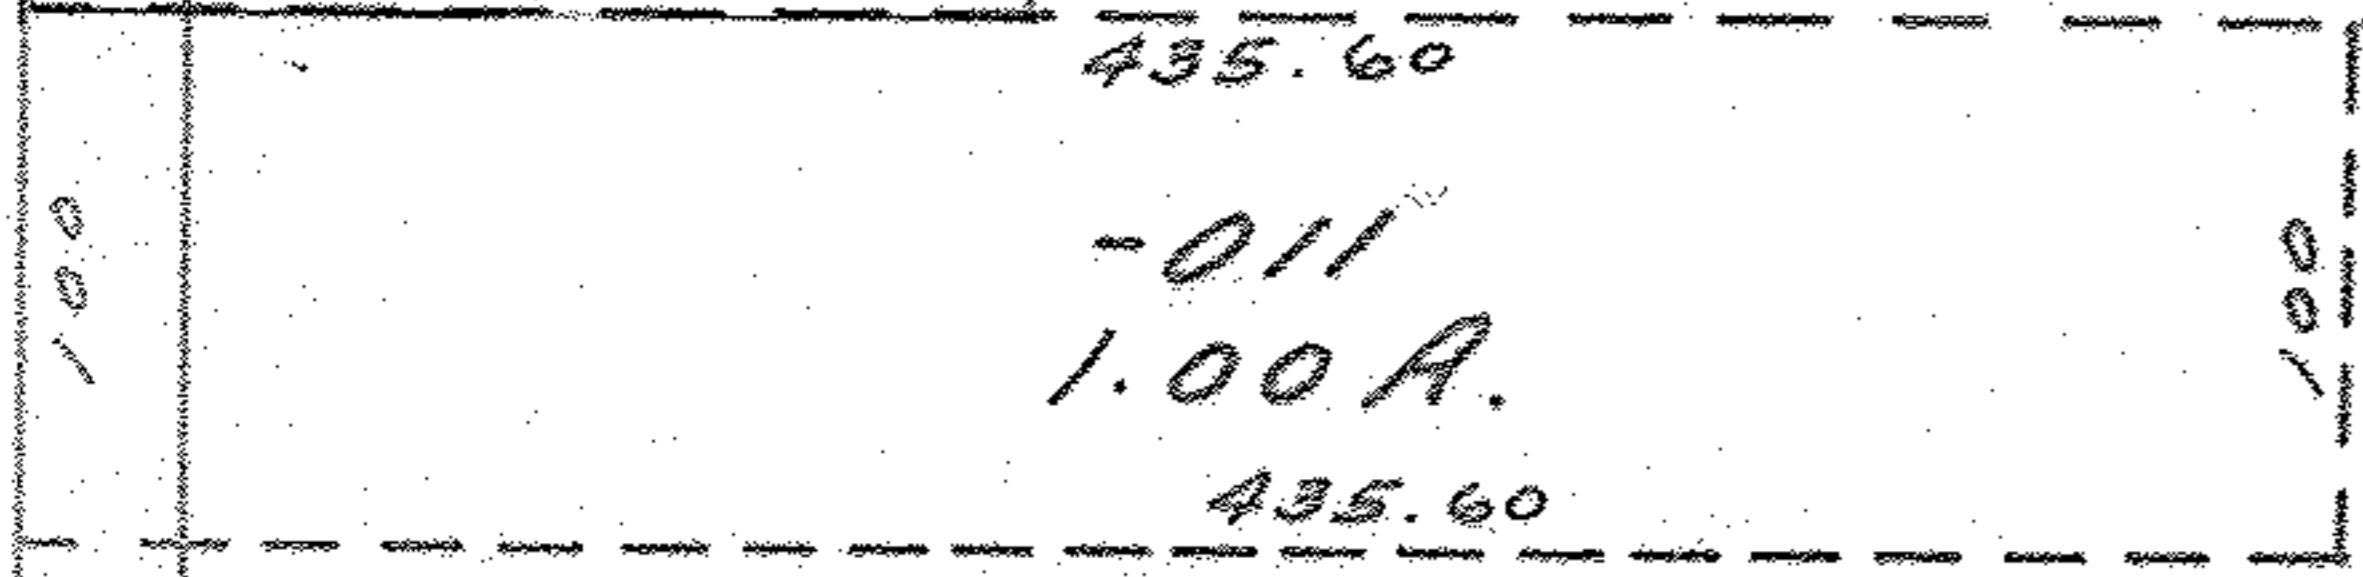

Pt. -012
Pt. 17.70A.

2007.25