


#11620

# T R A

-00  
64.06

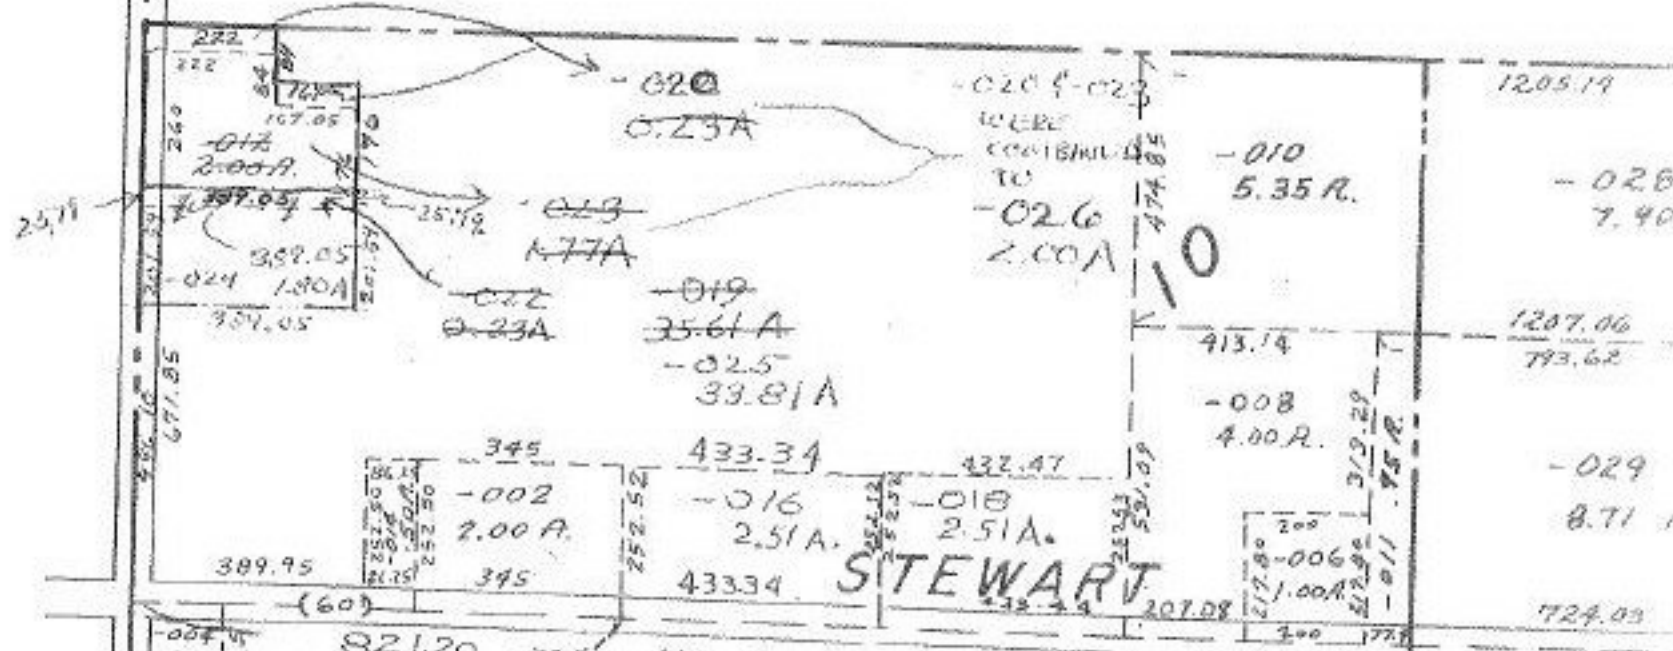

#11620

APPROVED  
LORAIN CO.  
MAP DEPT.

DATE 5-9-78

PAGE 21

BY T. McRain

VOID AFTER 11620

NOTE WHEN YOU ARE DONE YOU WILL HAVE

- 024 1.80 Ac.
- 005
- 025 33.81 Ae
- 026 2.00 Ae
- 52.00 A.

10-20-78

9

-001  
110.00 A. Deed  
106.00 A. Sup.