


#11625

#11625

APPROVED LORAIN CO. MAP DEPT.	
DATE 5-8-78	
PAGE 7-00-011-B	
BY J. Johnson	
VOID AFTER	11625

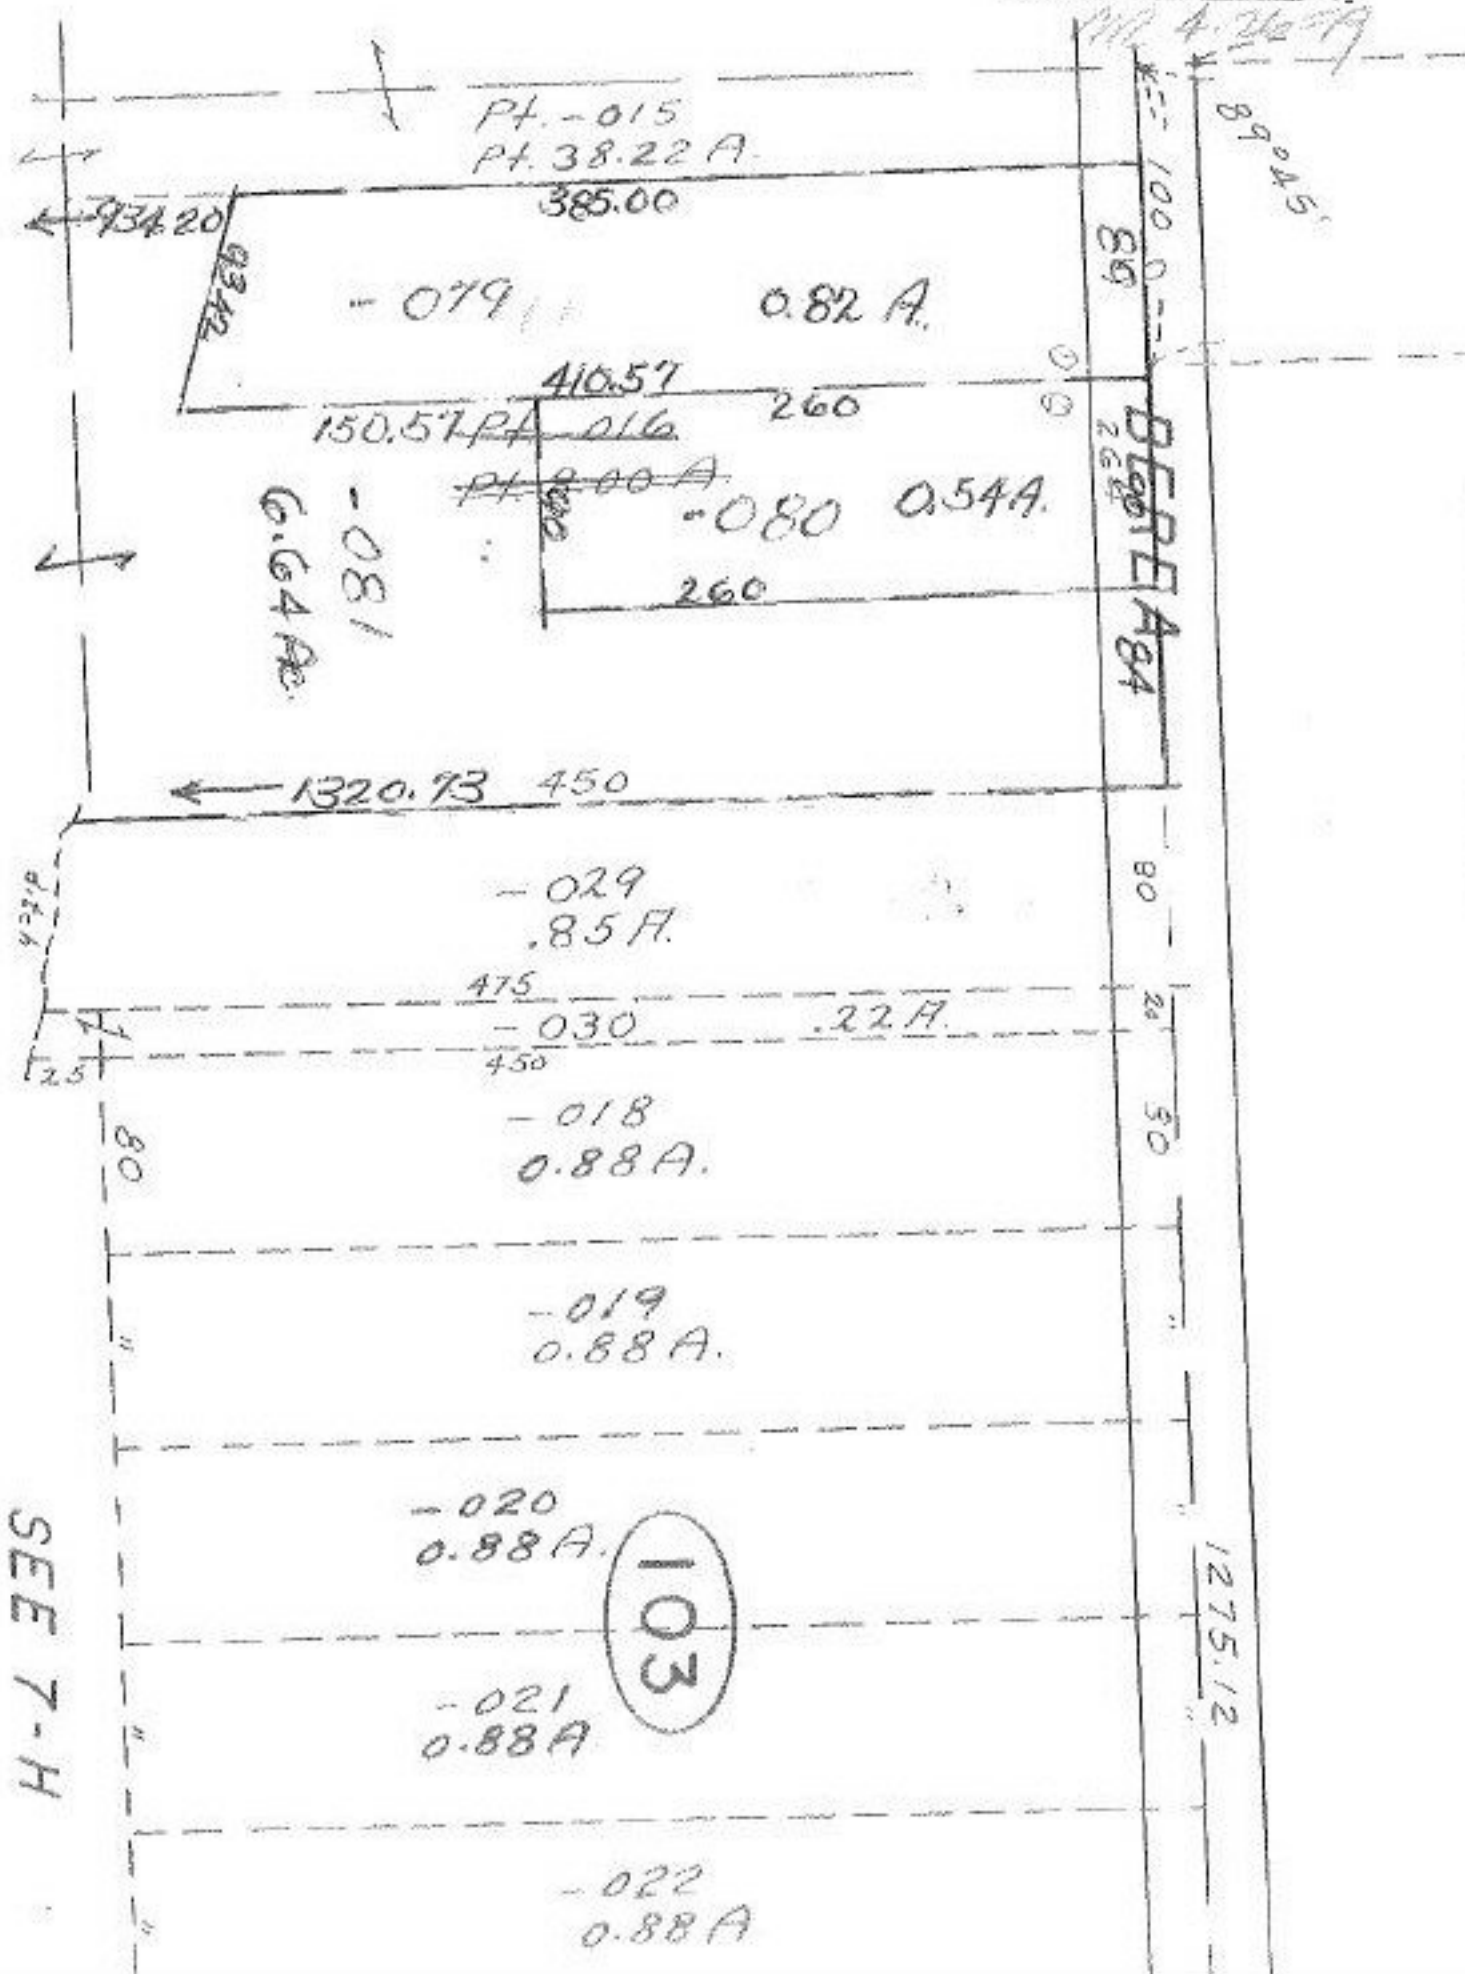

6.84
4.54
2.26
8.00

SEE 7-H

555