
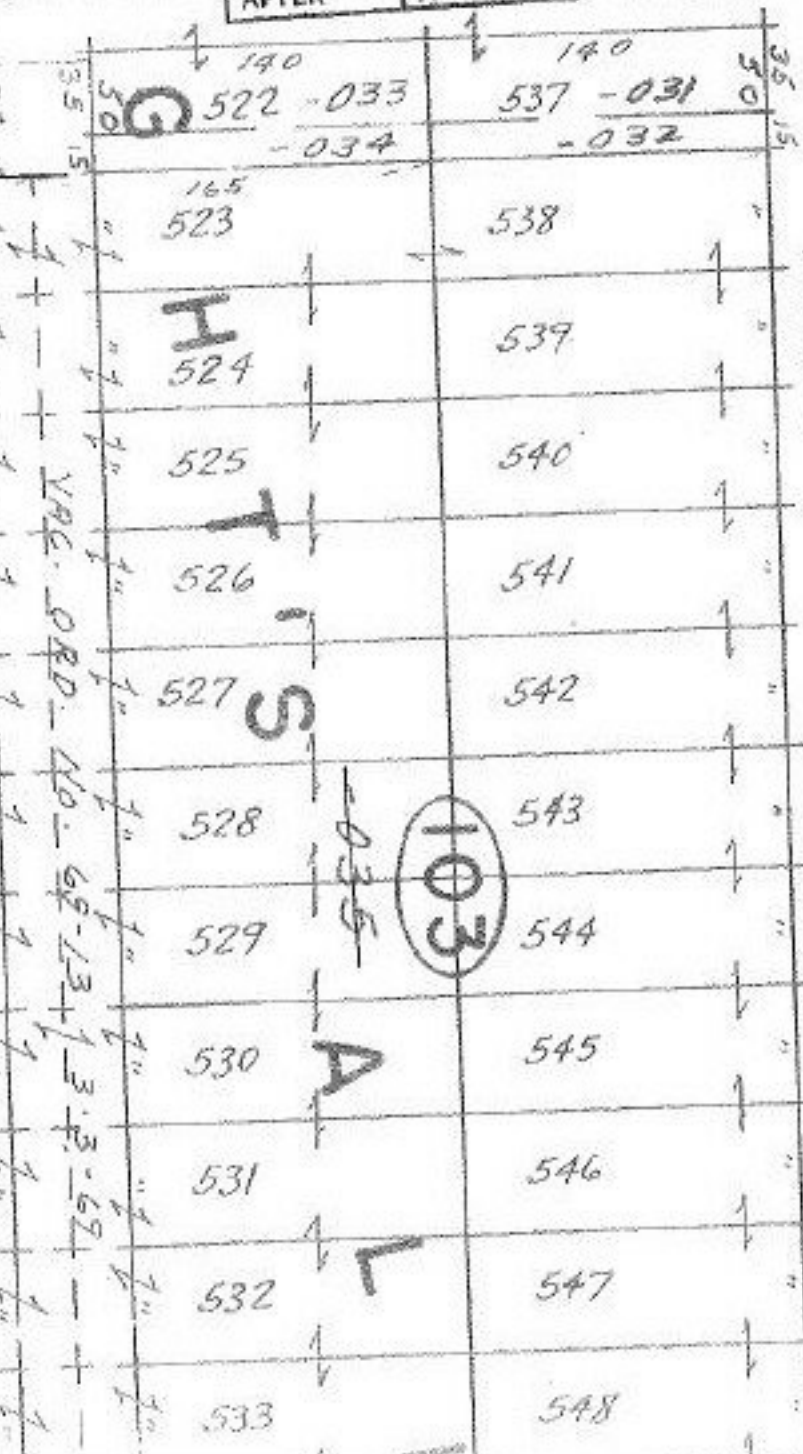


APPROVED  
LORAIN CO.  
MAP DEPT.  
DATE 5-17-78  
PAGE 6-4/0 456  
BY [Signature]  
VOID AFTER [Signature]

MAY 7 1978  
ST.

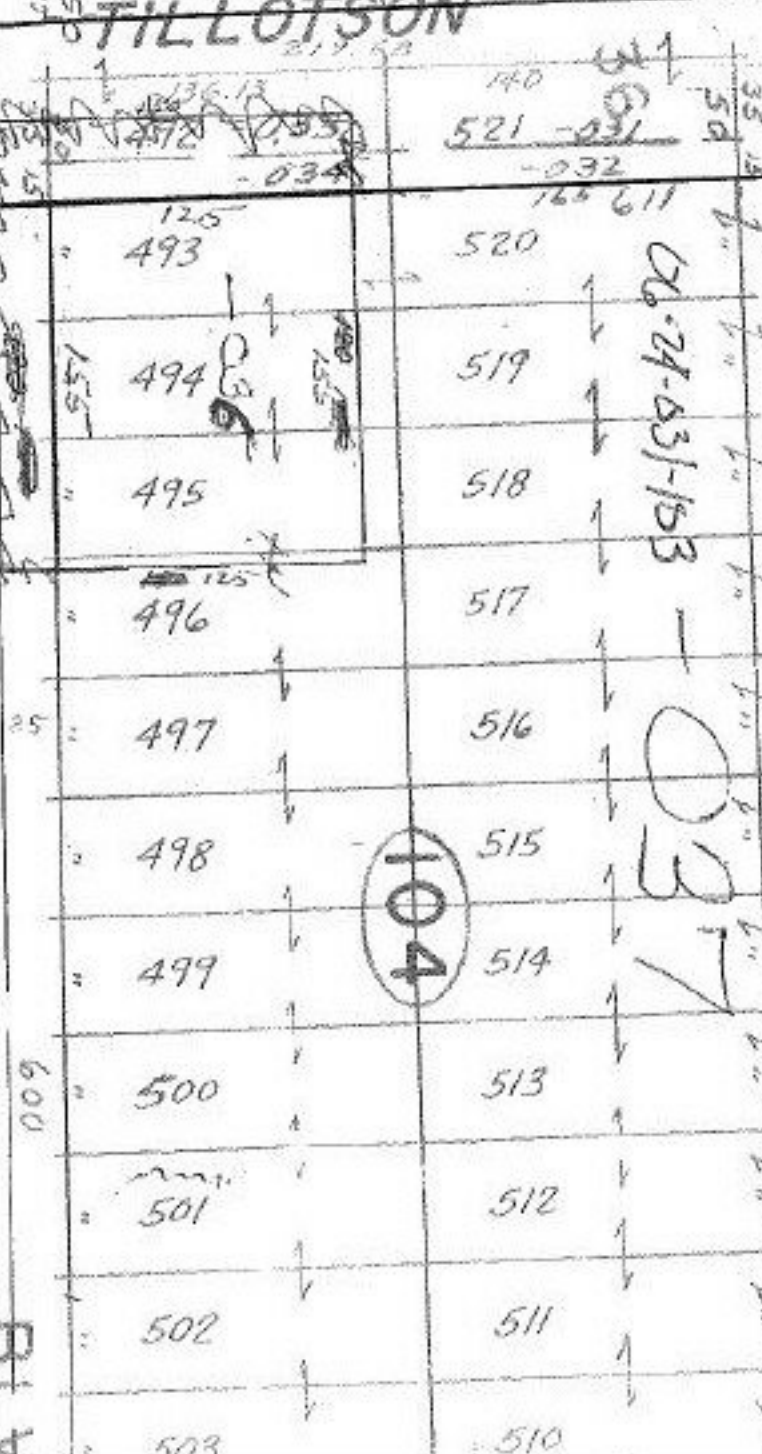

31

TILLOTSON

06-24-531-153 - 037

VAC. ORD. NO. 69-13-13-3-3-69

BLV

TRACT

NEED ONE COPY FOR BOOK

448.4  
175  
20.87  
107.2  
1.65  
148.50  
60  
40  
100  
98.67

70.4

600