

VINSBURG

502.90

150

400
-003
1.38A.
400

#11634

APPROVED
LORAIN CO.
MAP DEPT.

DATE 5-10-78

PAGE 11-E.N. Part

BY J. Johnson

VOID AFTER 11634

734.75
715.70
589.0

MAR 21 1979

-036
78.10A

85


996-B

3584.89

-001

41.08A

3597.19

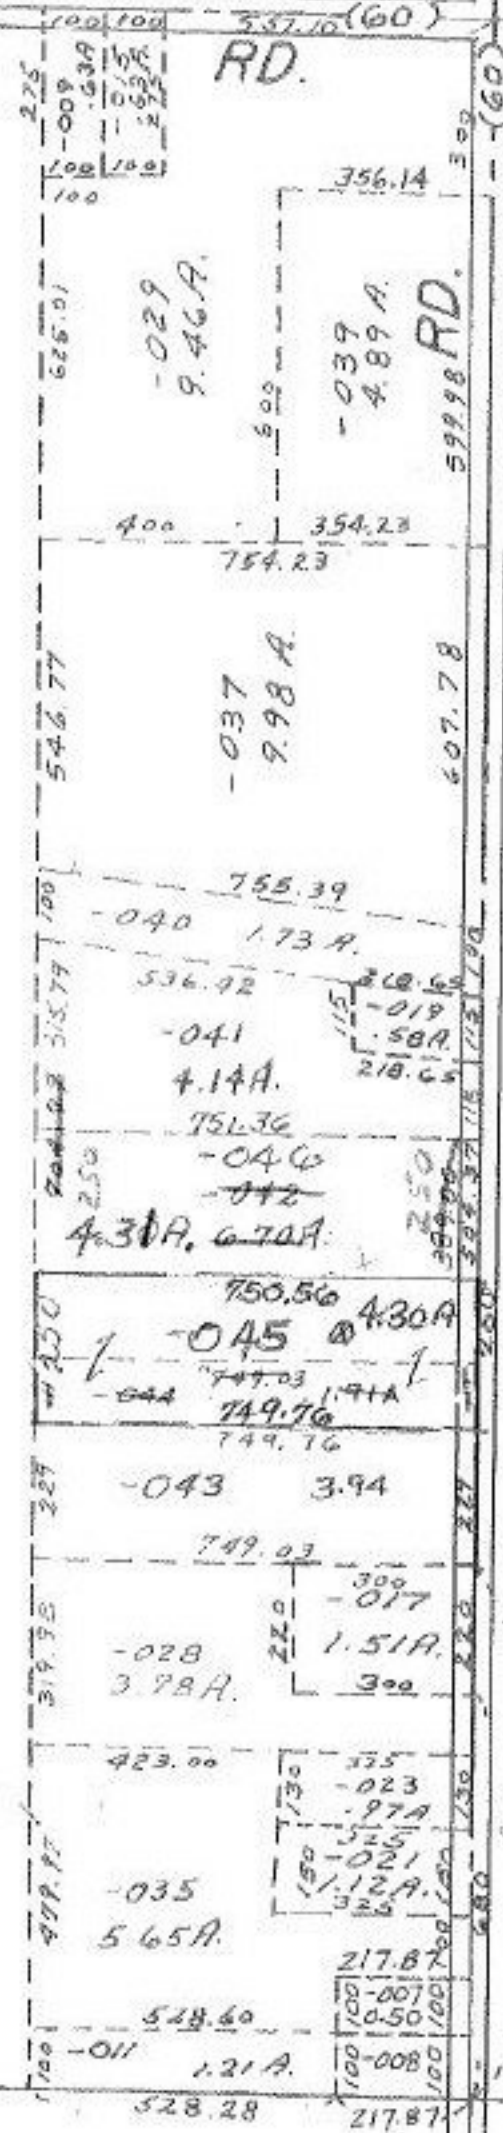

82

500