


#11644

APPROVED LORAIN CO. MAP DEPT.	055
DATE 5-10-78	4.30 A. cal.
PAGE 15-00-046-A	MAR 9 1979
BY <i>Rolland</i>	
VOID AFTER	

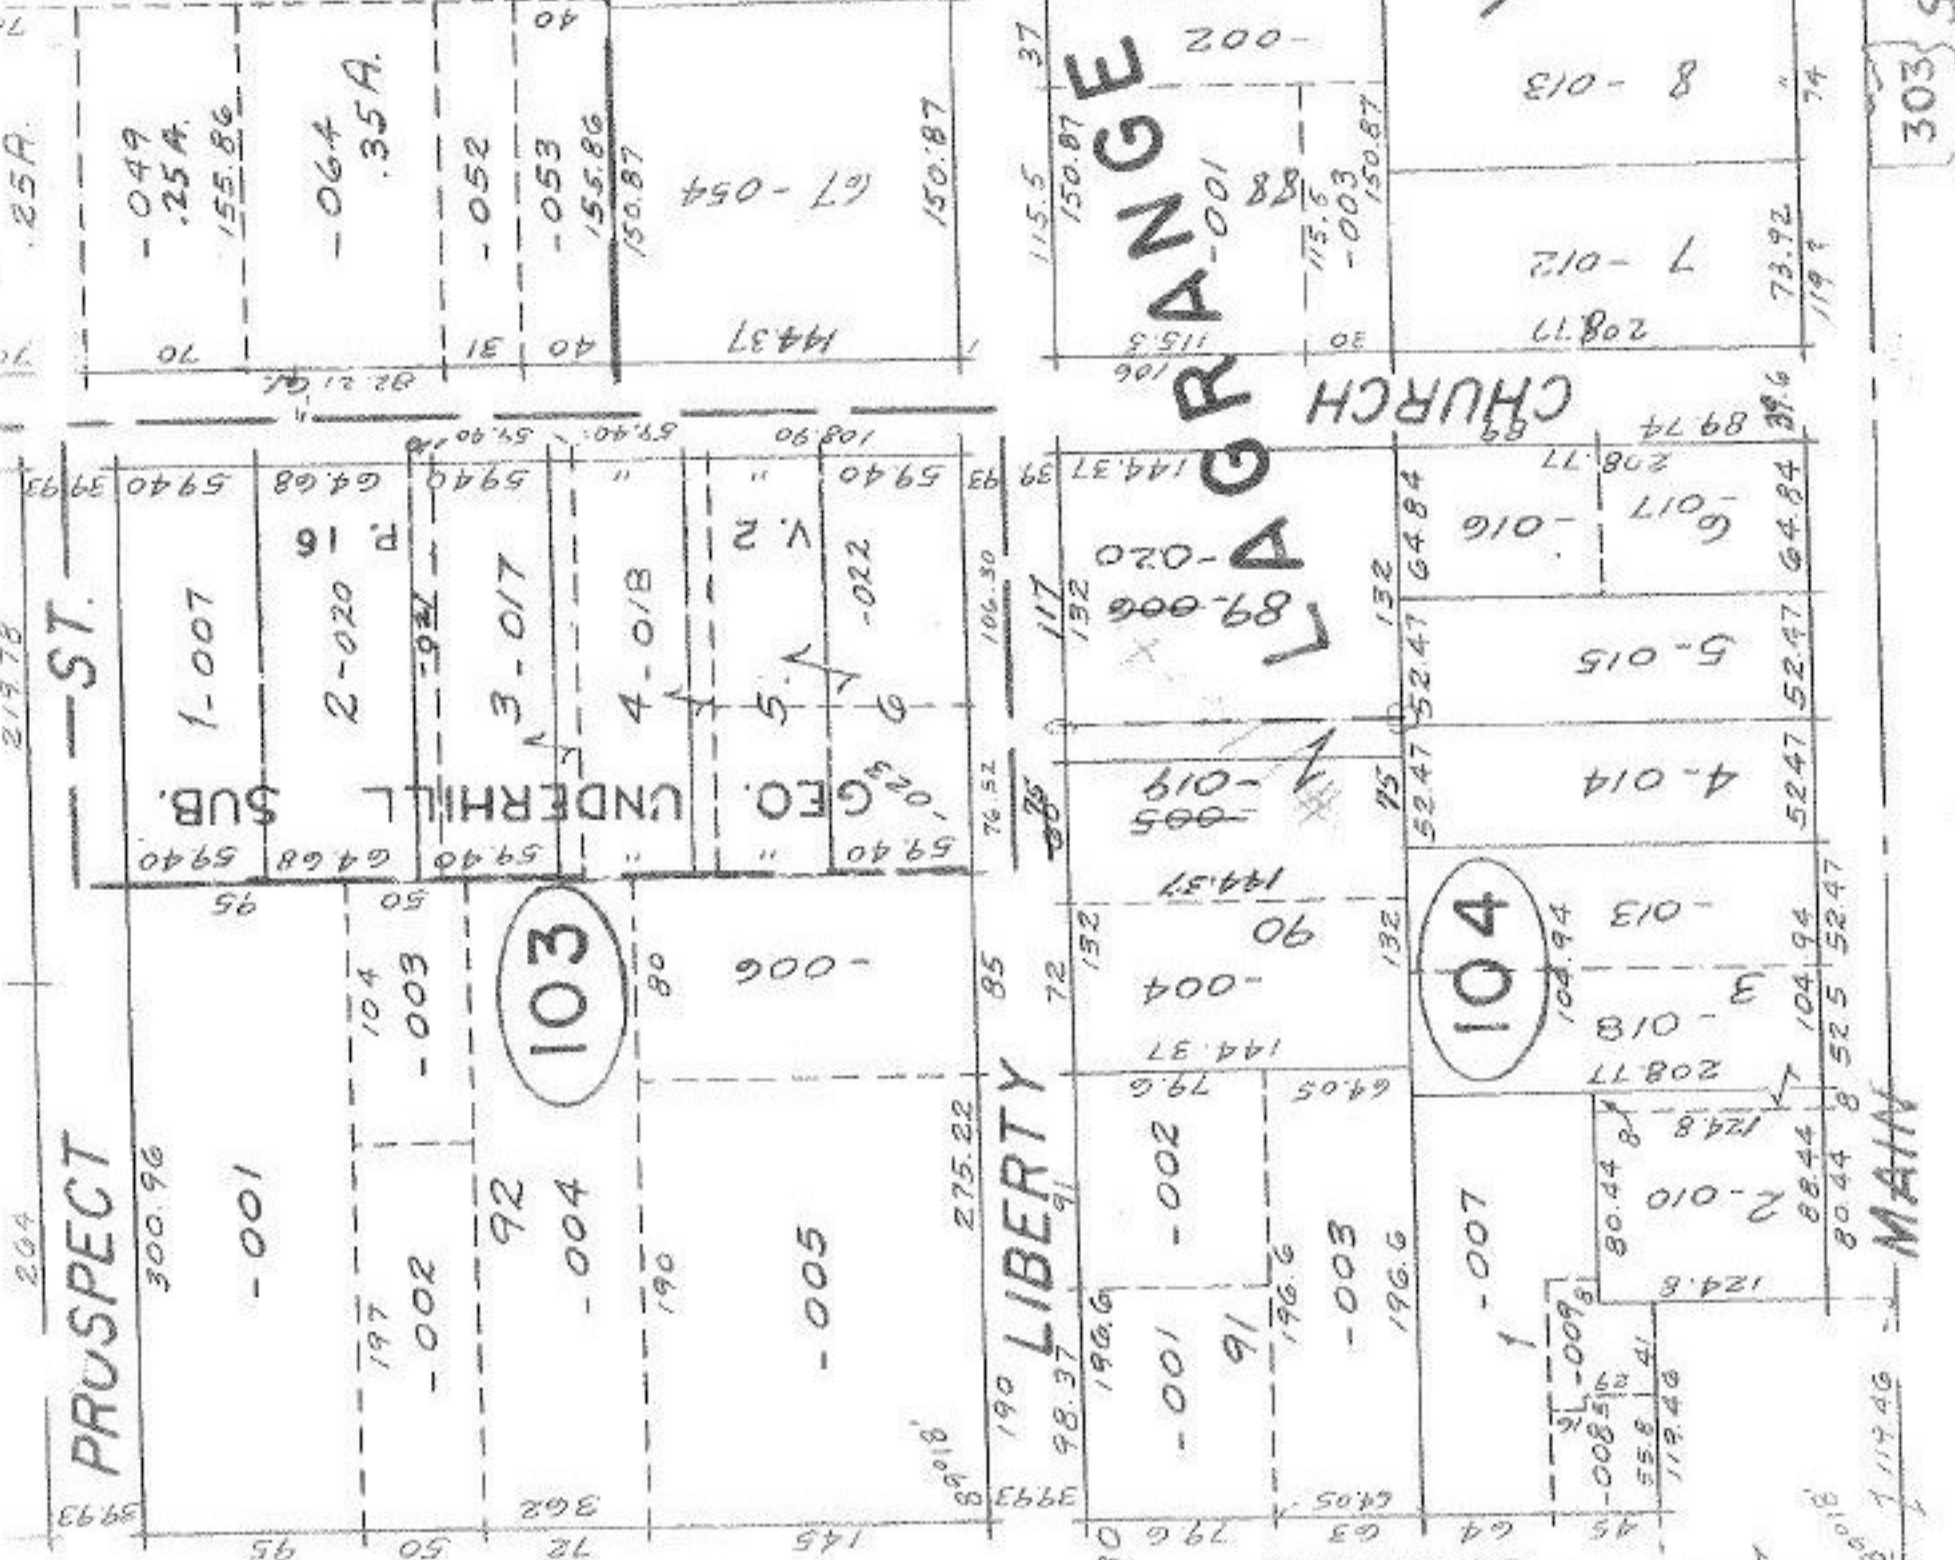

303 SEE 15-00-055-A