


11649

SEE  
Survey  
Deed

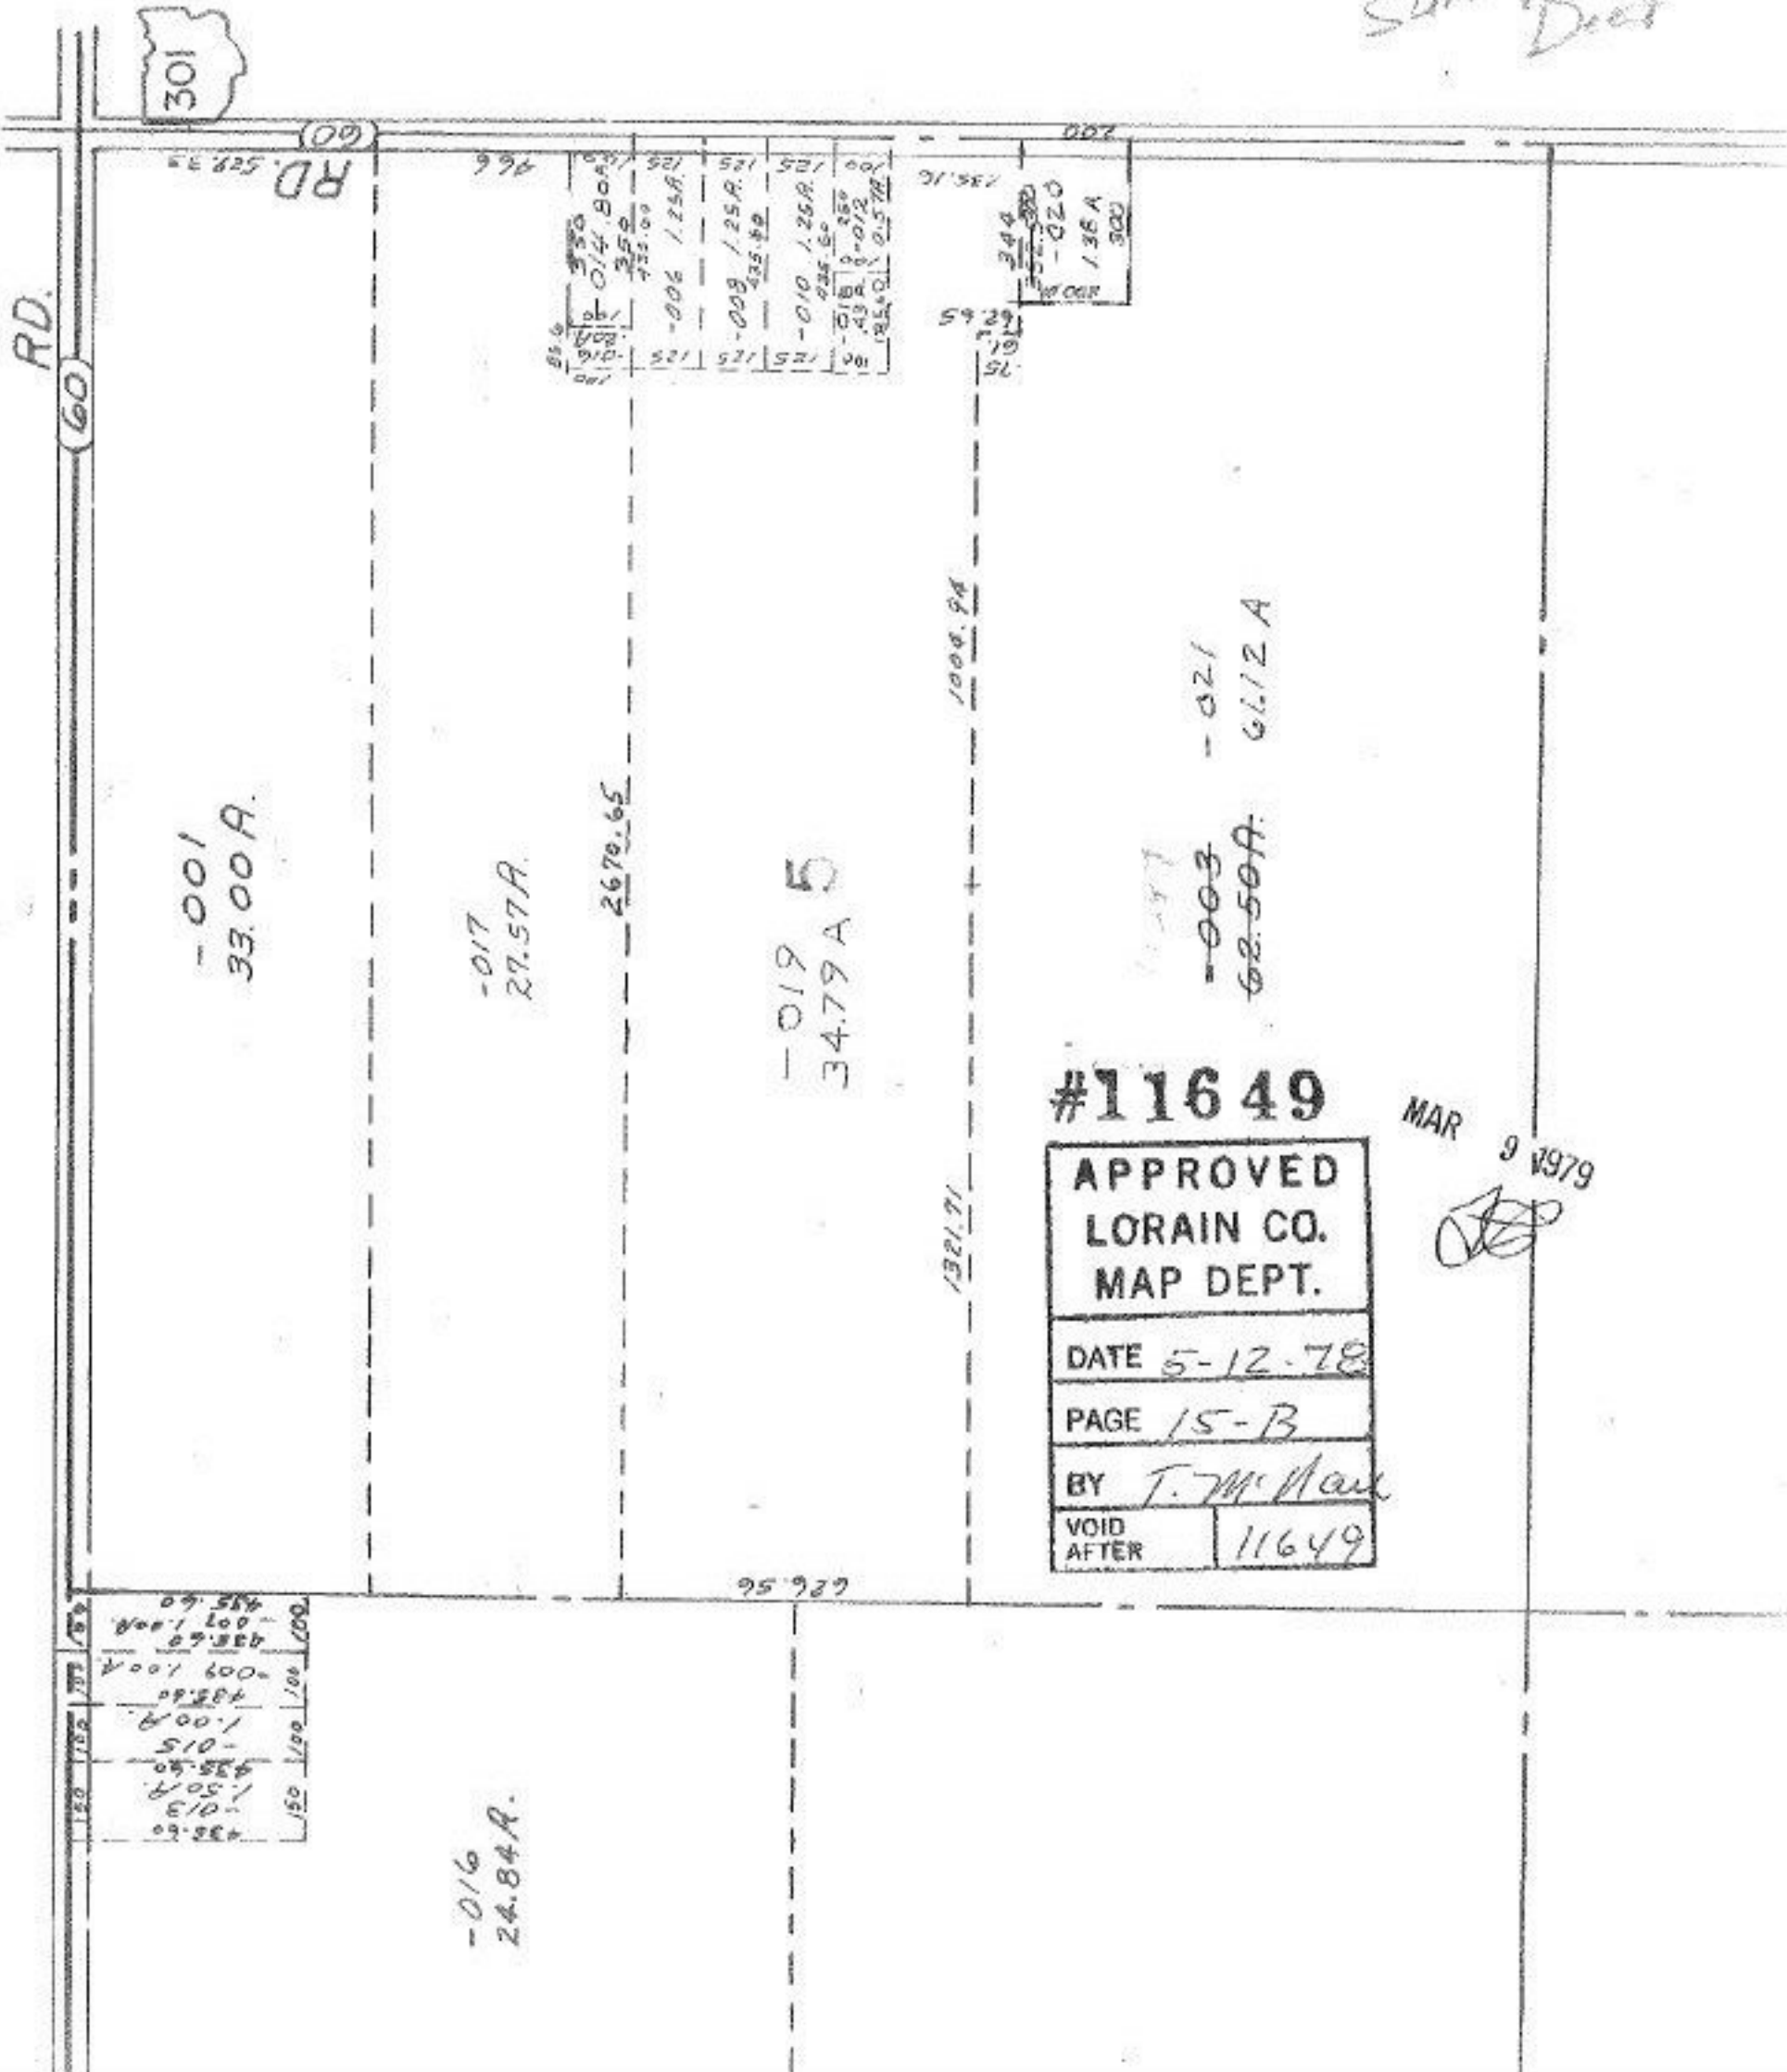

-001  
33.00 A.

-017  
27.57 A.

2670.65

-019 5  
34.79 A

1000.94

-003  
62.50 A.  
-021  
61.12 A.

#11649

APPROVED  
LORAIN CO.  
MAP DEPT.

DATE 5-12-78

PAGE 15-B

BY T. McMan

VOID AFTER 11649

MAR 9 1979

301

RD. 60  
RD. 529.33

RD. 60

1.25	1.25	1.25	1.25	1.25	1.25
0.014	0.014	0.014	0.014	0.014	0.014
0.006	0.006	0.006	0.006	0.006	0.006
1.25	1.25	1.25	1.25	1.25	1.25
0.008	0.008	0.008	0.008	0.008	0.008
0.010	0.010	0.010	0.010	0.010	0.010
0.018	0.018	0.018	0.018	0.018	0.018
0.43	0.43	0.43	0.43	0.43	0.43
0.57	0.57	0.57	0.57	0.57	0.57

0.02	0.02	0.02	0.02	0.02	0.02
0.02	0.02	0.02	0.02	0.02	0.02
1.25	1.25	1.25	1.25	1.25	1.25
0.013	0.013	0.013	0.013	0.013	0.013
1.50	1.50	1.50	1.50	1.50	1.50
4.25	4.25	4.25	4.25	4.25	4.25
1.00	1.00	1.00	1.00	1.00	1.00
1.00	1.00	1.00	1.00	1.00	1.00
-016  
24.84 A.

2670.65

1321.71