


SL 3-00-11

COTTON

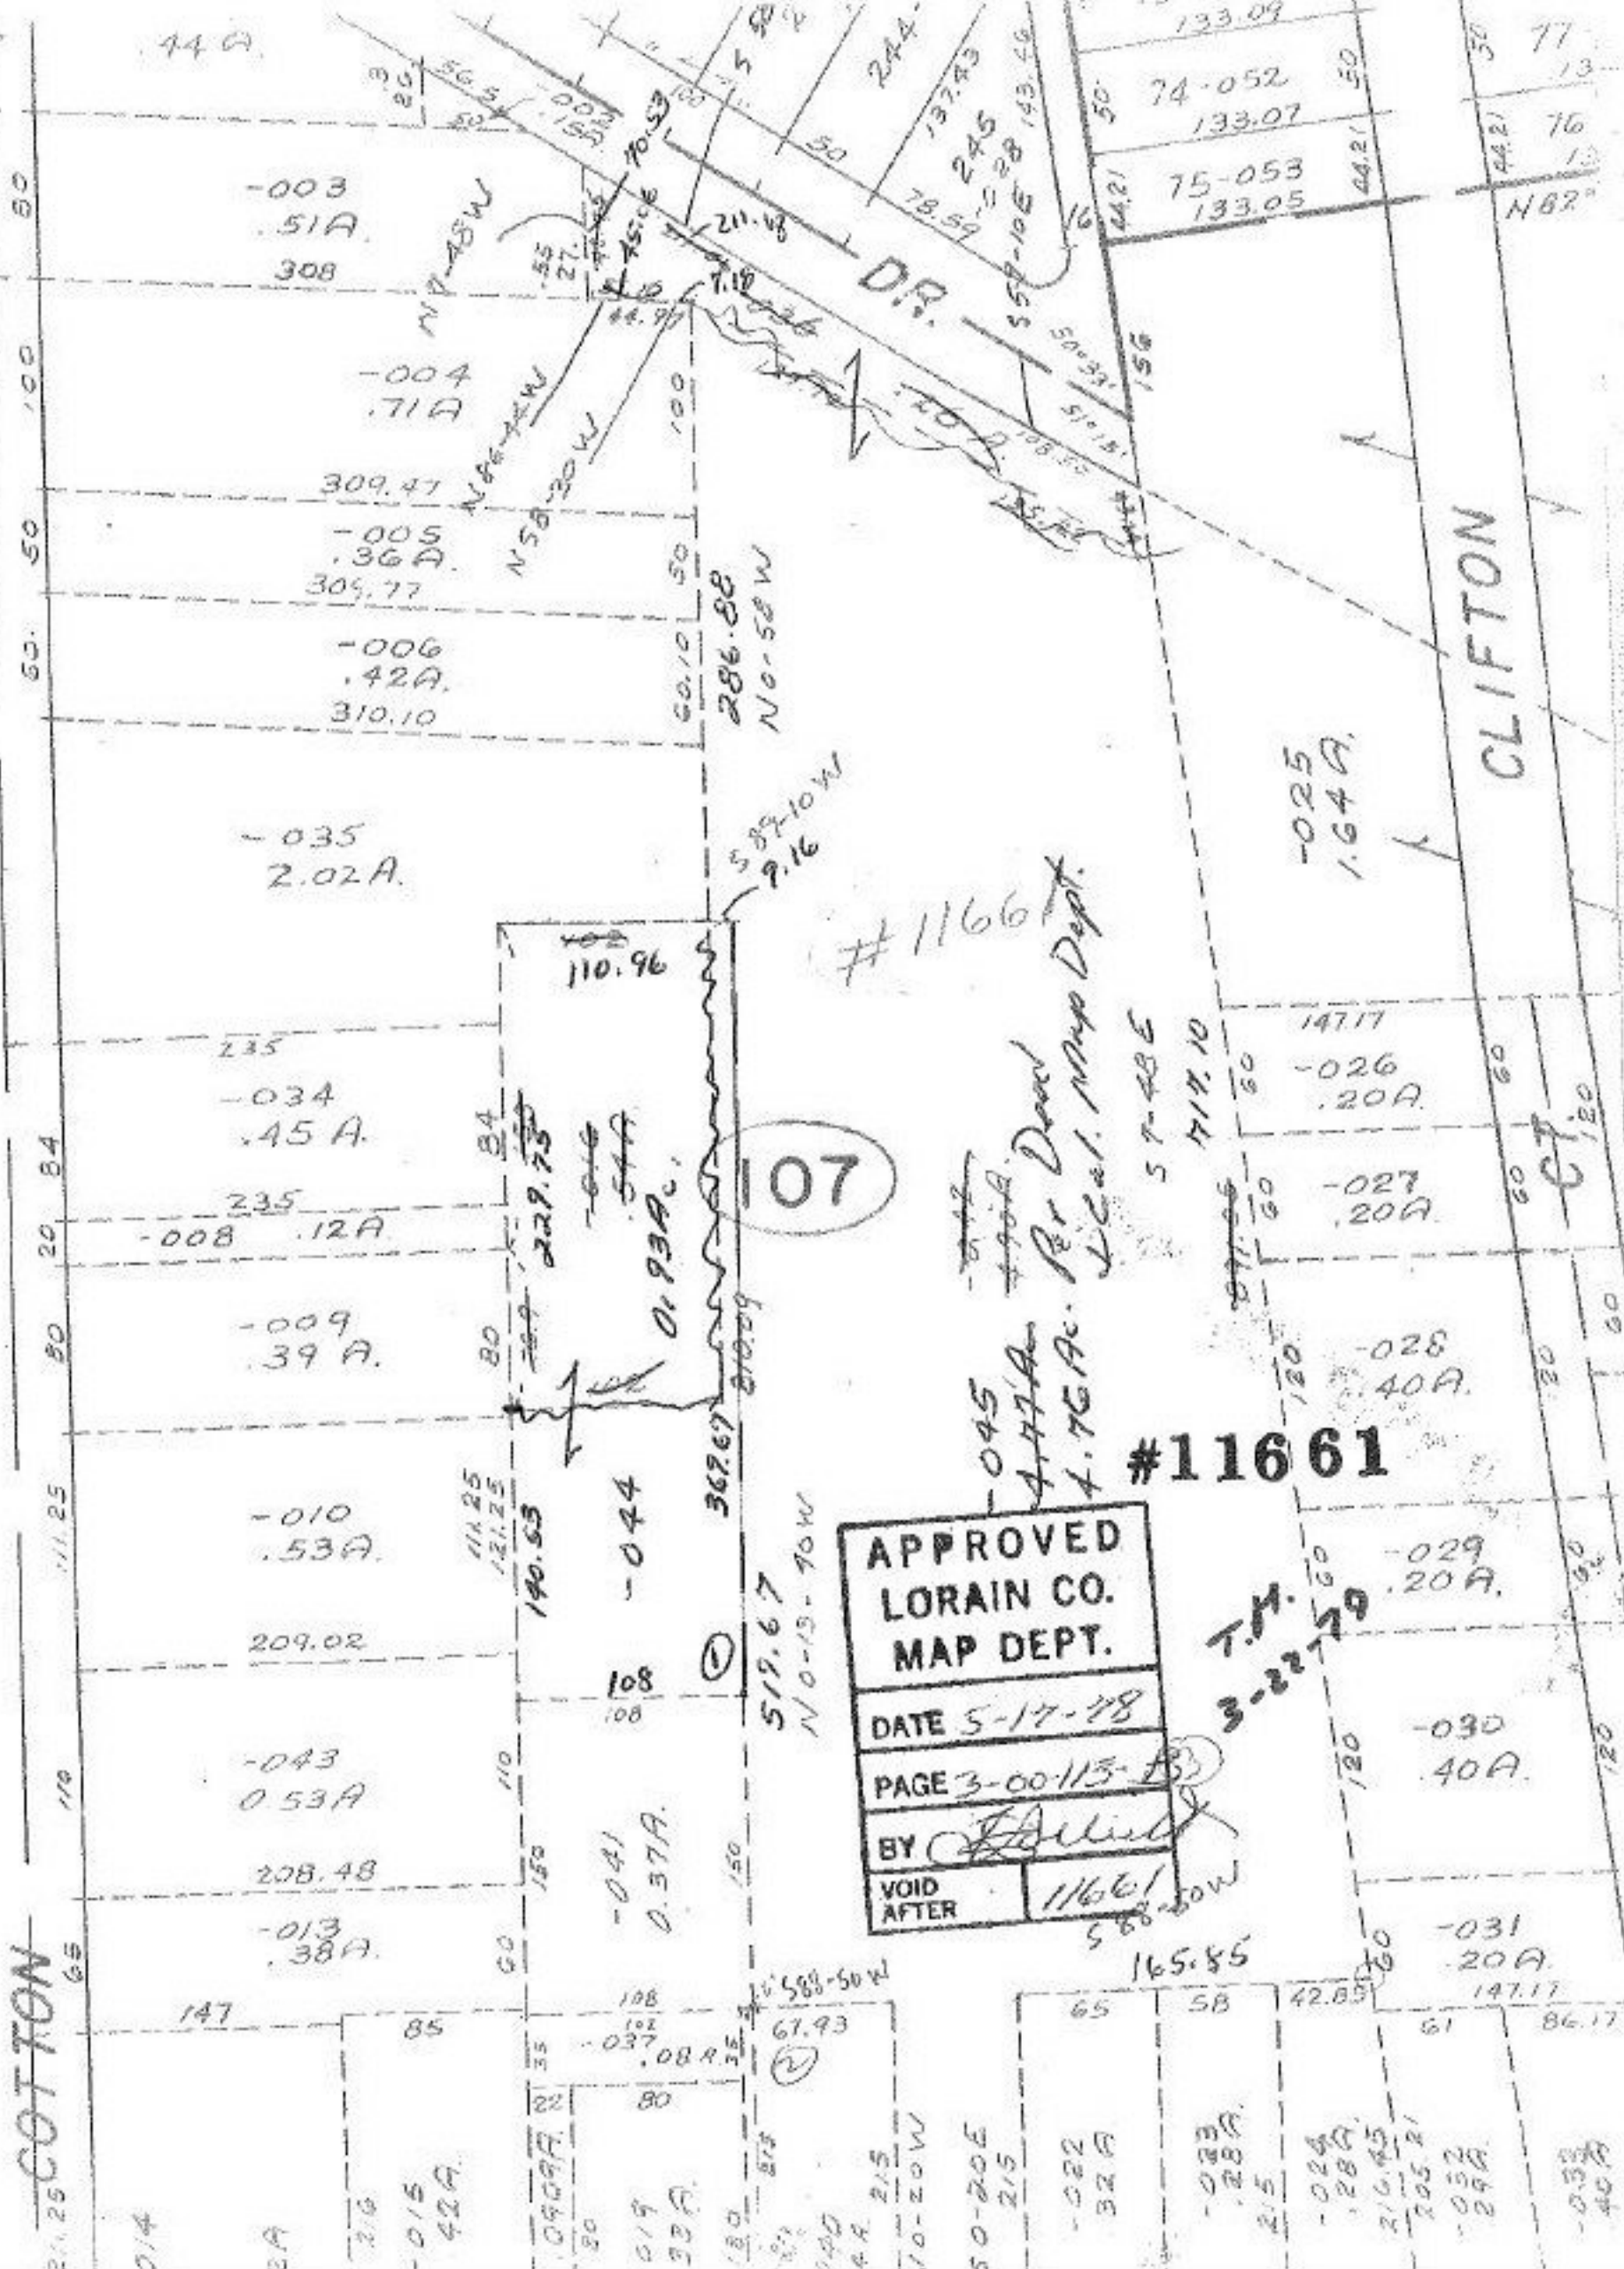

#1166
 Per Deed
 L. Cal. Map Dept.
 4.77 Ac.
 4.76 Ac.

APPROVED
 LORAIN CO.
 MAP DEPT.
 DATE 5-17-78
 PAGE 3-00113-B3
 BY [Signature]
 VOID AFTER 11661

#11661

T.M.
3-22-79

CLIFTON

107

110.96

235

235

80

110

150

110

150

108

108

