

#11667

-005
81.50 A.

APPROVED LORAIN CO. MAP DEPT.	
DATE 5-16-78	
PAGE 15-0	
BY J. Johnson	
VOID AFTER	11.6.67

MAR 9 1979
[Signature]


-001
47.50 A.

-002
47.50 A.

48

~~-003~~
~~65.72 A.~~
-005
53.72 A.

-004
12.00 A.

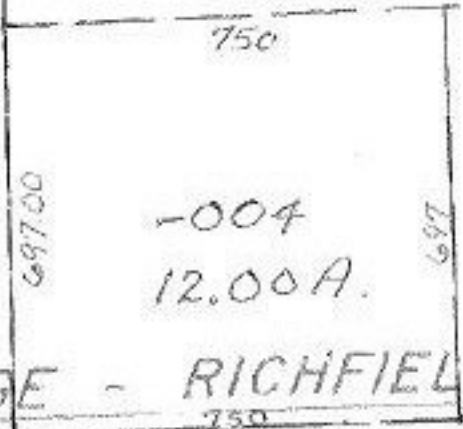

SEE 15-00-049A

WAKEMAN - LAGRANGE - RICHFIELD

LAGRANGE

WHEELER

(60?)

SCALE 1" = 200'