

#11670

APPROVED
LORAIN CO.
MAP DEPT.

DATE 5-18-78

PAGE 1-10-017-A-B

BY G.H.


VOID AFTER 11670

NR 3-5-79

PT. ~~000~~ PT-099
PT. 46-13A 45.67A

01911 #

#11670

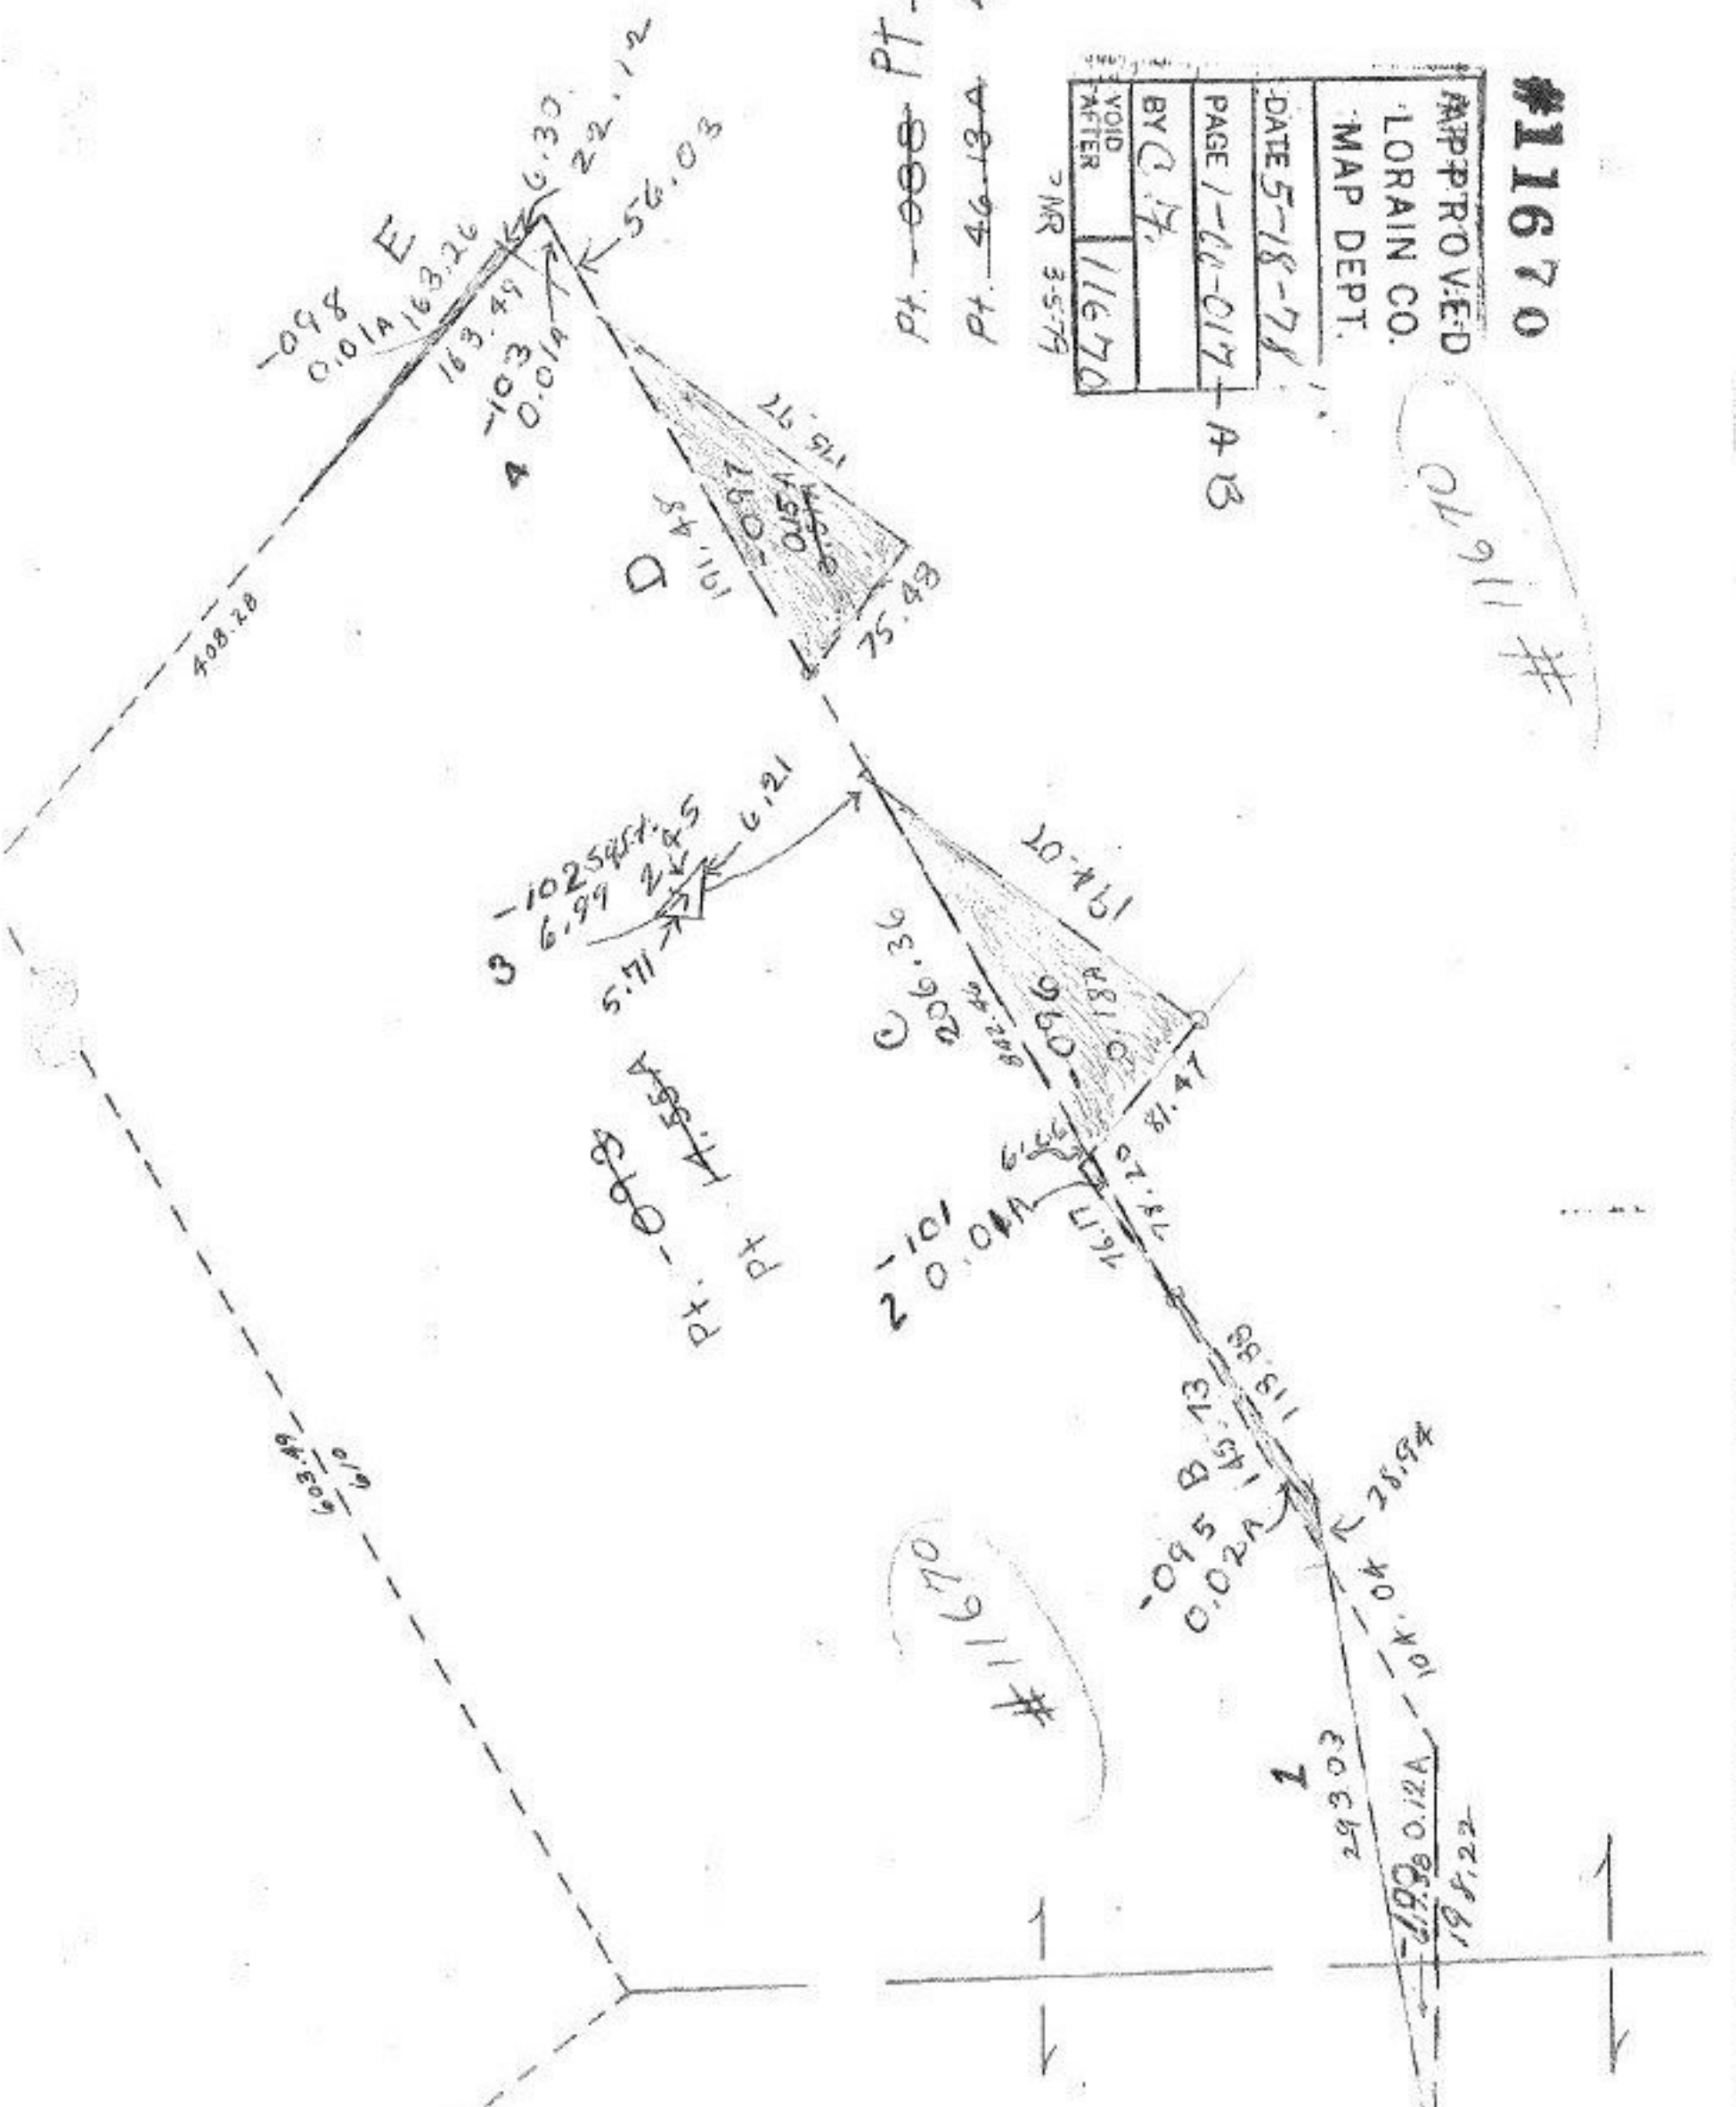

1

29303

1998 0.12A

198.22