


TWP

SCALE: 1" = 400'

LOTS 25-51 THRU 55, 66 THRU

-004
50.00A.

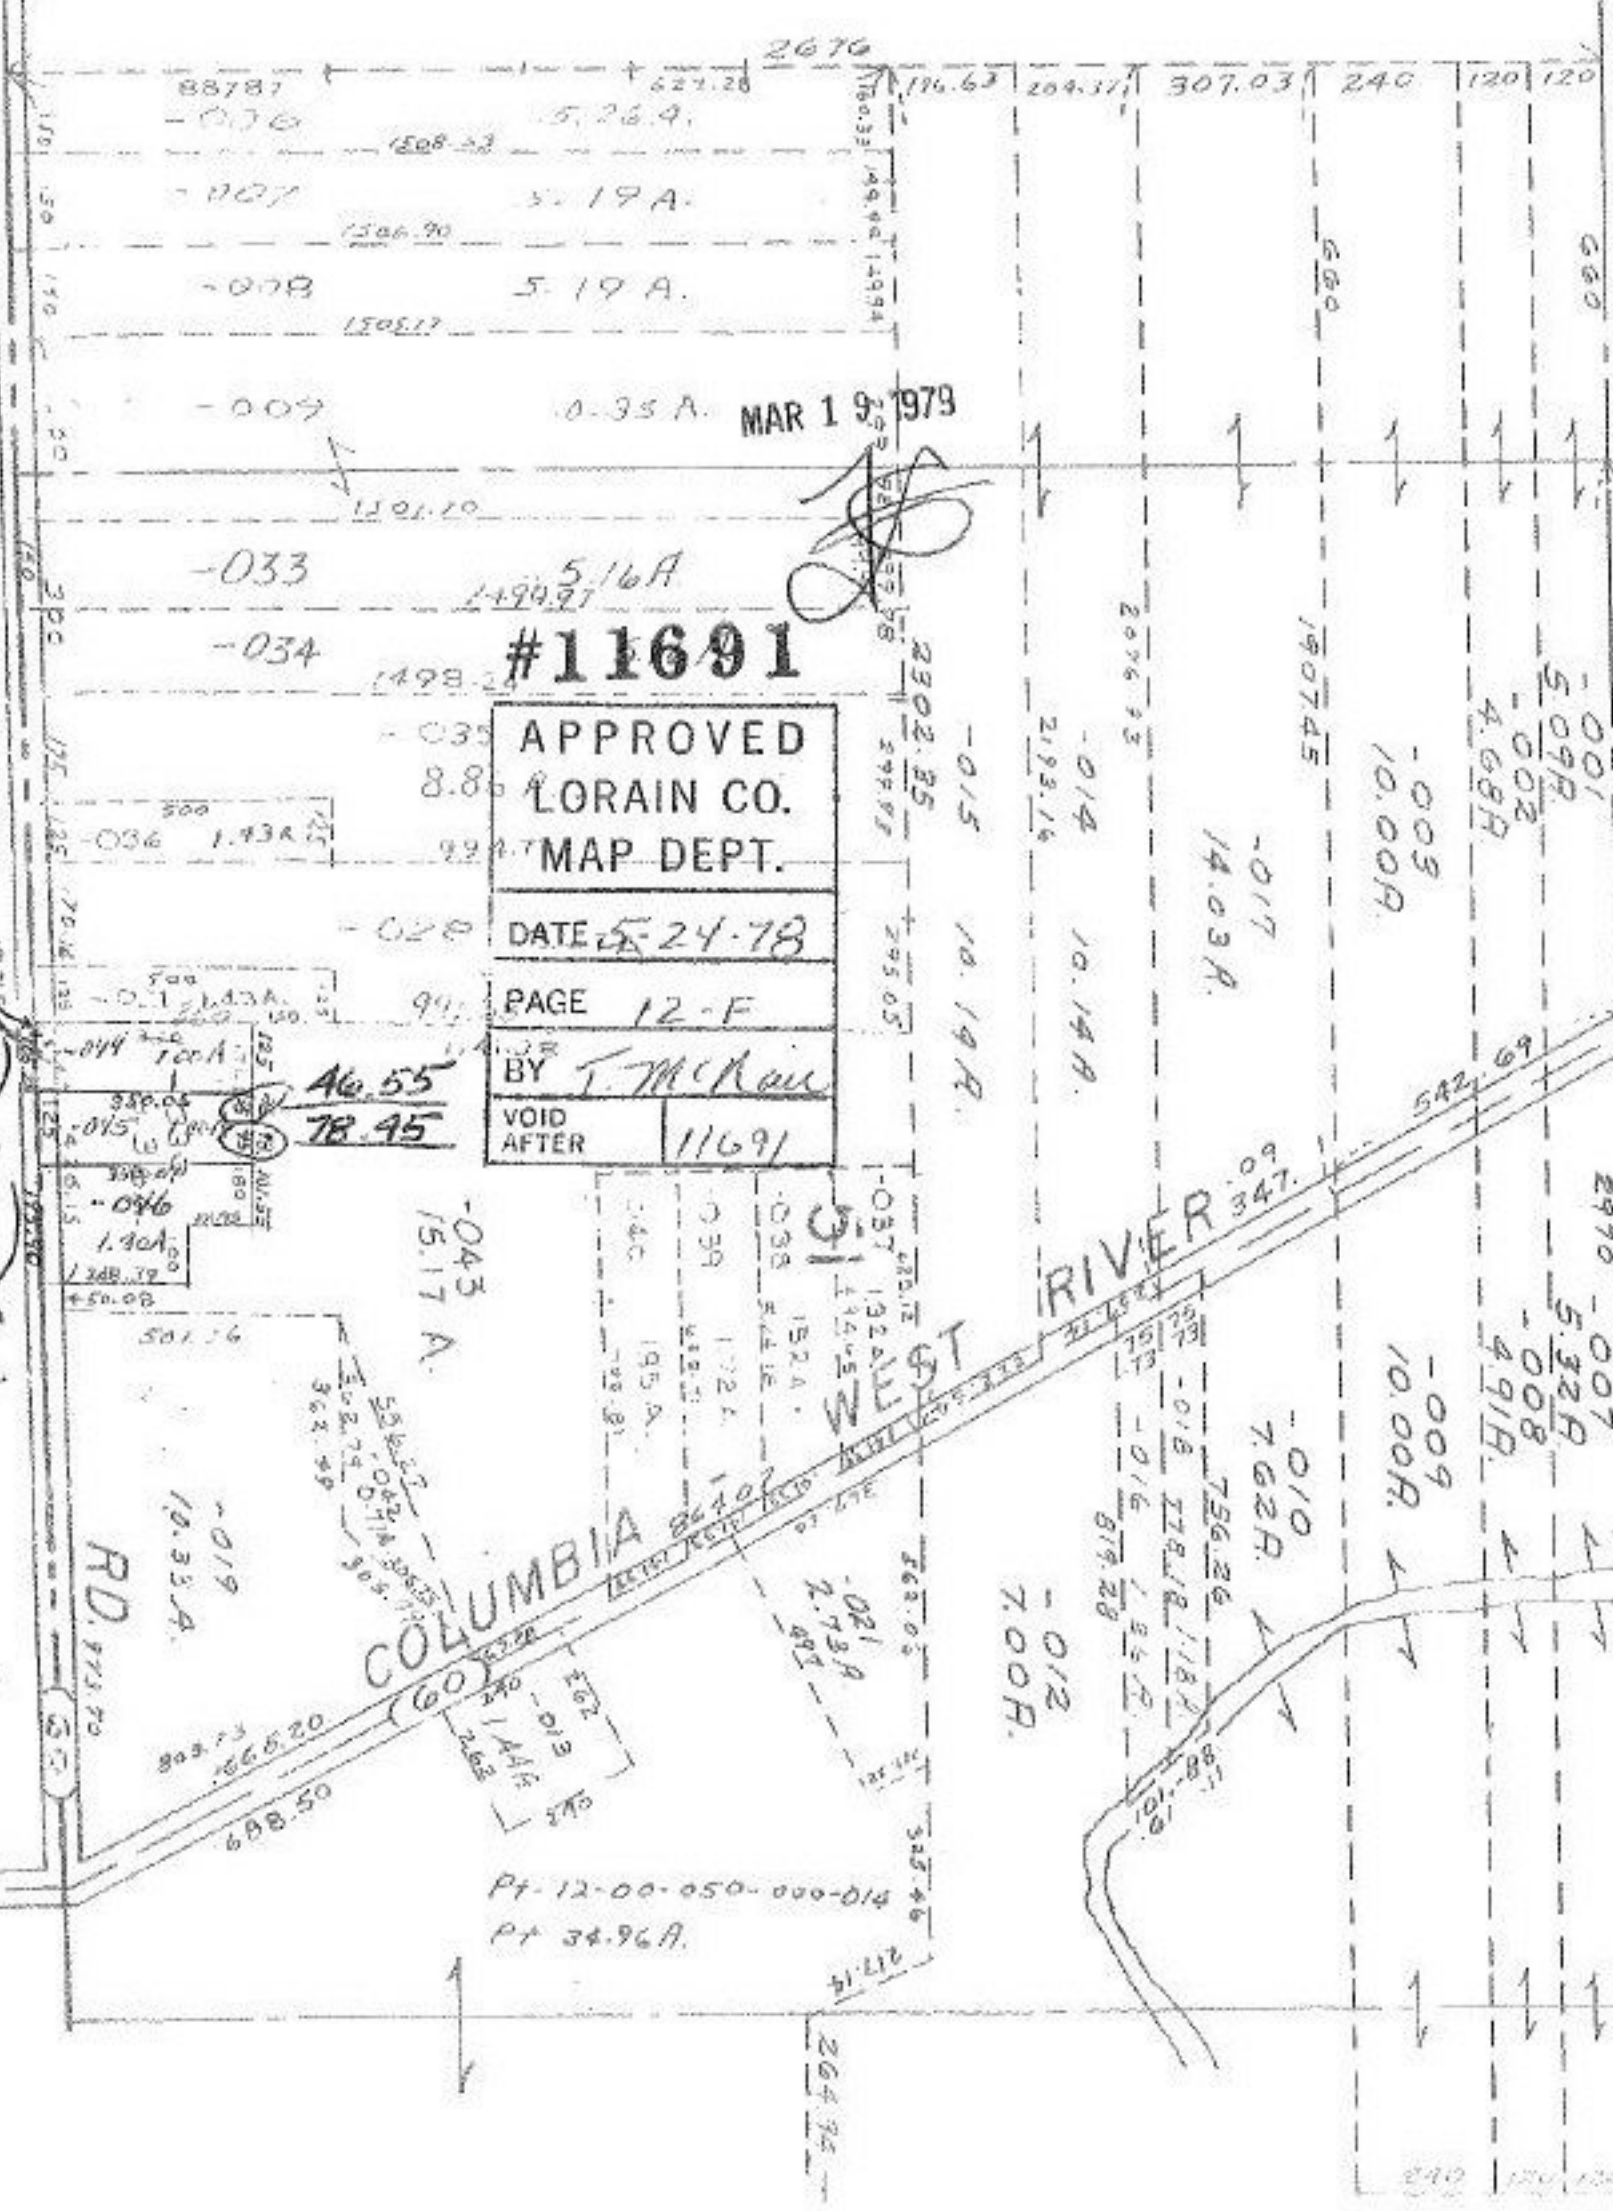

#11691

APPROVED
LORAIN CO.
MAP DEPT.

DATE 5-24-78

PAGE 12-F

BY T. McKail

VOID AFTER 11691

MAR 19 1979

COLUMBIA RIVER

COLUMBIA RIVER

RD. 911.70

Pt. 12-00-050-000-014
Pt 34.96A.