

(4) OF (5)

#11695


102

APPROVED LORAIN CO. MAP DEPT.	
DATE 5-26-78	
PAGE 4-00-028-E	
BY J. Johnson	
VOID AFTER	11695

AVON

R.D.

Change Rd  
to  
Avon Rd.

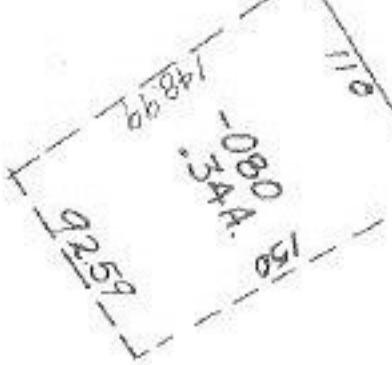

SEE 4-00-027-A

4-00-028-E



898.25

-081  
8.40A

-055 R  
2.05 R

-067  
4.45 R

-080  
34A

1091.45

79.06