


1179.55

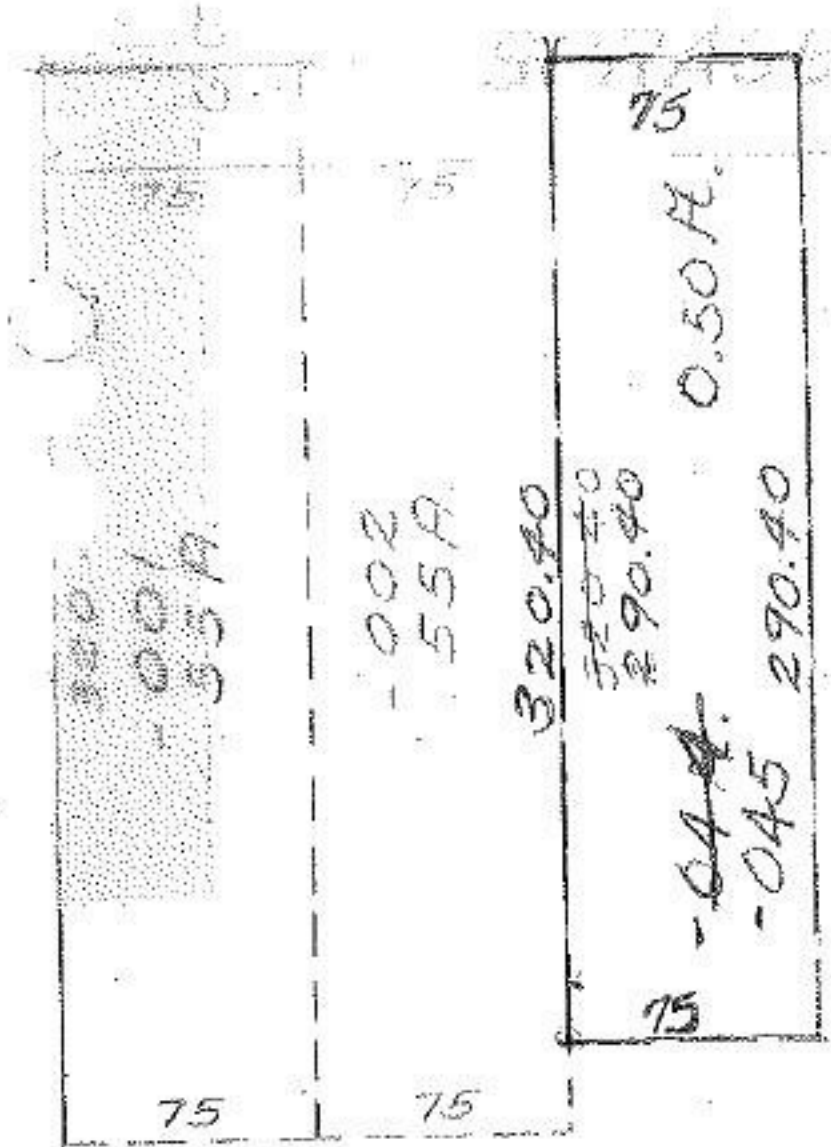

#11701

APPROVED LORAIN CO. MAP DEPT.	
DATE 5-26-78	
PAGE 12-00-081A	
BY J. Johnson	
VOID AFTER	11701

MAR 19 1979

-046  
~~-045~~  
 23.65A.

~~-042~~  
 24.15A.