


041
A. 102.7

347.53

564.38

894.12

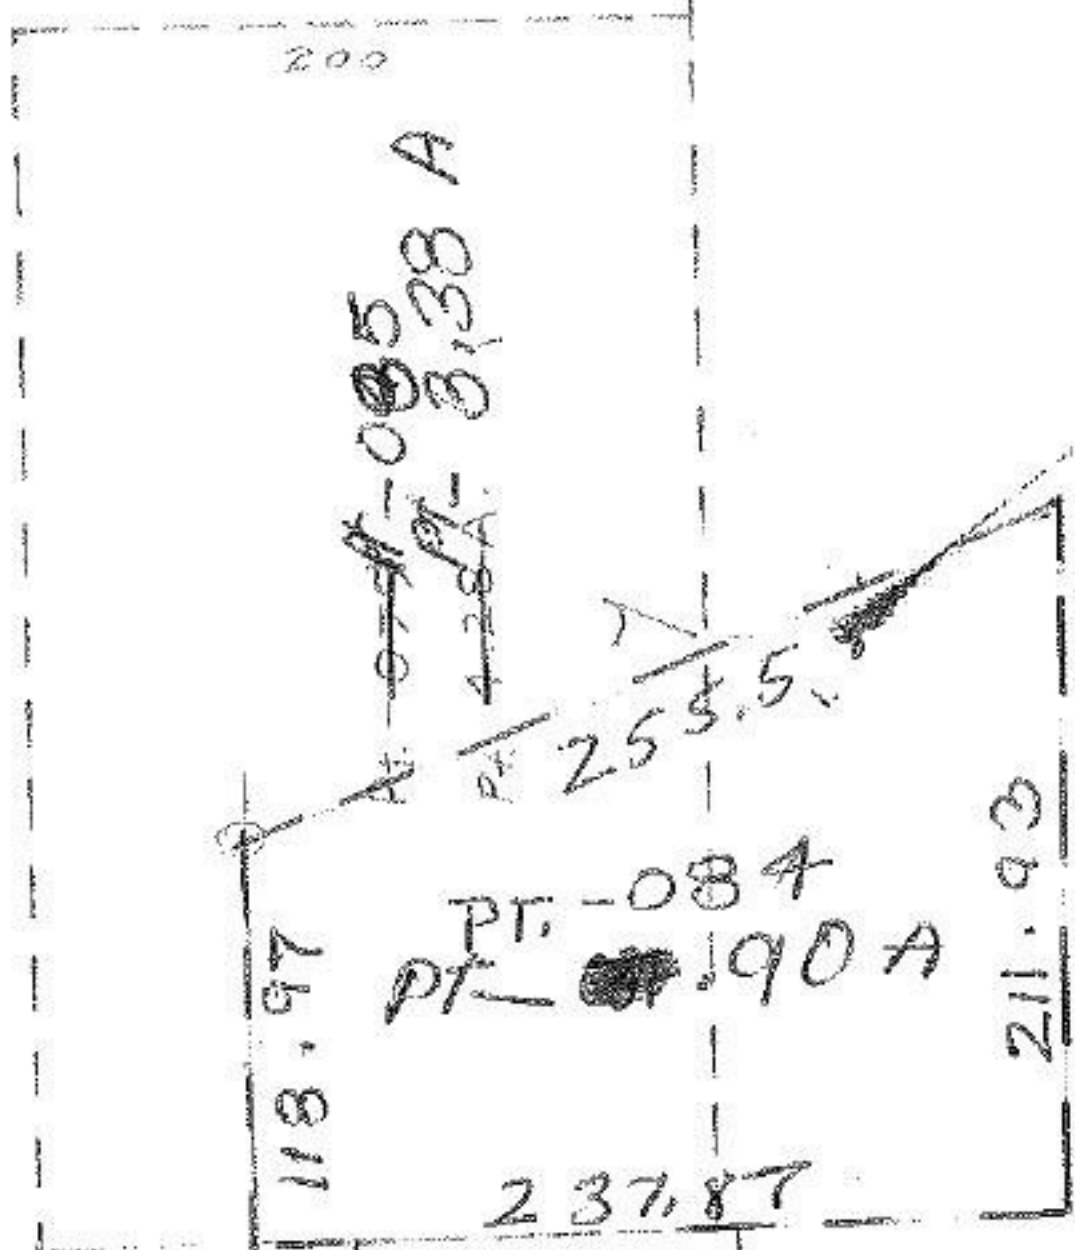

#11704

APPROVED
LORAIN CO.
MAP DEPT.