


58

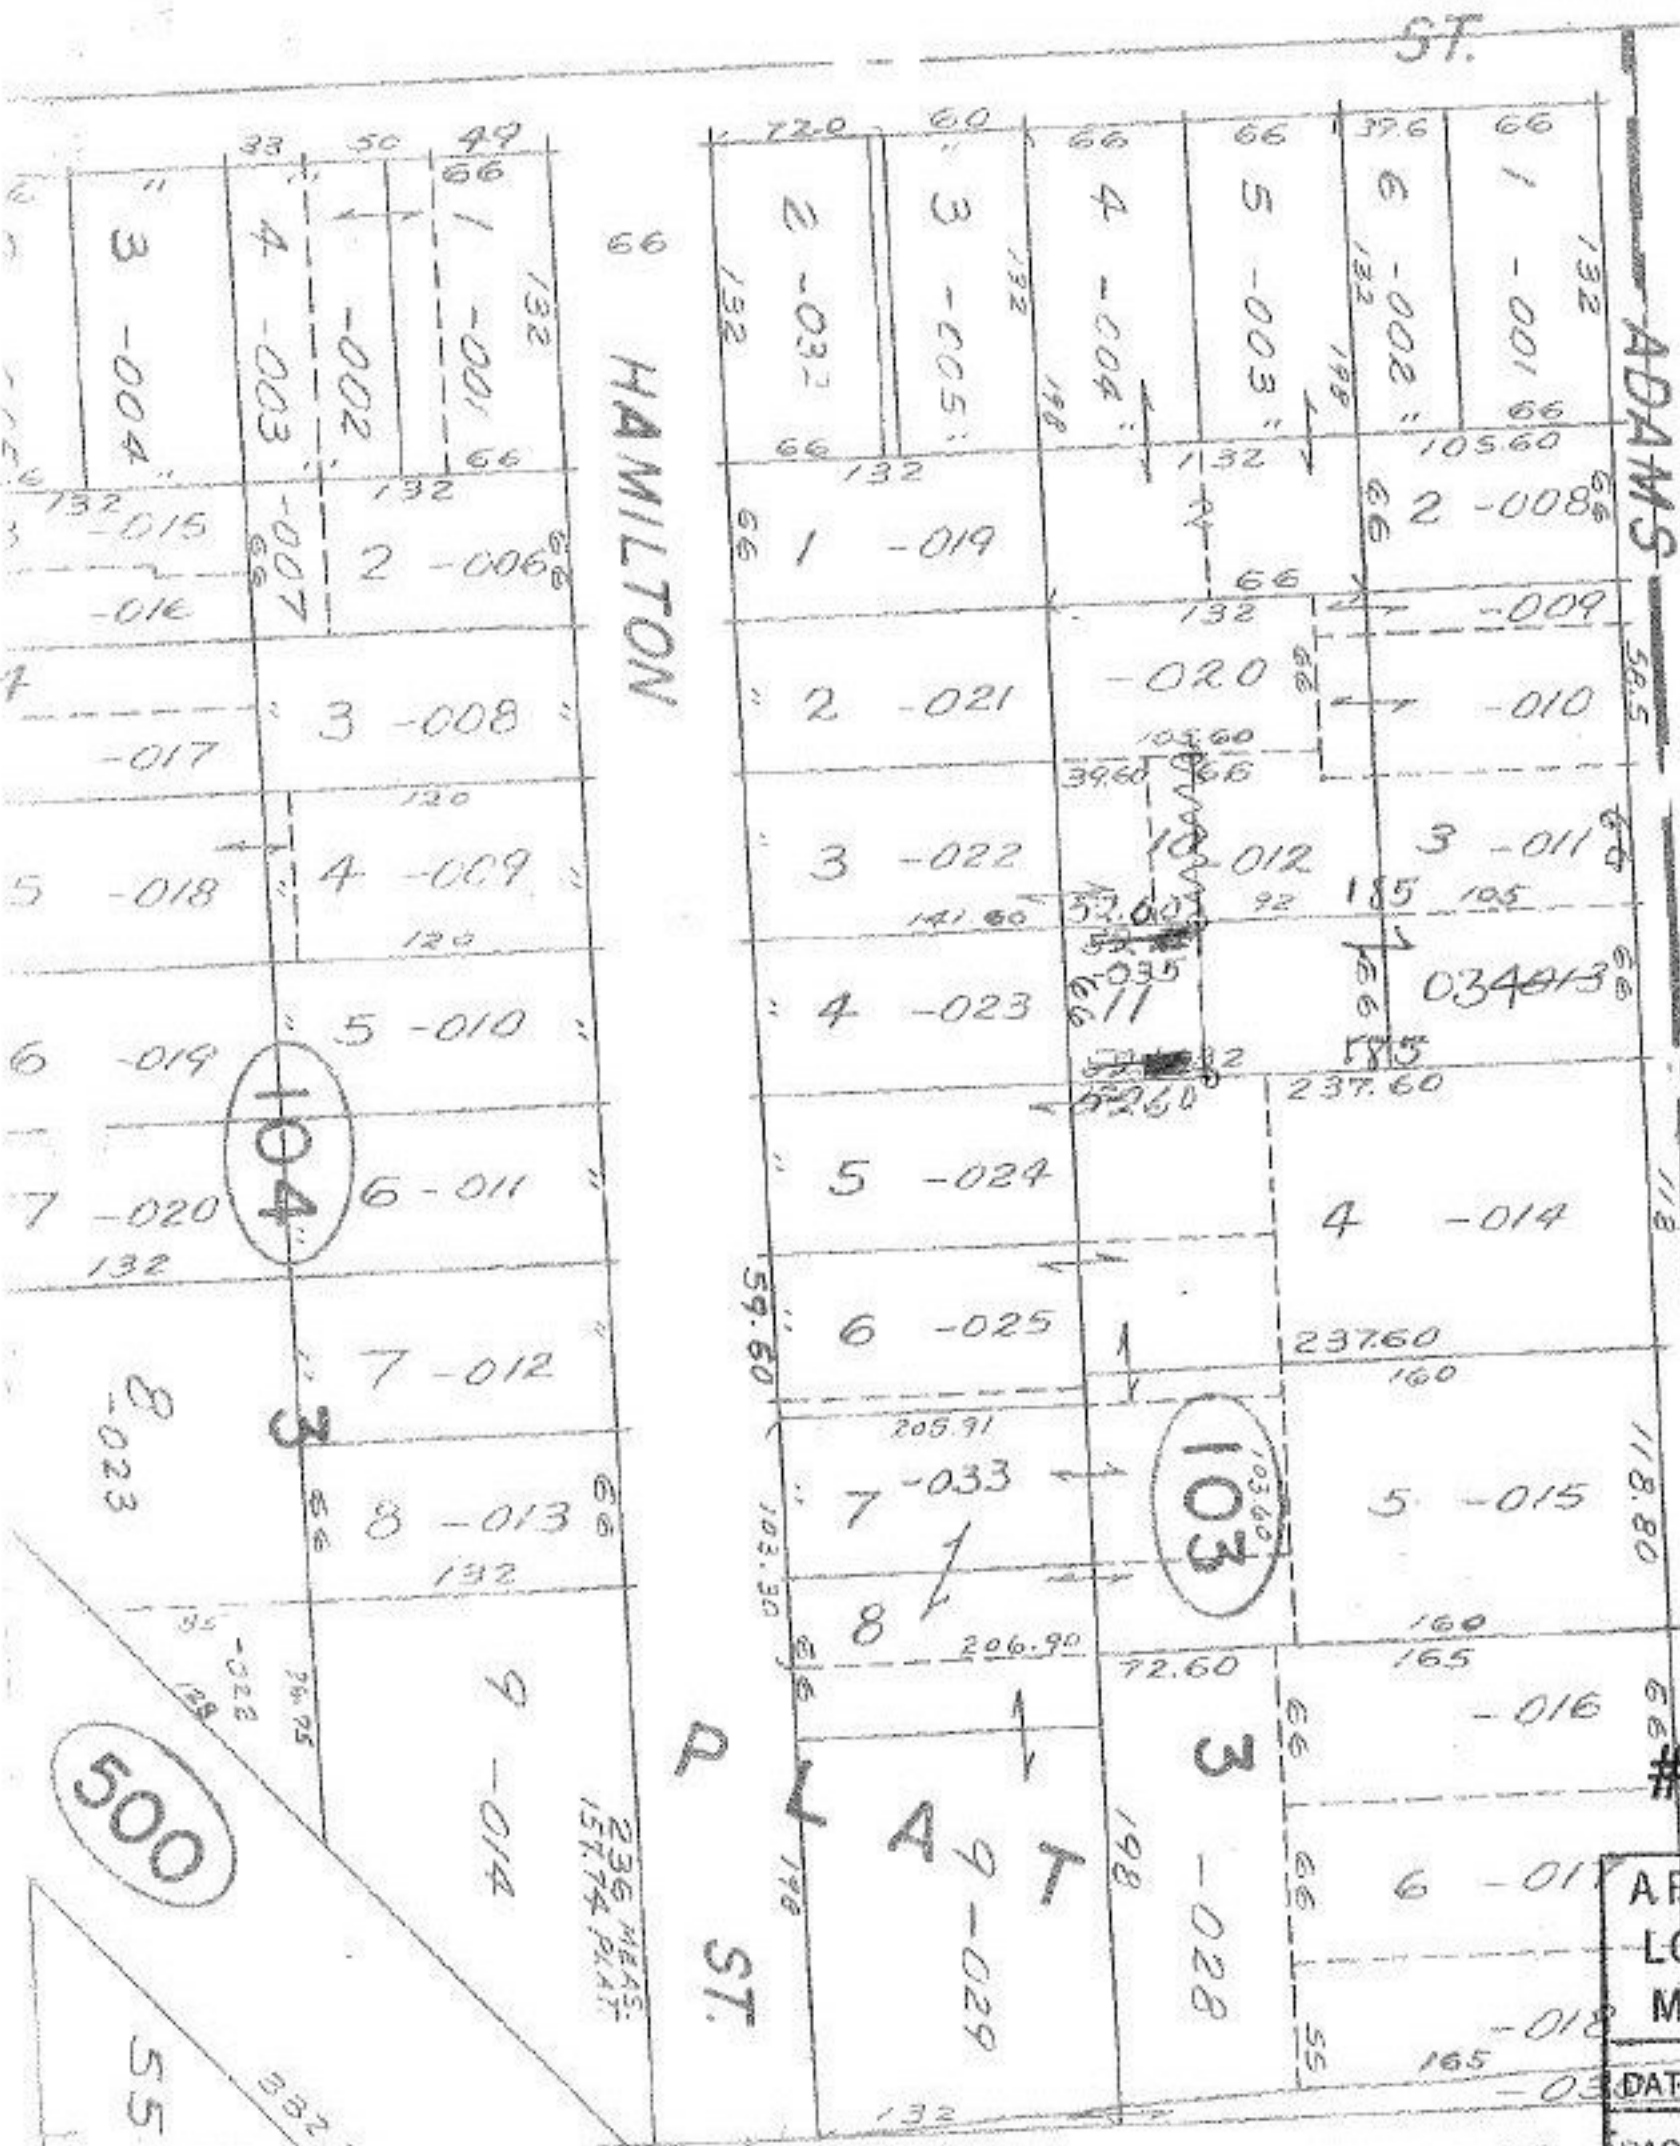

Change  
 By map  
 Dept  
 From  
 52.60  
 To  
 52.60  
 7-15-78

SEE 18700  
 #11710

APPROVED LORAIN CO. MAP DEPT.	
DATE	5-30-78
PAGE	18-00-021-C
BY	C. Francis
VOID AFTER	11710

10-20-78

29

500

57