


11, 2, 13  
23 & 24

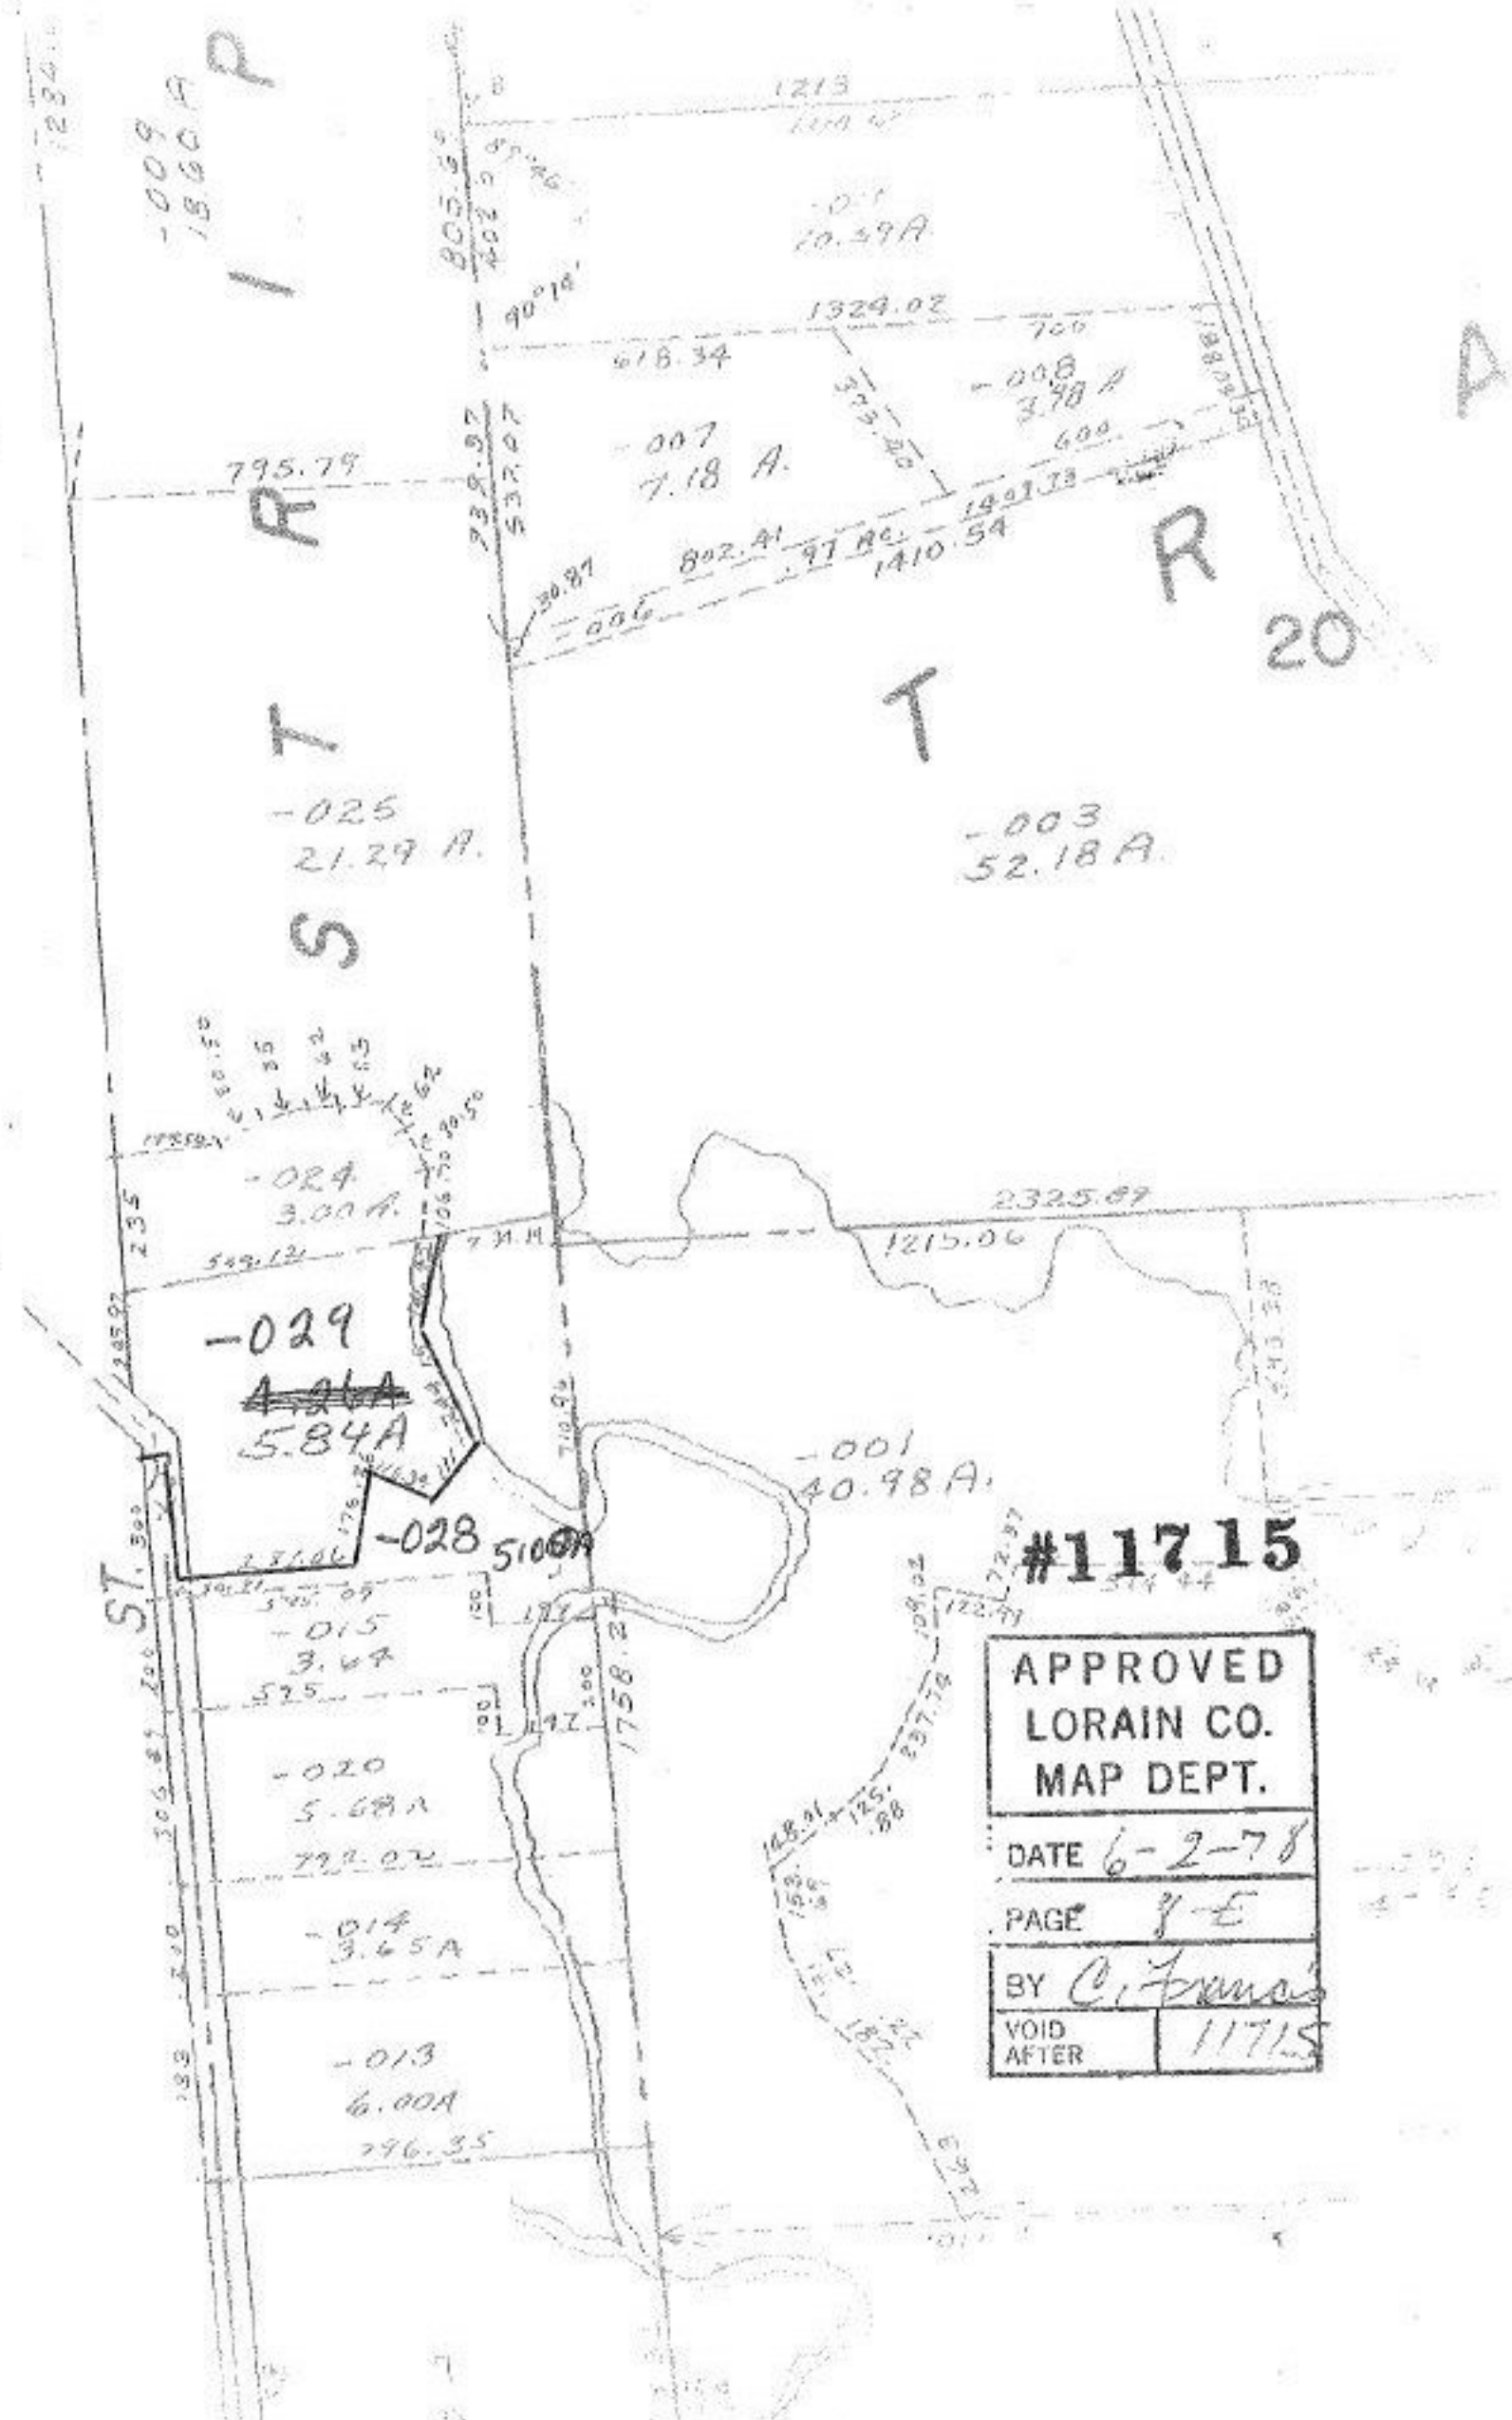

#11715

APPROVED LORAIN CO. MAP DEPT.	
DATE	6-2-78
PAGE	8-E
BY	C. F. [Signature]
VOID AFTER	11715