

#11733

|                                     |
|-------------------------------------|
| APPROVED<br>LORAIN CO.<br>MAP DEPT. |
| DATE 6-26-78                        |
| PAGE 6.00-046-A                     |
| BY T. M. Paw                        |
| VOID AFTER 11733                    |

MAR 12 1979

*[Signature]*


-018  
54.19A

*[Signature]*

998.58

-017  
10.29A

THIS LAND HOOK PUT  
IN PER SURVEY  
JOHN POZYWALK  
SEE DESCRIPTION WITH  
SPLIT # 11733  
& ALSO SURVEY

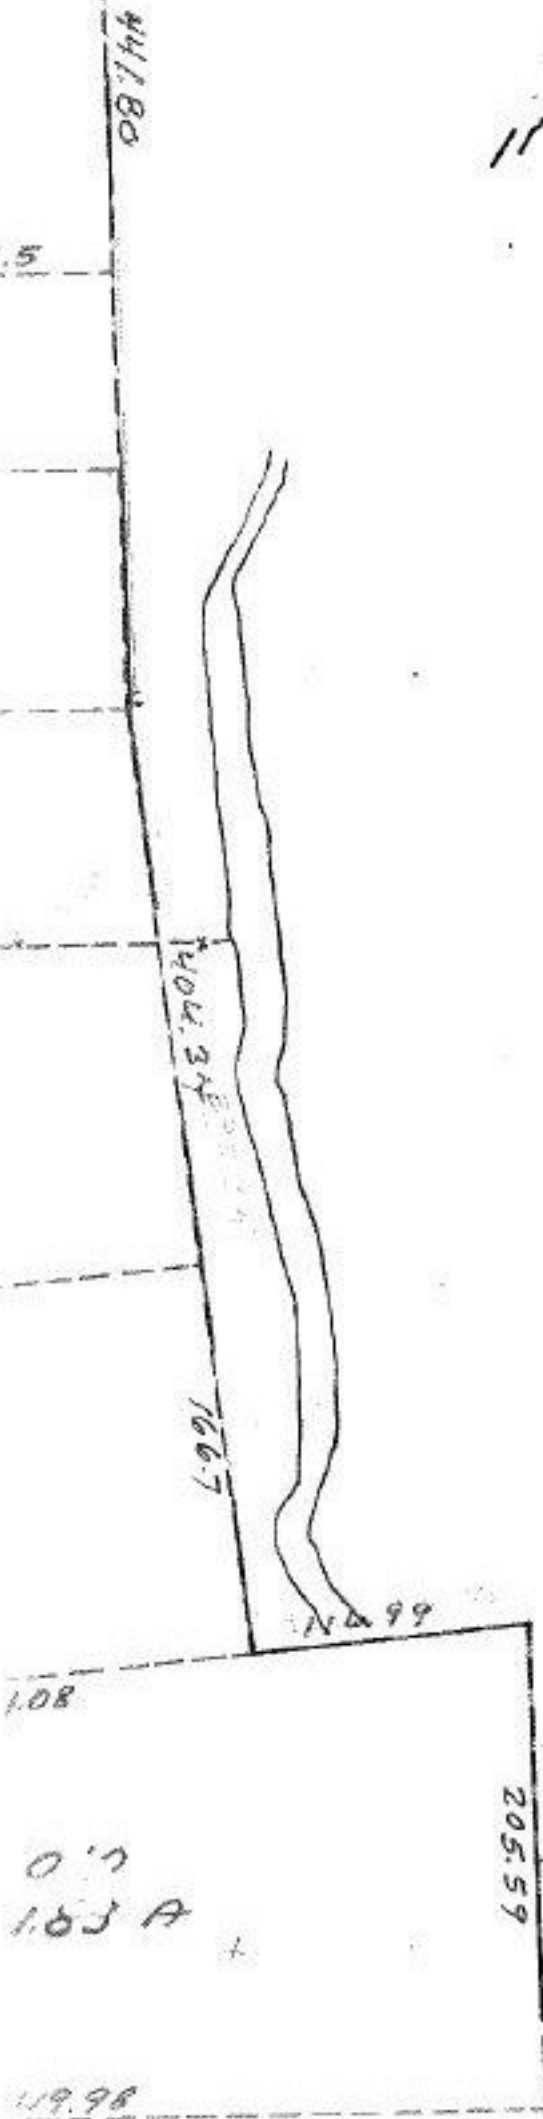

*[Handwritten notes]*