


-C10
4.30 A

PH. 03-00-033-109-052
PH. 578 A

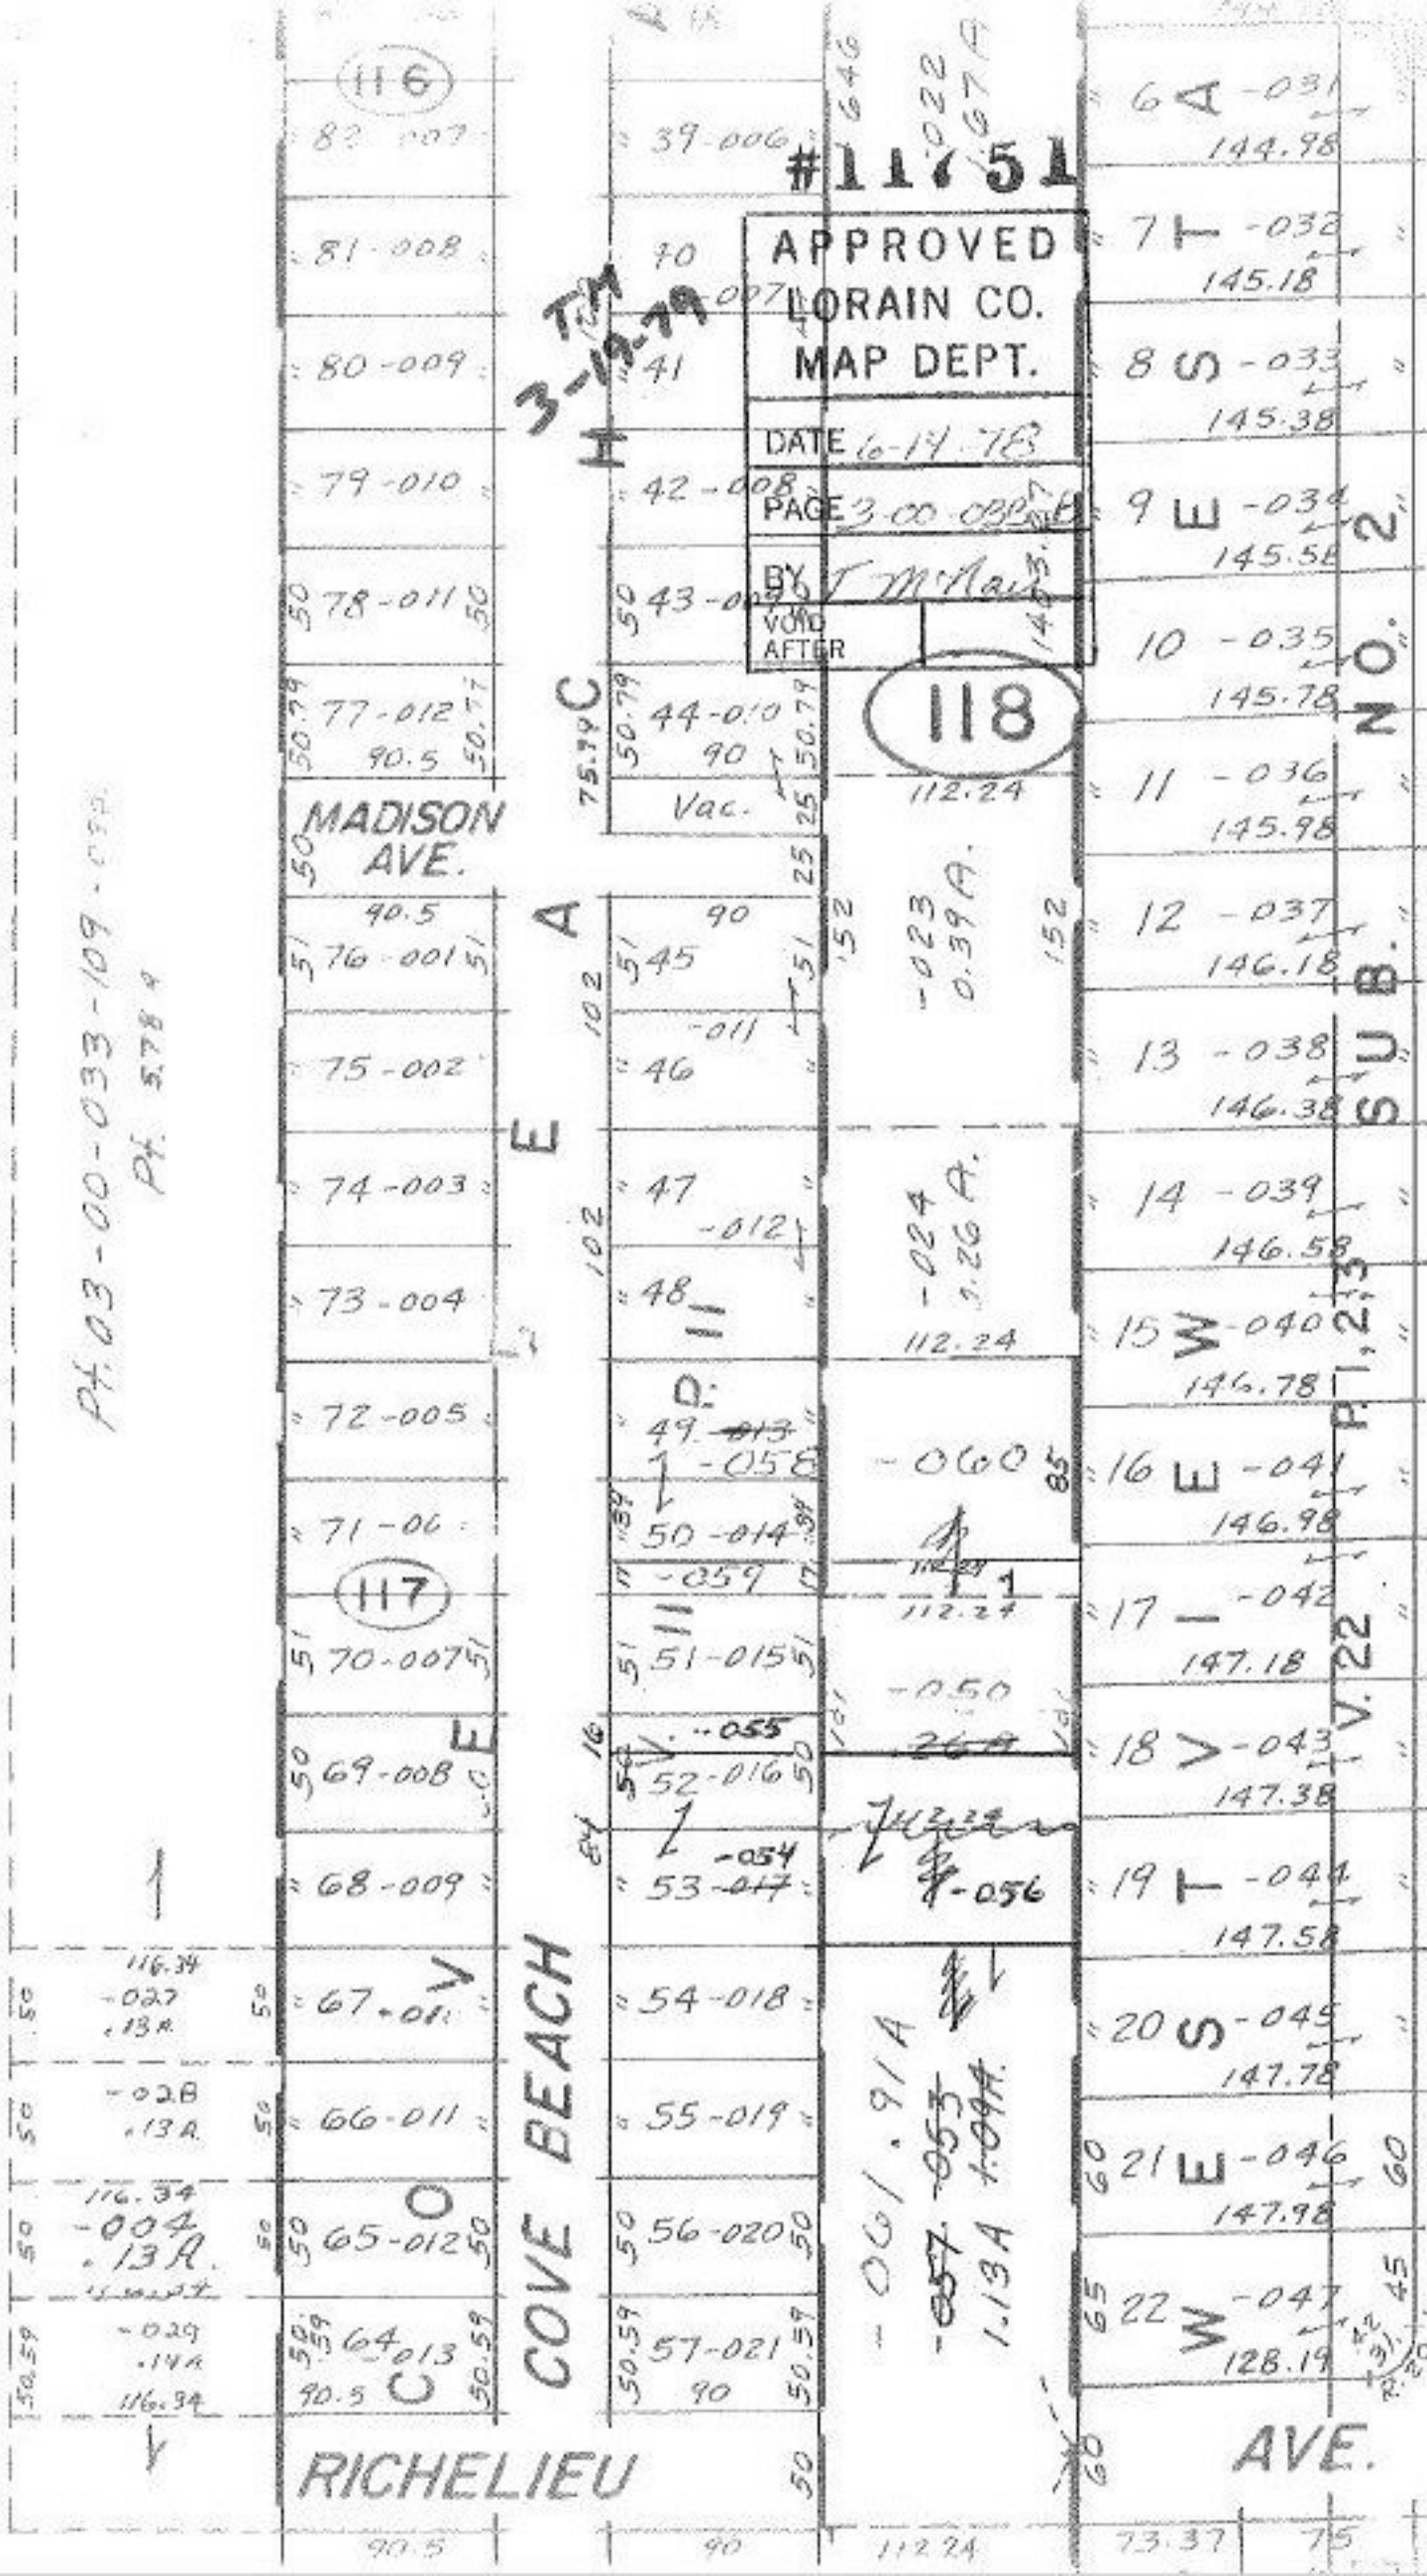

SEE 3-00-032-B

LYNNE