


IT HOOKS  
UP HERE

ARTIMIO AVE

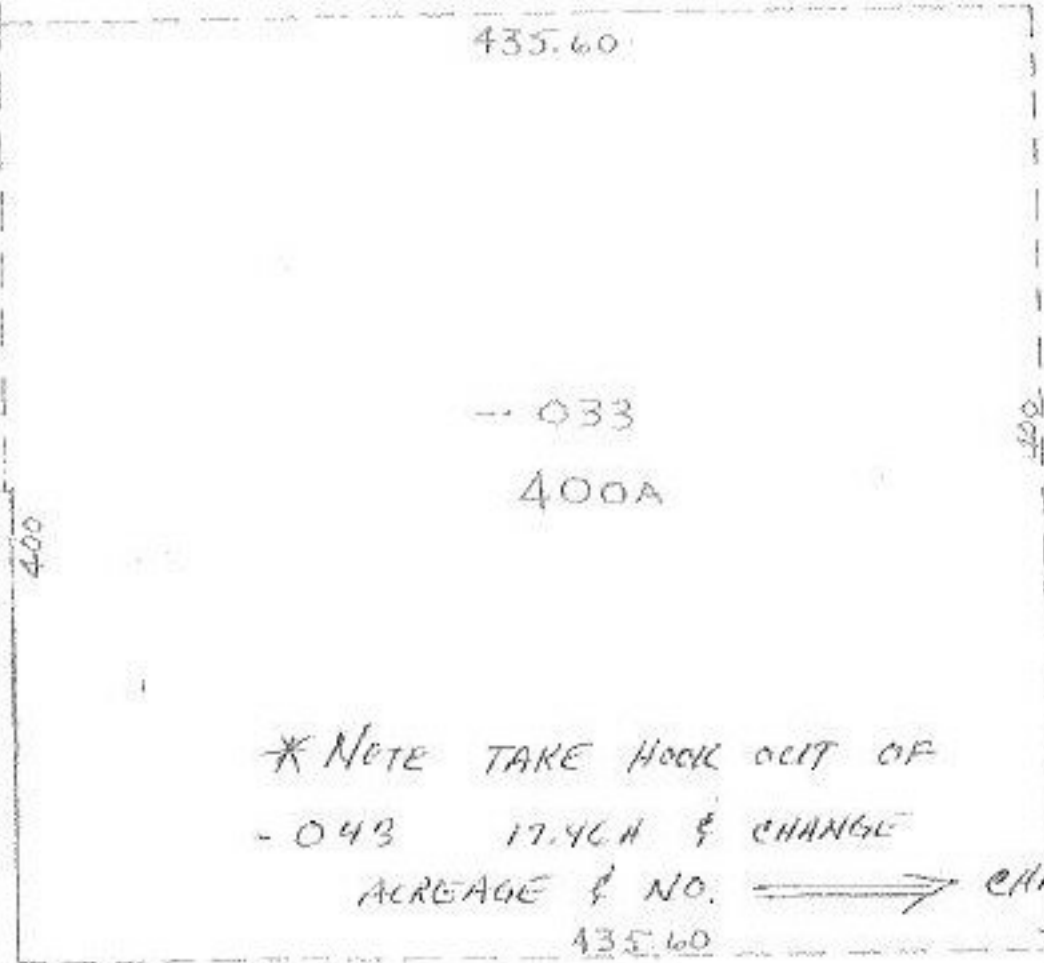

-039  
12.69A.

-- 033  
400A

\* NOTE TAKE HOOK OUT OF  
-043 17.46A & CHANGE  
ACREAGE & NO.  $\implies$  CHANGE TO  
435.60  $\implies$  +045  
16.91

**#11752**

APPROVED  
LORAIN CO.  
MAP DEPT.


DATE 6-15-78

PAGE 9-00-017-B

BY T. McHain

VOID  
AFTER

T.M  
3-13-79

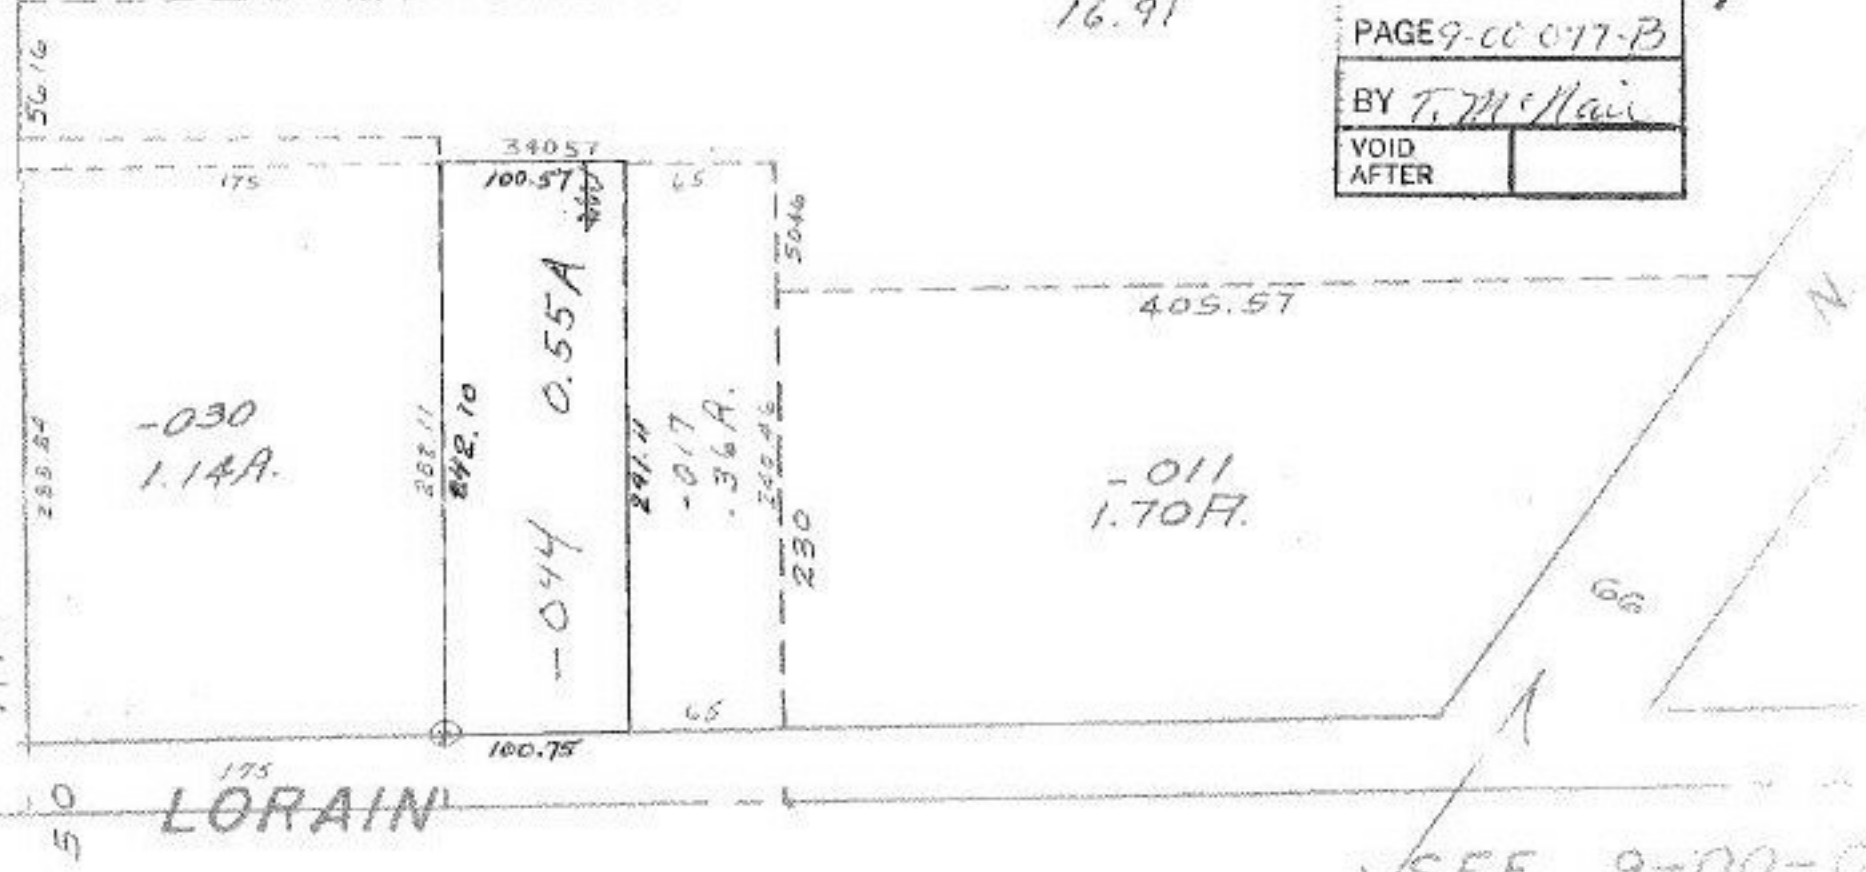

SEE 9-00-0