

113

-005  
7.98A.

606  
10688

630

624.11

611

ST.

-003  
1.38 A.


-002  
1.28 A.

-016  
1.76 A. #11776

APPROVED LORAIN CO. MAP DEPT.	
DATE	6-22-78
PAGE	2-01-023 B
BY	<i>[Signature]</i>
VOID METER NR	3-6-79

22-023-114-017  
240A.

2.97  
1.98

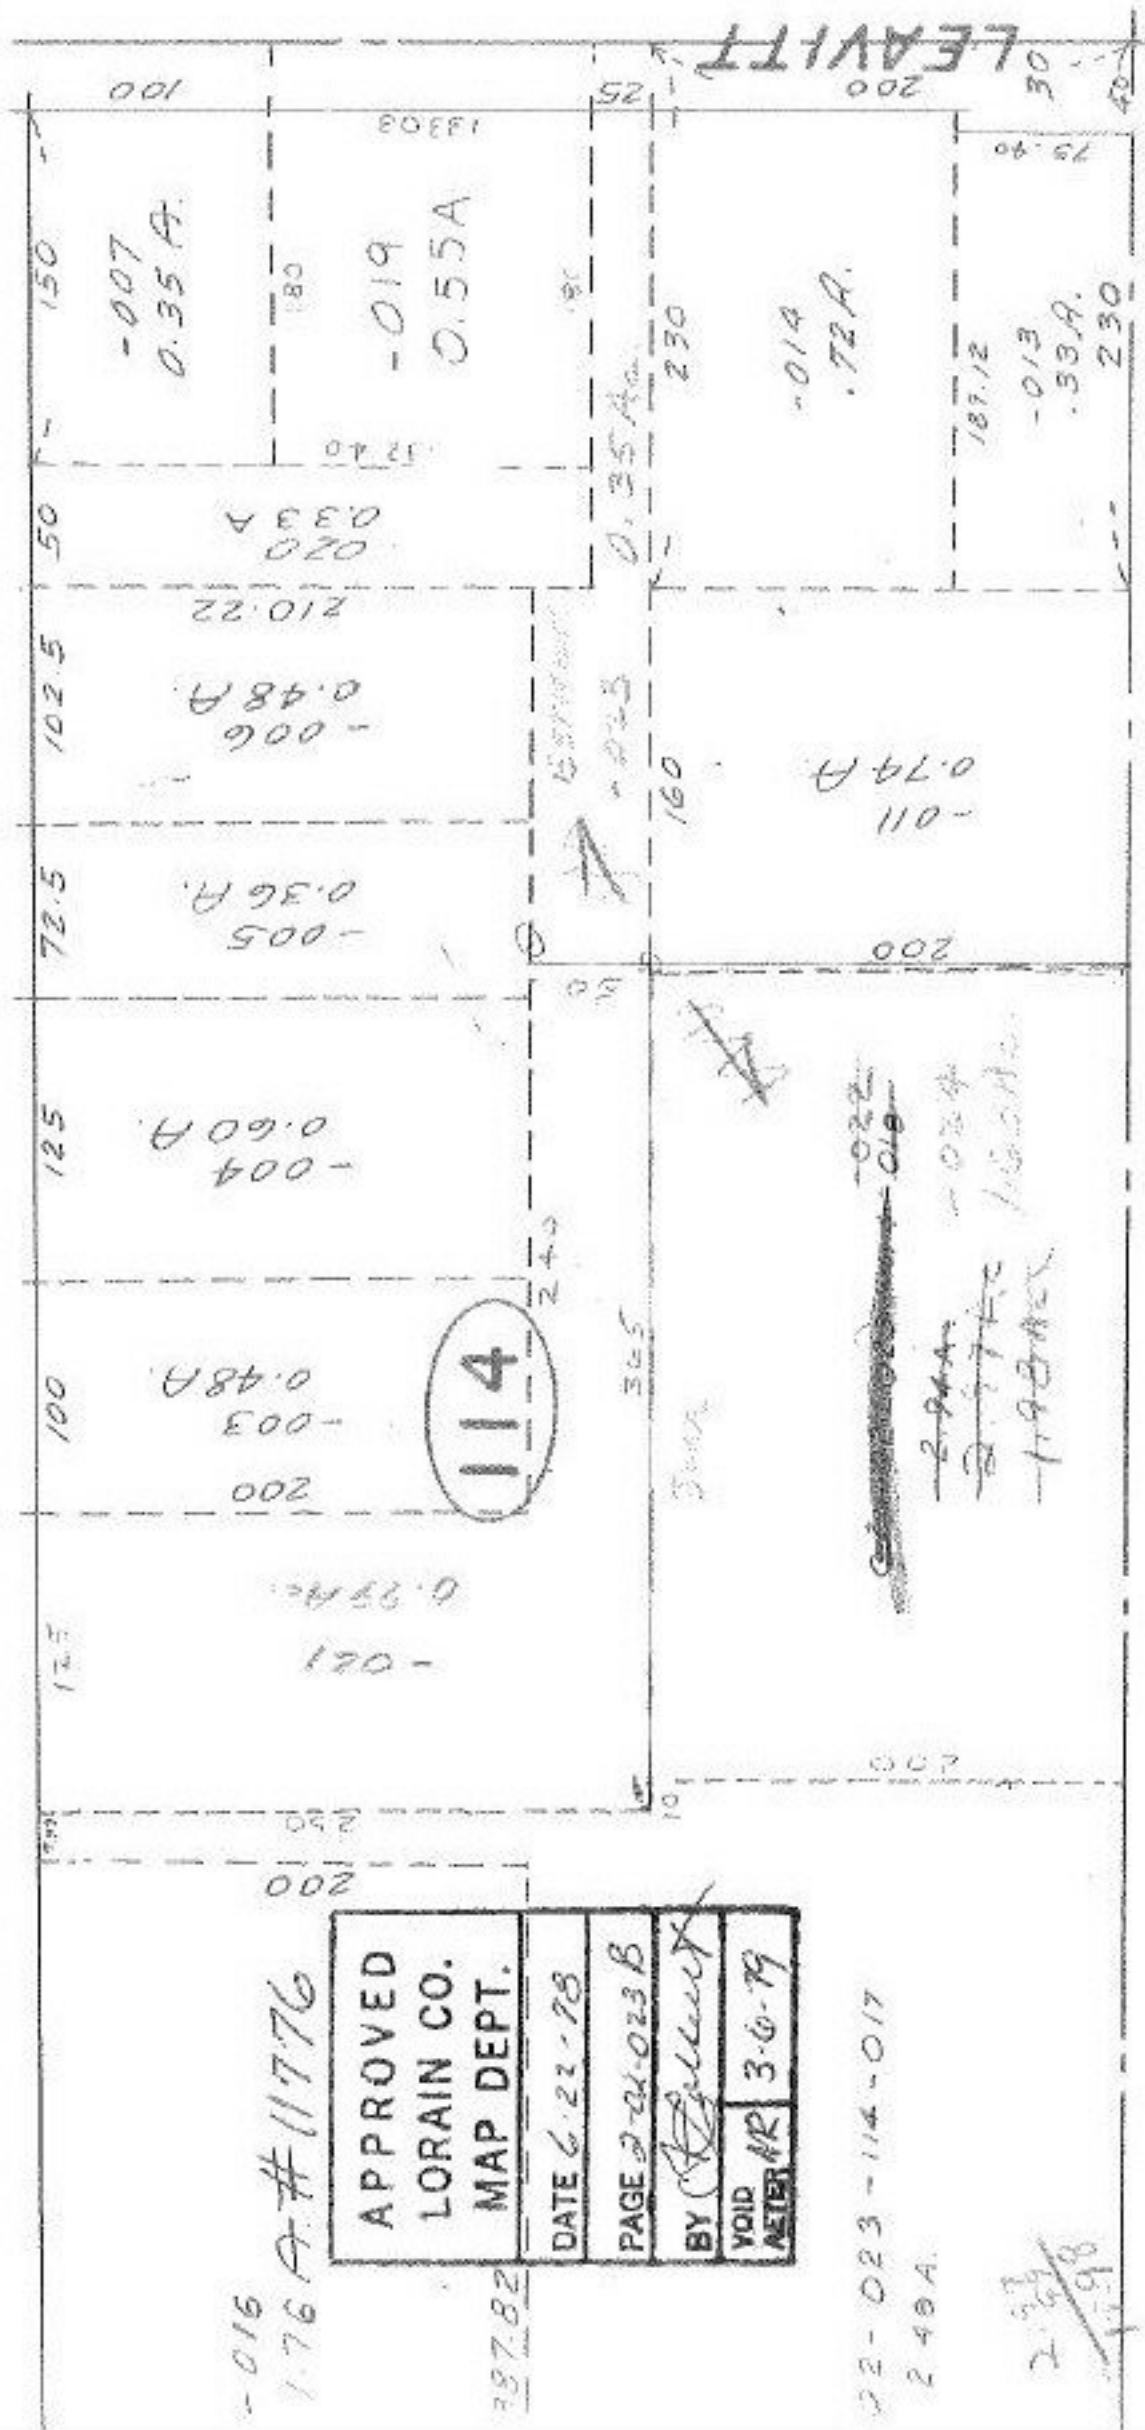

SEE 2-02-018-B

12.5