

#11778


57

APPROVED LORAIN CO. MAP DEPT.	
DATE 6-23-78	
PAGE 16-H	
BY T. McRain	
VOID AFTER	11778

RD. (60)

MAR 12 1979

-002  
39.69A. Dup.  
40.00A. Map.

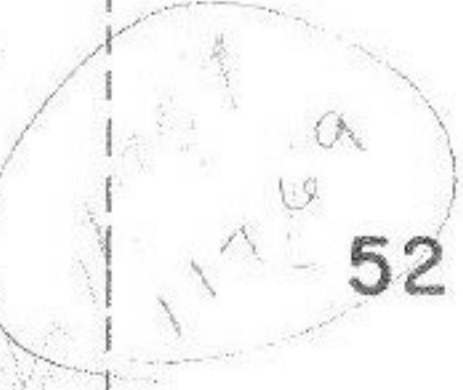

~~-003~~  
48.00A. Dup.  
47.69A. Map.

-004  
101.19A.

~~000~~  
~~005~~  
~~008~~  
71.76  
~~010~~  
69.98A

#11778

150	009	178A	150
517			

181.51  
120 - 003  
120.50A  
181.31

875.04

173.5

900 716.1  
00'

-003  
7.00A

340.25

340.25

173.5

170

Dup.  
Map