


#11783

APPROVED	
LORAIN CO.	
MAP DEPT.	
DATE	6-26-78
PAGE	5-00-099-0
BY	C. Francis
VOID AFTER	11783

06

-03A
-7.05A

THE

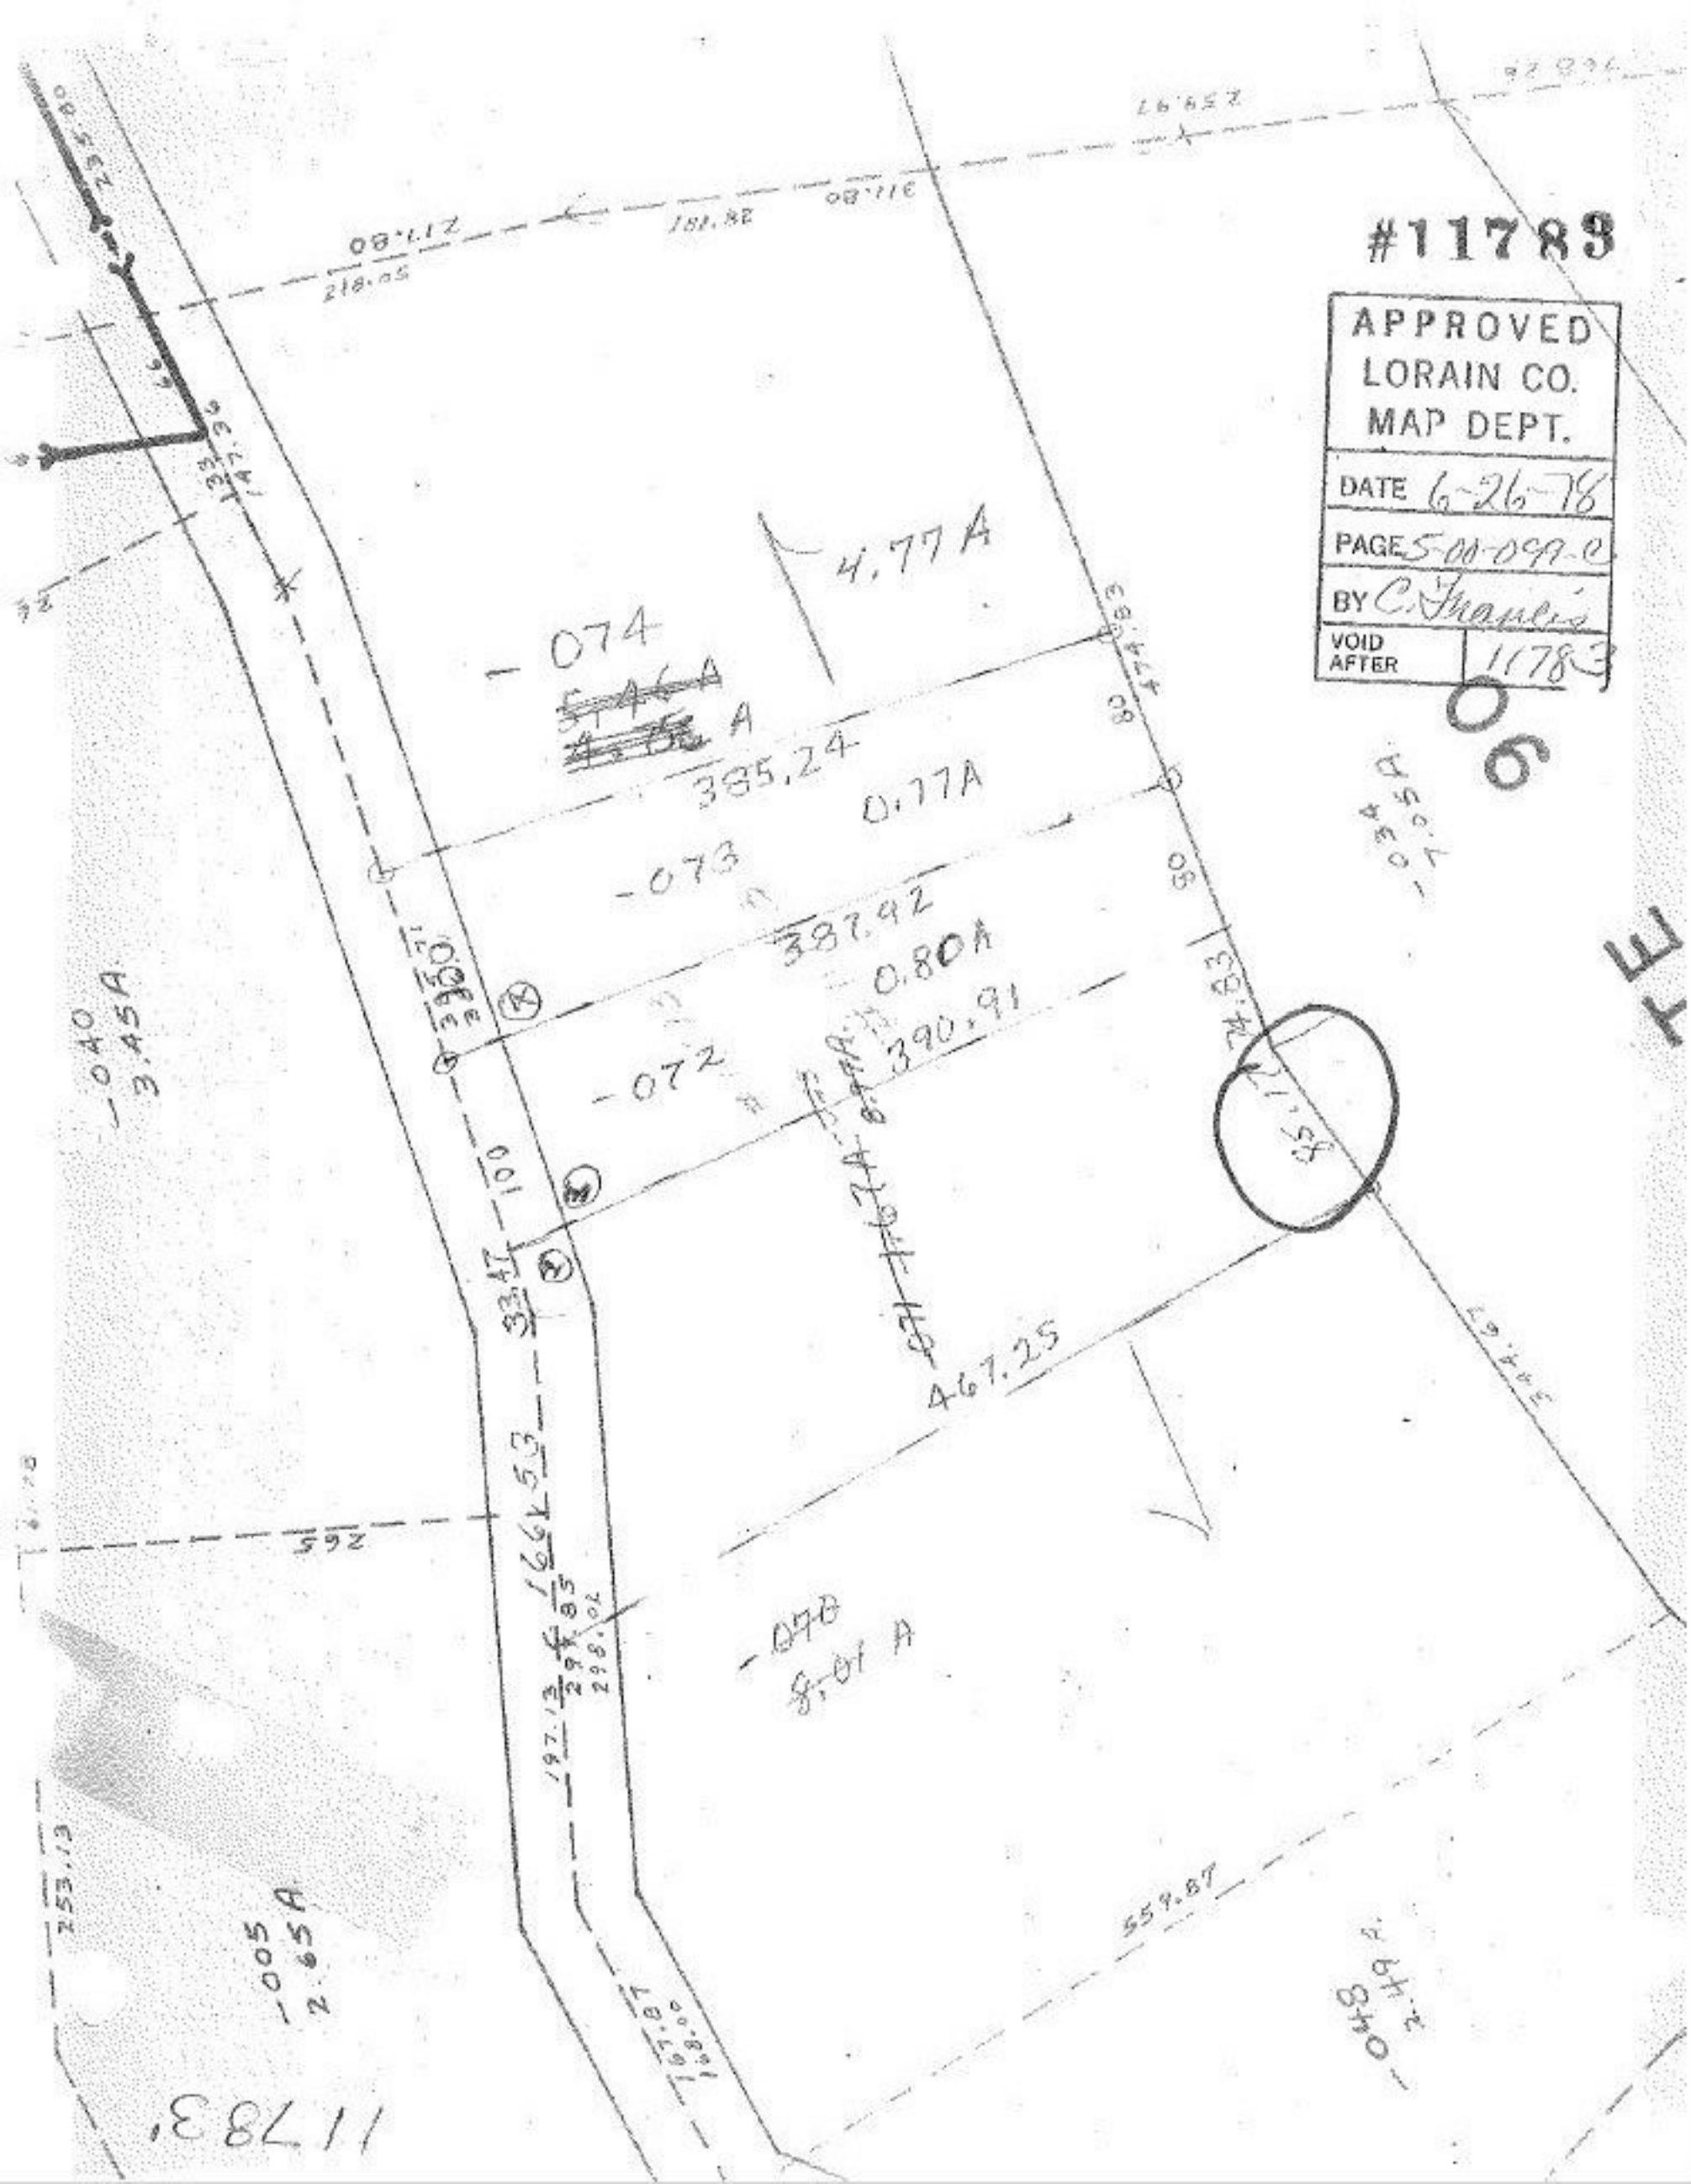

11783