

11791


RD.



BUTTERNUT RIDGE

N

COOK

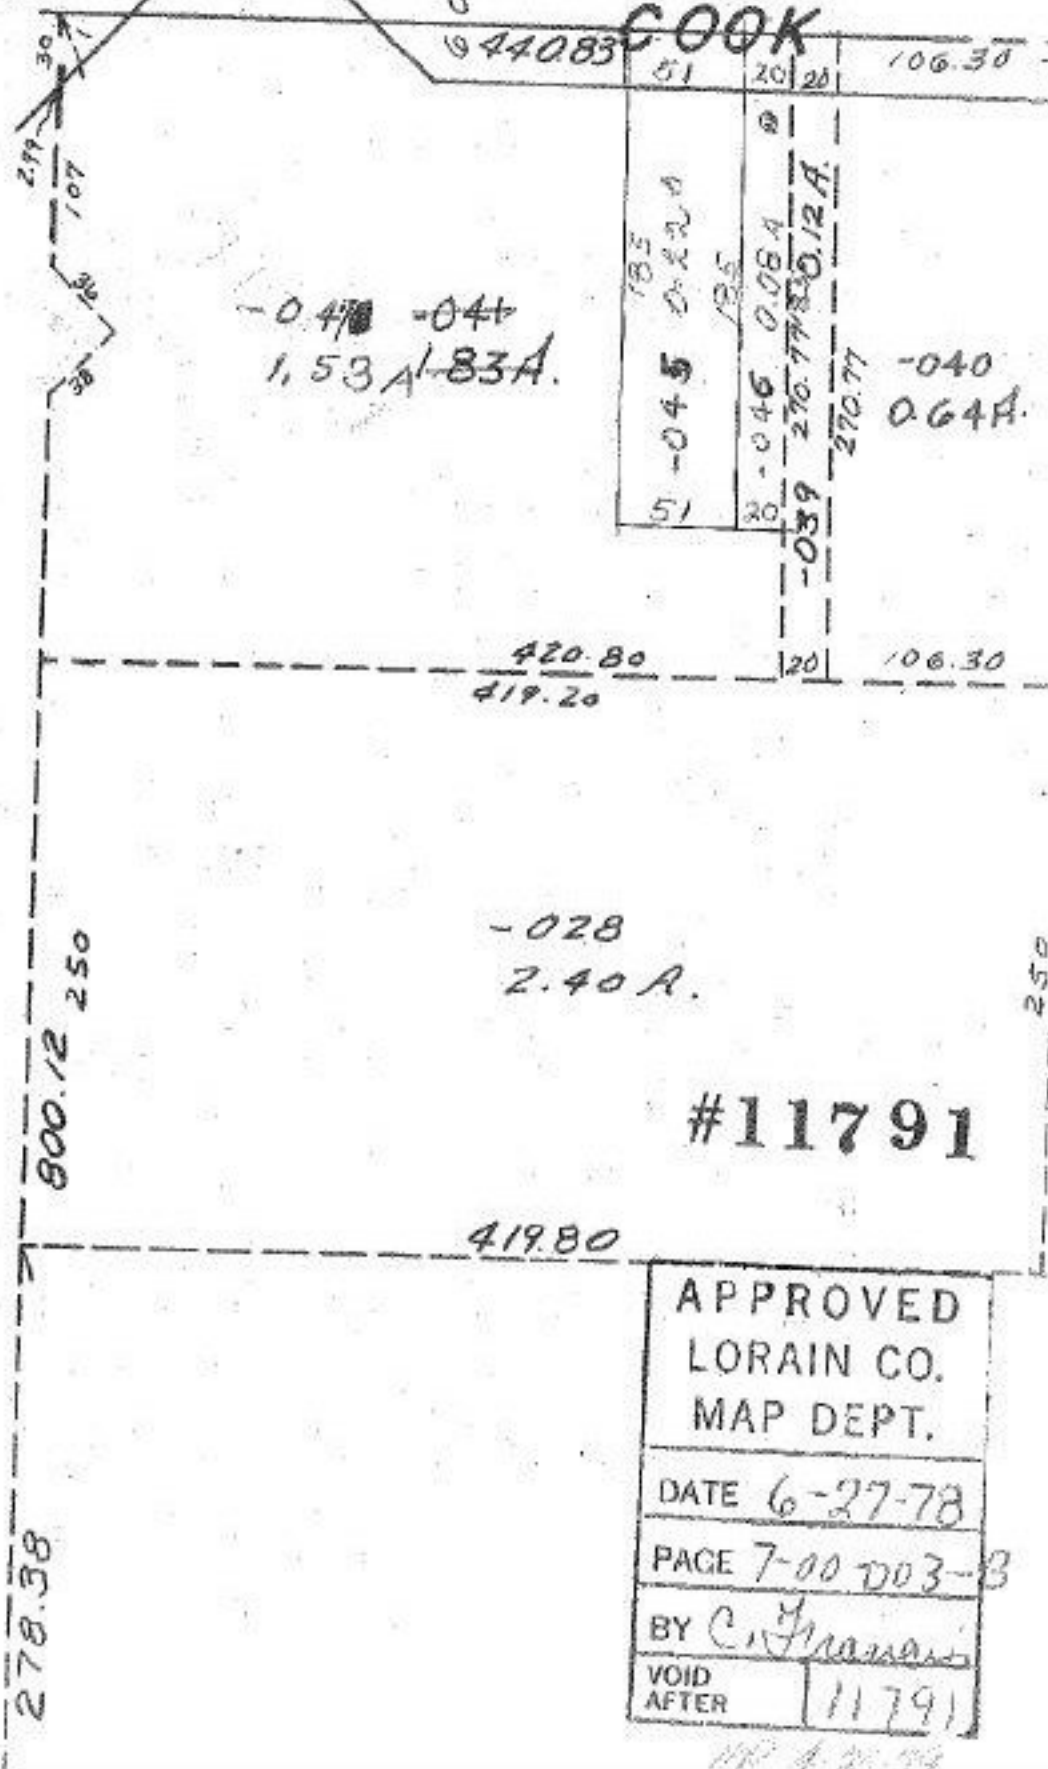

APPROVED
LORAIN CO.
MAP DEPT.

DATE 6-27-78

PAGE 7-00 003-3

BY C. Franzen

VOID AFTER 11791

MP 4-25-79