


107

SE

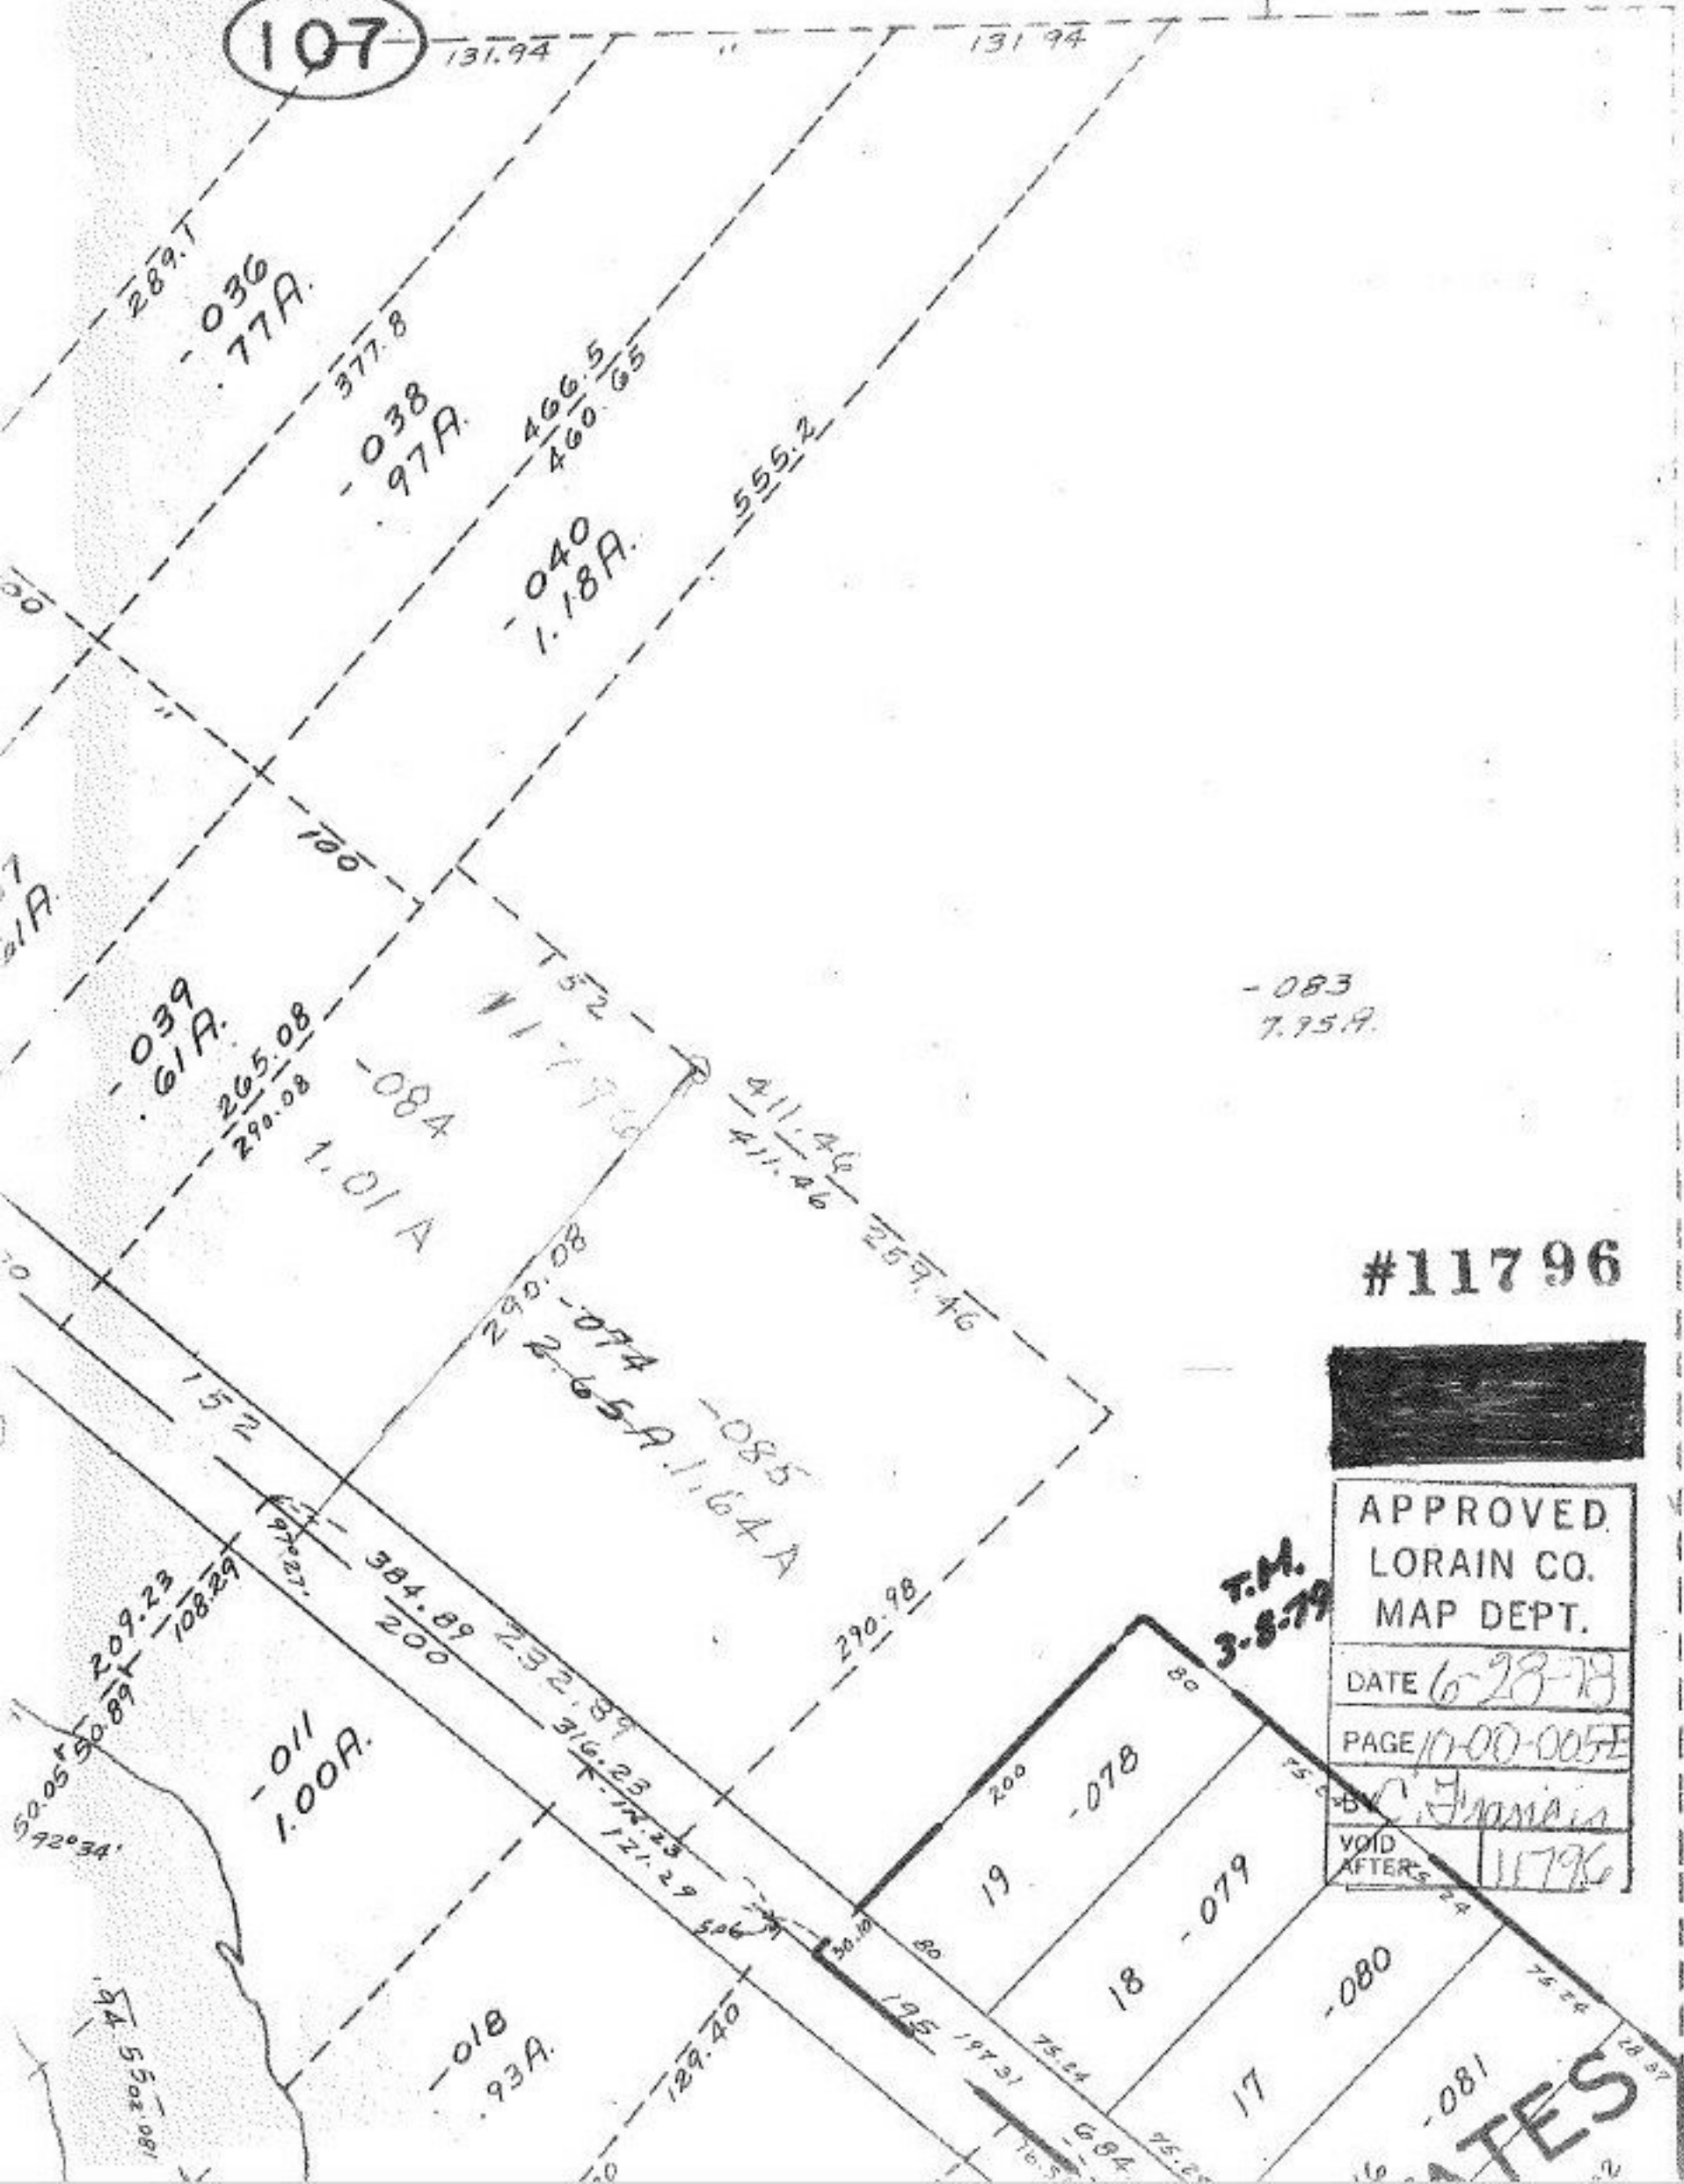

-083  
7.75A.

#11796



APPROVED.  
LORAIN CO.  
MAP DEPT.

DATE 6-28-78

PAGE 10-00-005E

BY C. Francis

VOID AFTER 11796

T.M.  
3-8-79

DATES