


11808

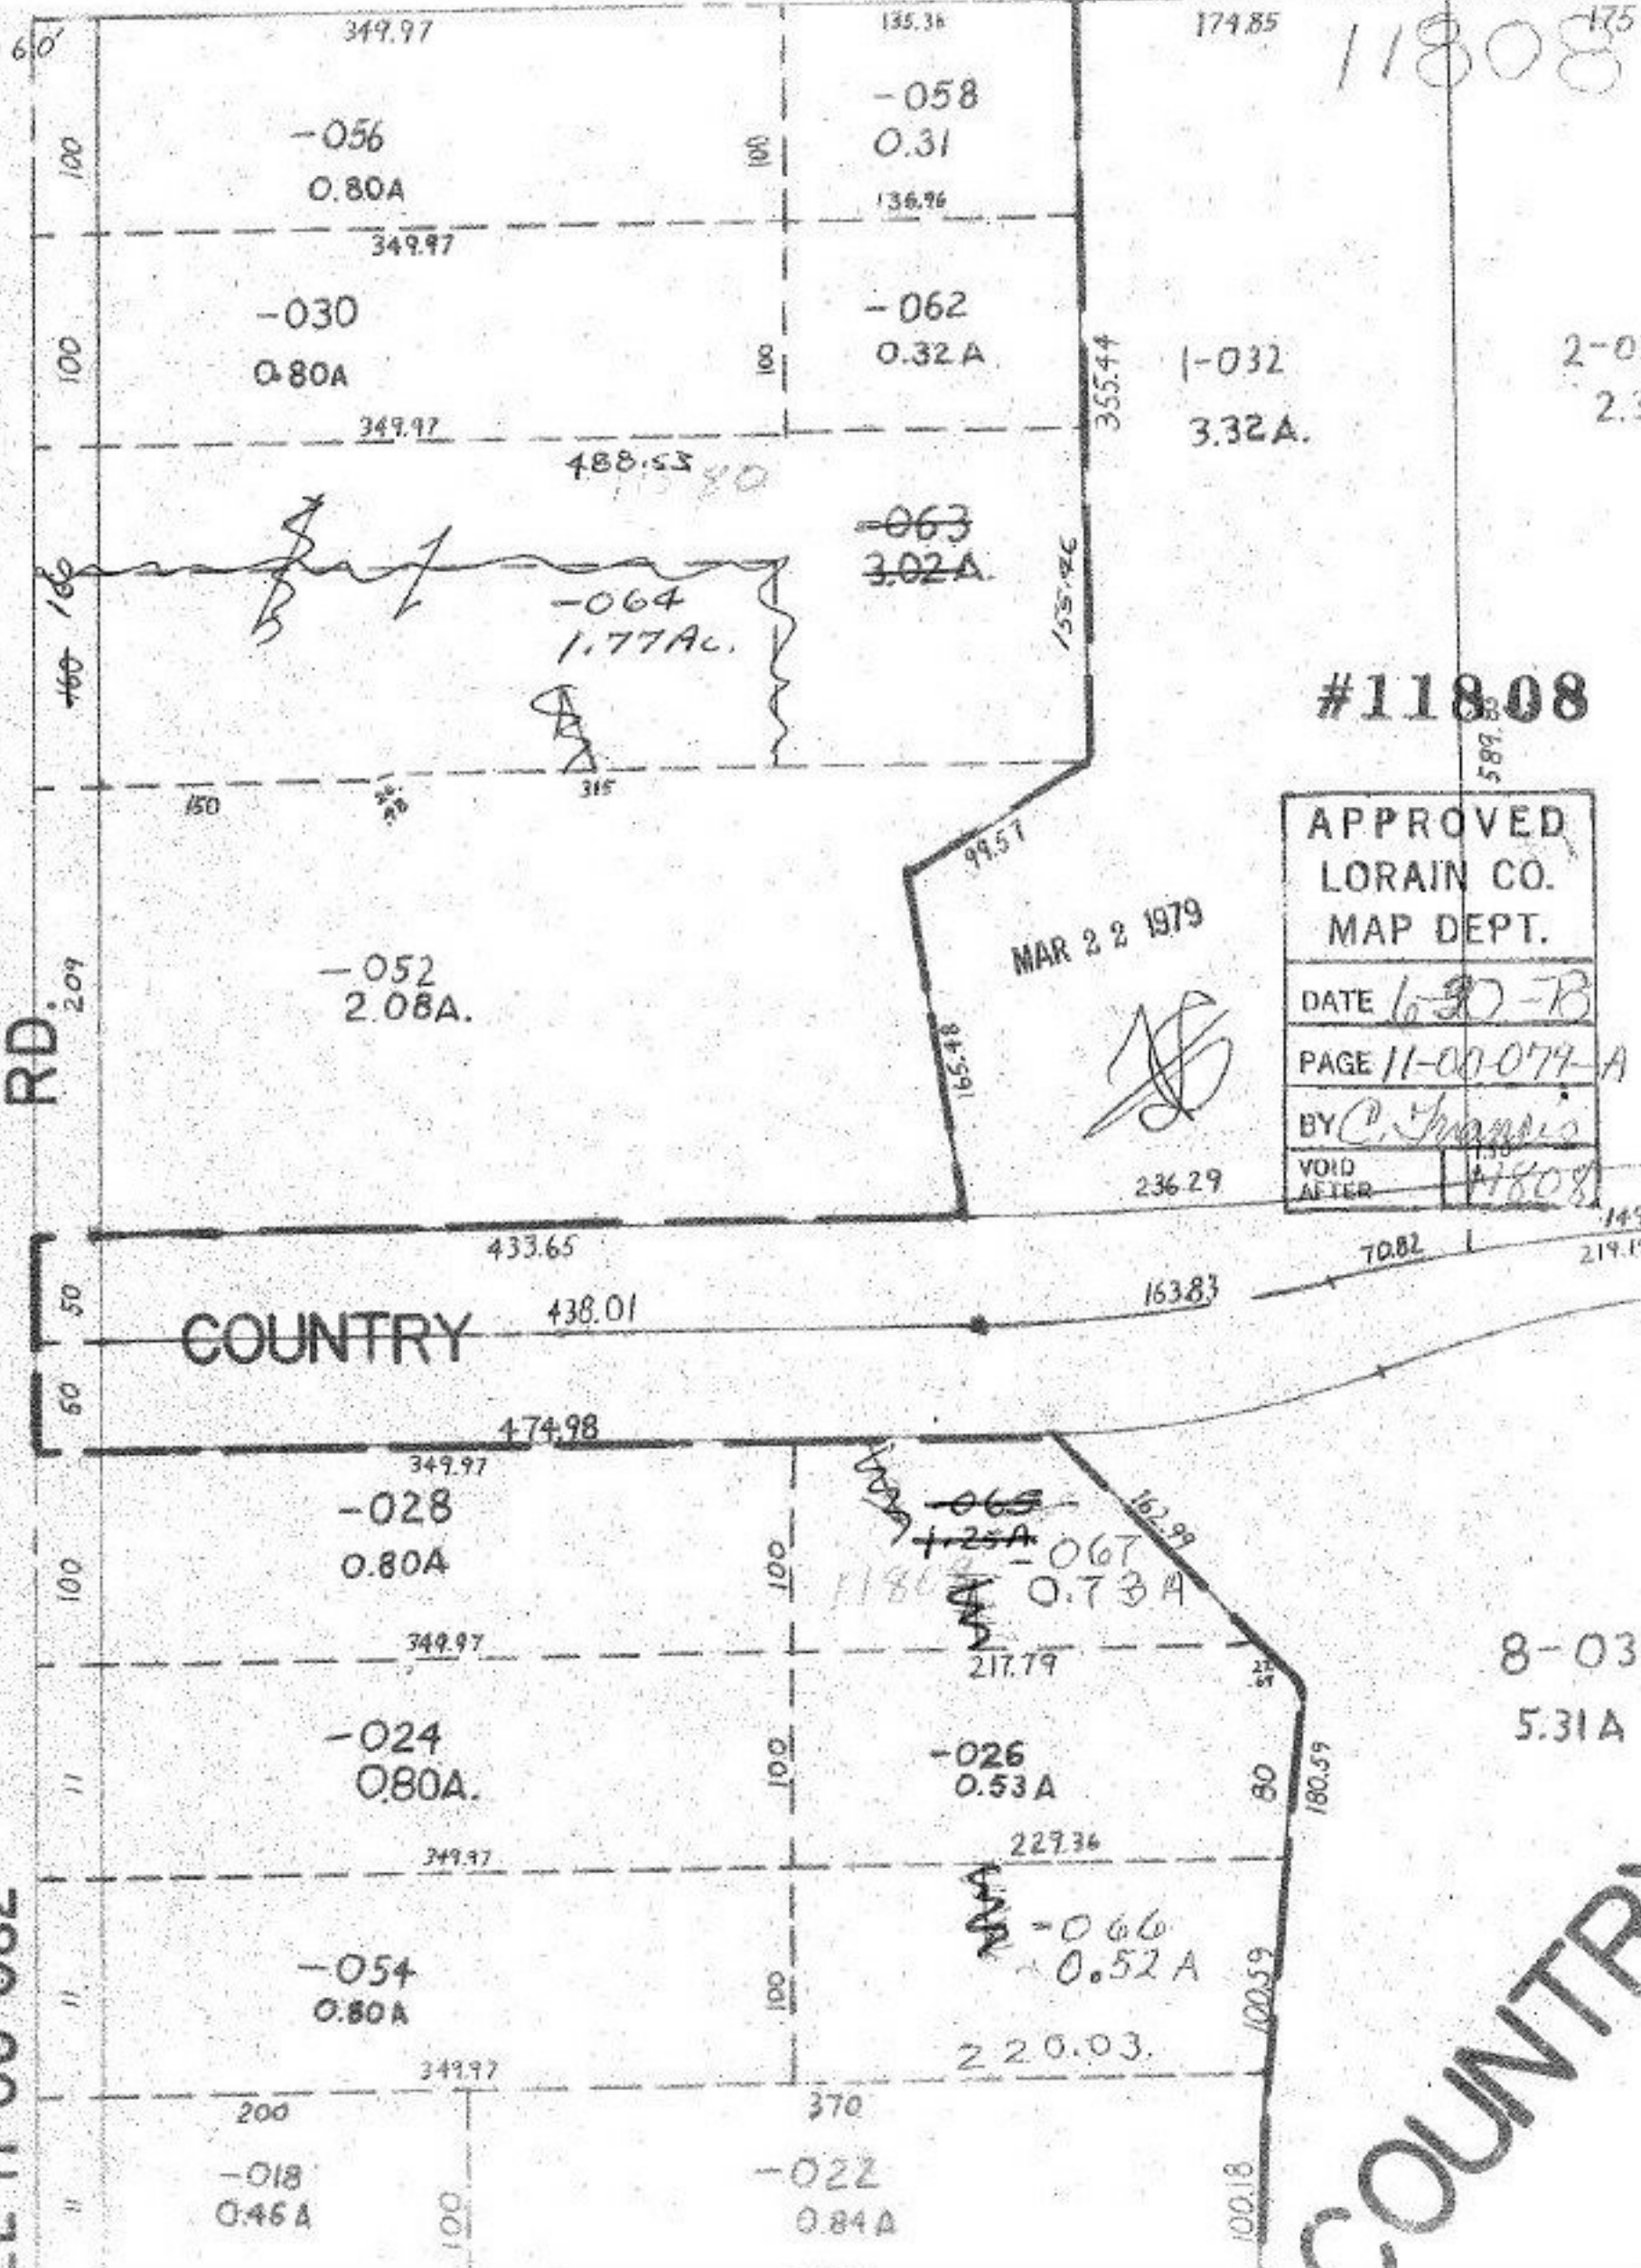

#11808

APPROVED LORAIN CO. MAP DEPT.	
DATE	6-30-78
PAGE	11-00-077-A
BY	C. Francis
VOID AFTER	11808

MAR 22 1979

[Handwritten Signature]

236.29

COUNTRY

COUNTRY

EE 11-00-082

RD