


#11826

E

Page 2-E

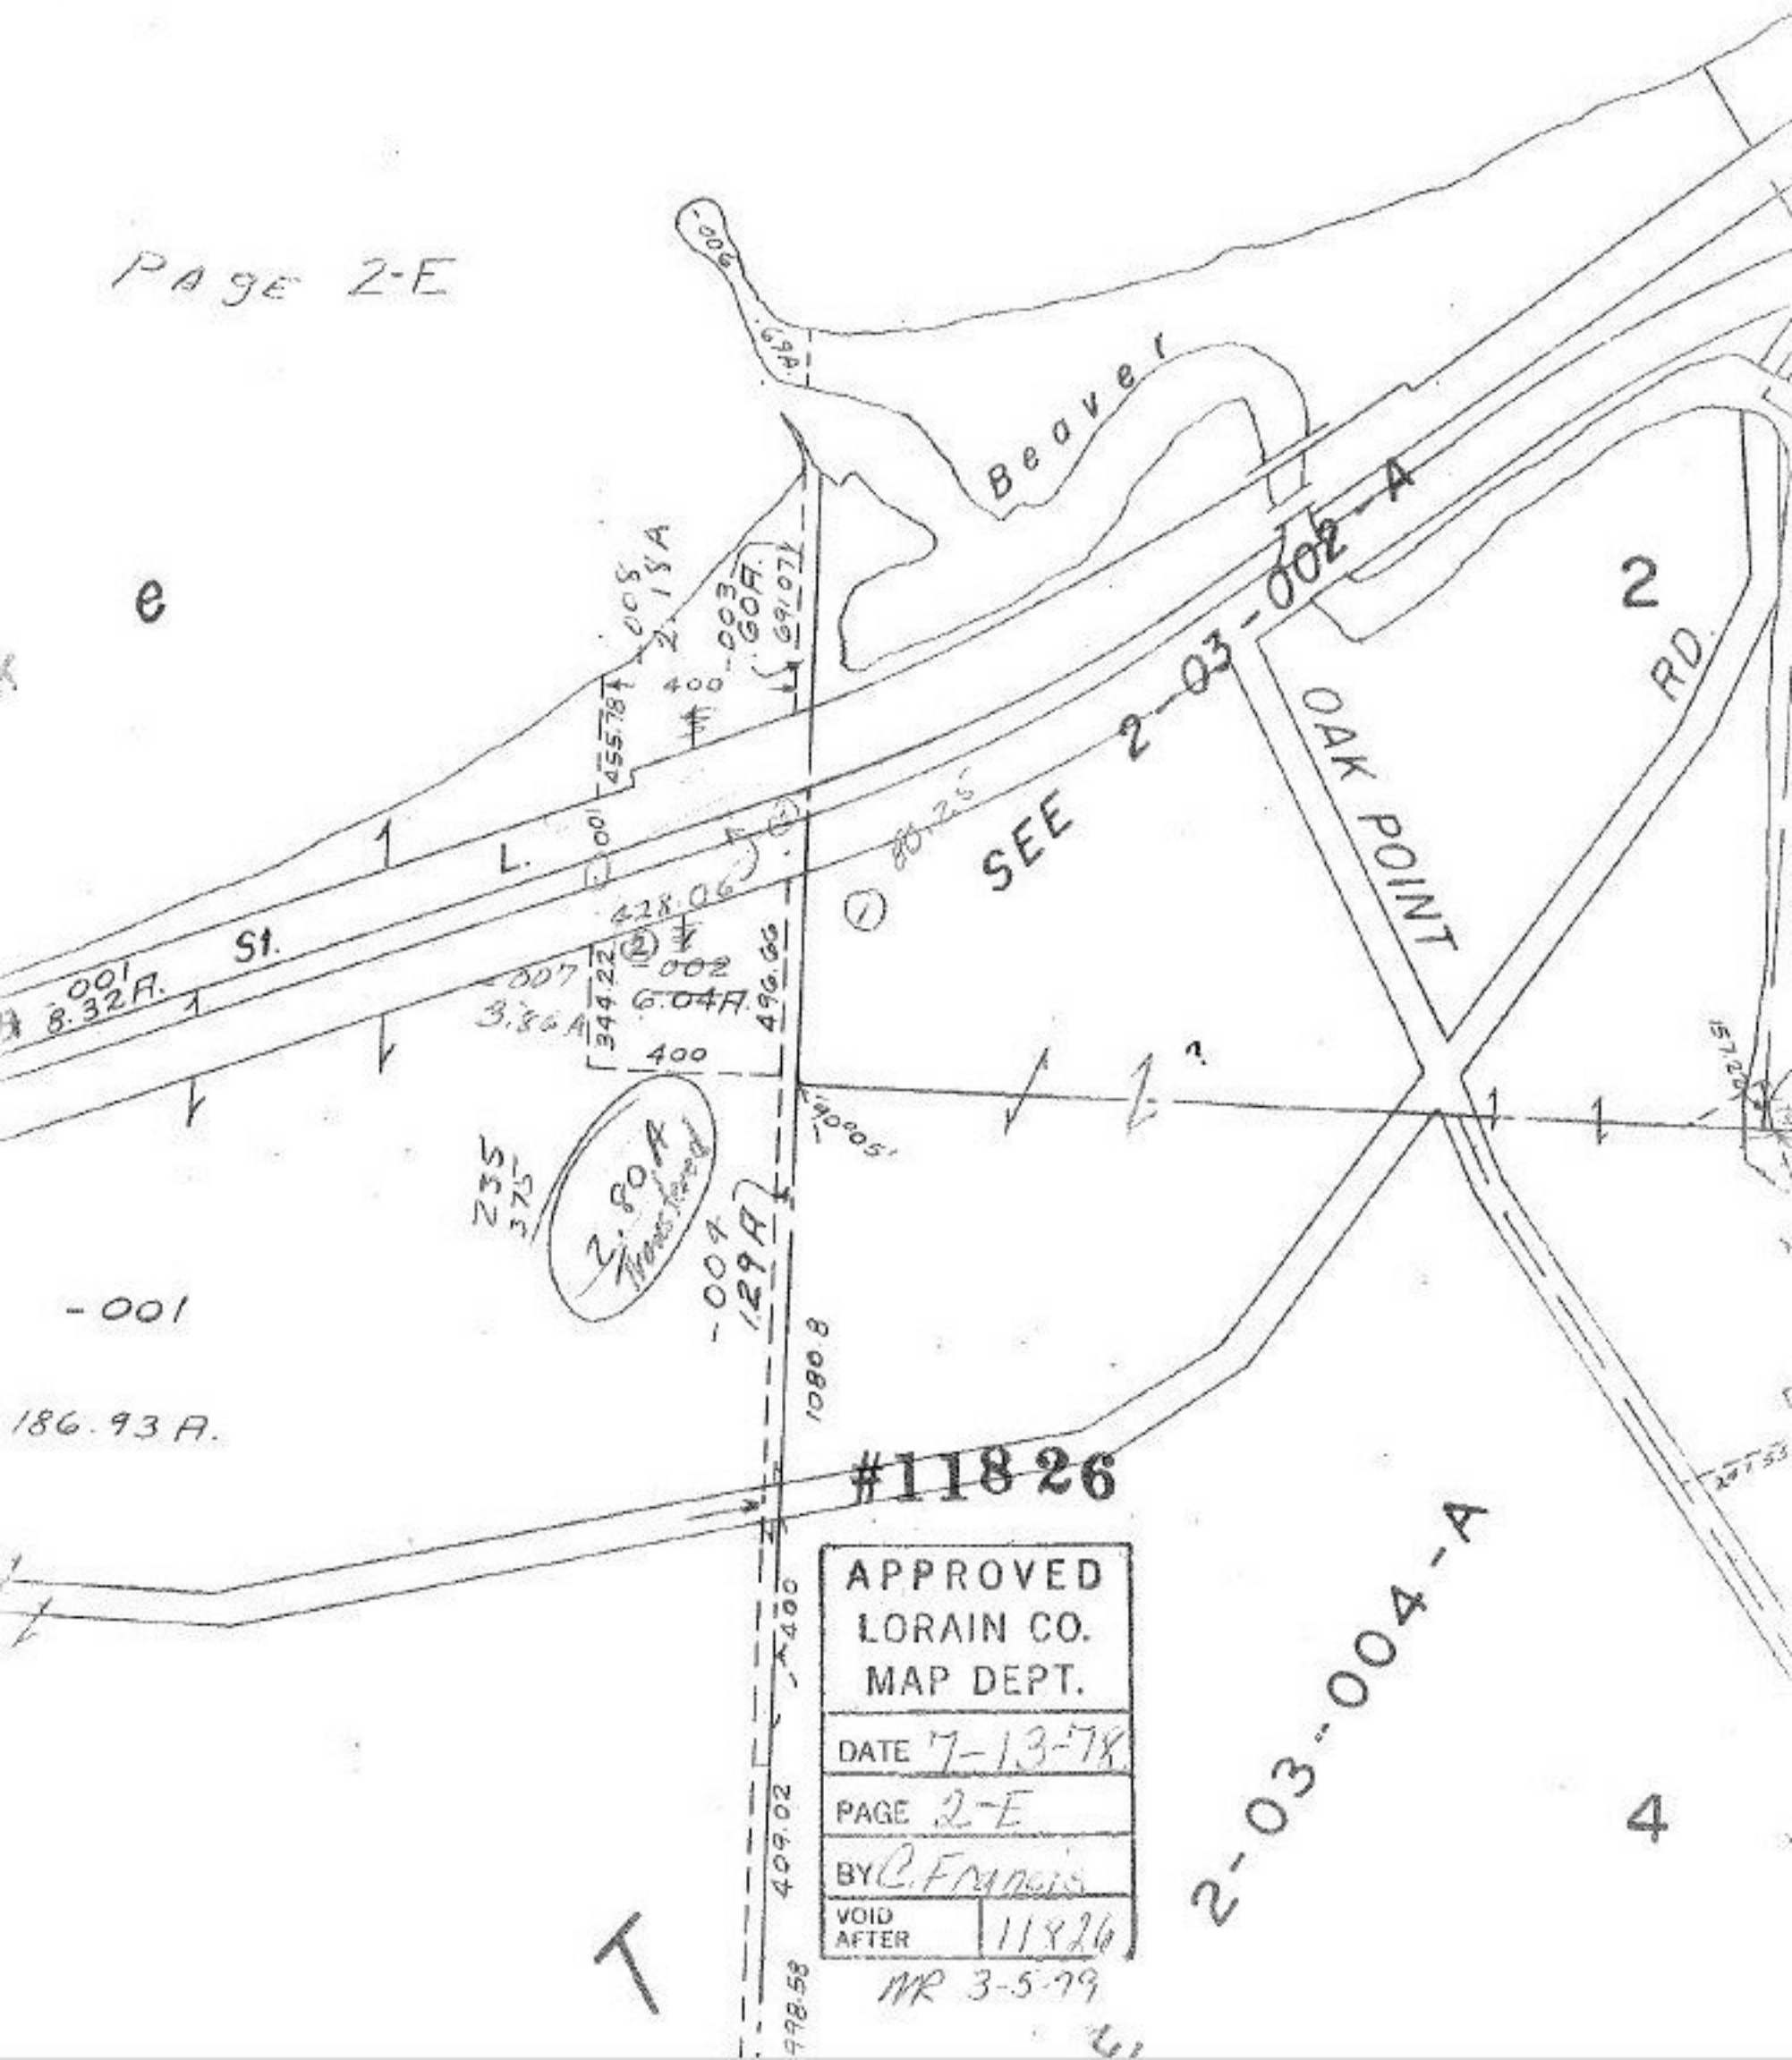

e

2

RD.

SEE 2-03-002-A

OAK POINT

001
8.32A

St.

235
375
2.80A
Transferred

-001

186.93A

#11826

APPROVED	
LORAIN CO.	
MAP DEPT.	
DATE	7-13-78
PAGE	2-E
BY	C. Francis
VOID AFTER	11826

NR 3-5-79

2-03-004-A

4

T