


11828



#11828

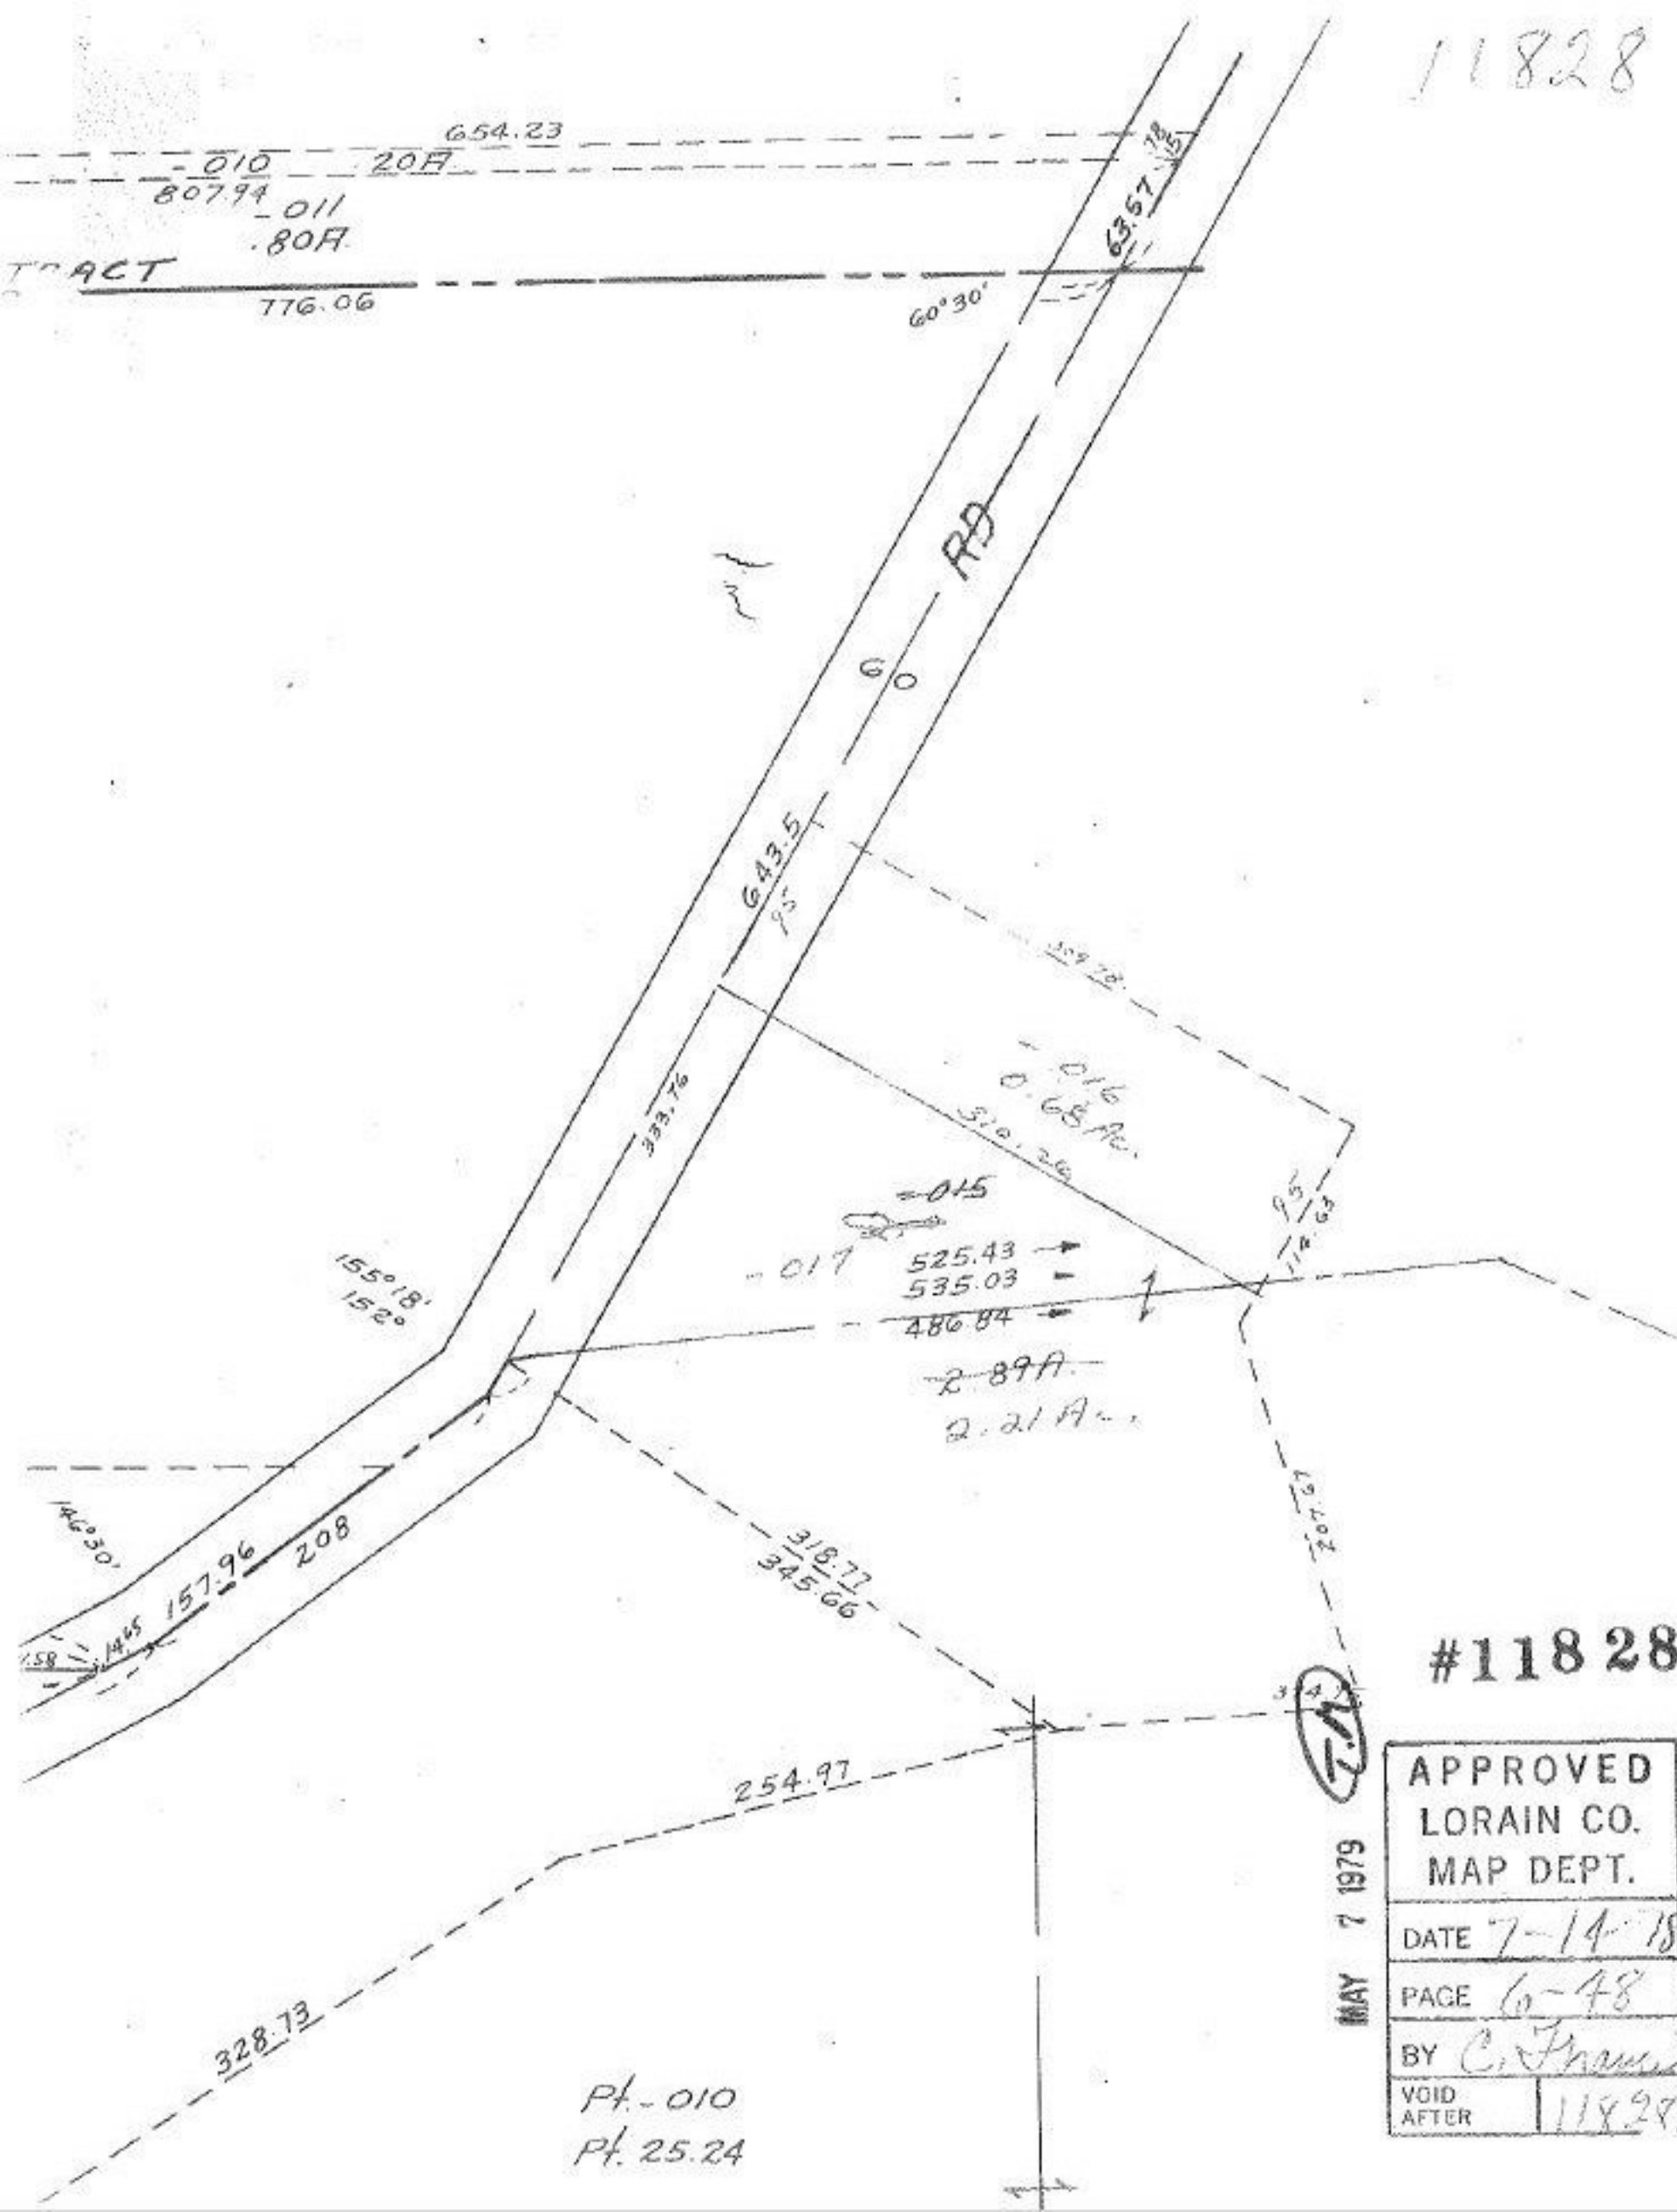

MAY 7 1979

APPROVED LORAIN CO. MAP DEPT.	
DATE 7-14-78	
PAGE 6-48	
BY C. Frawley	
VOID AFTER	11828

Pt. - 010
Pt. 25.24