


SE 11835

23

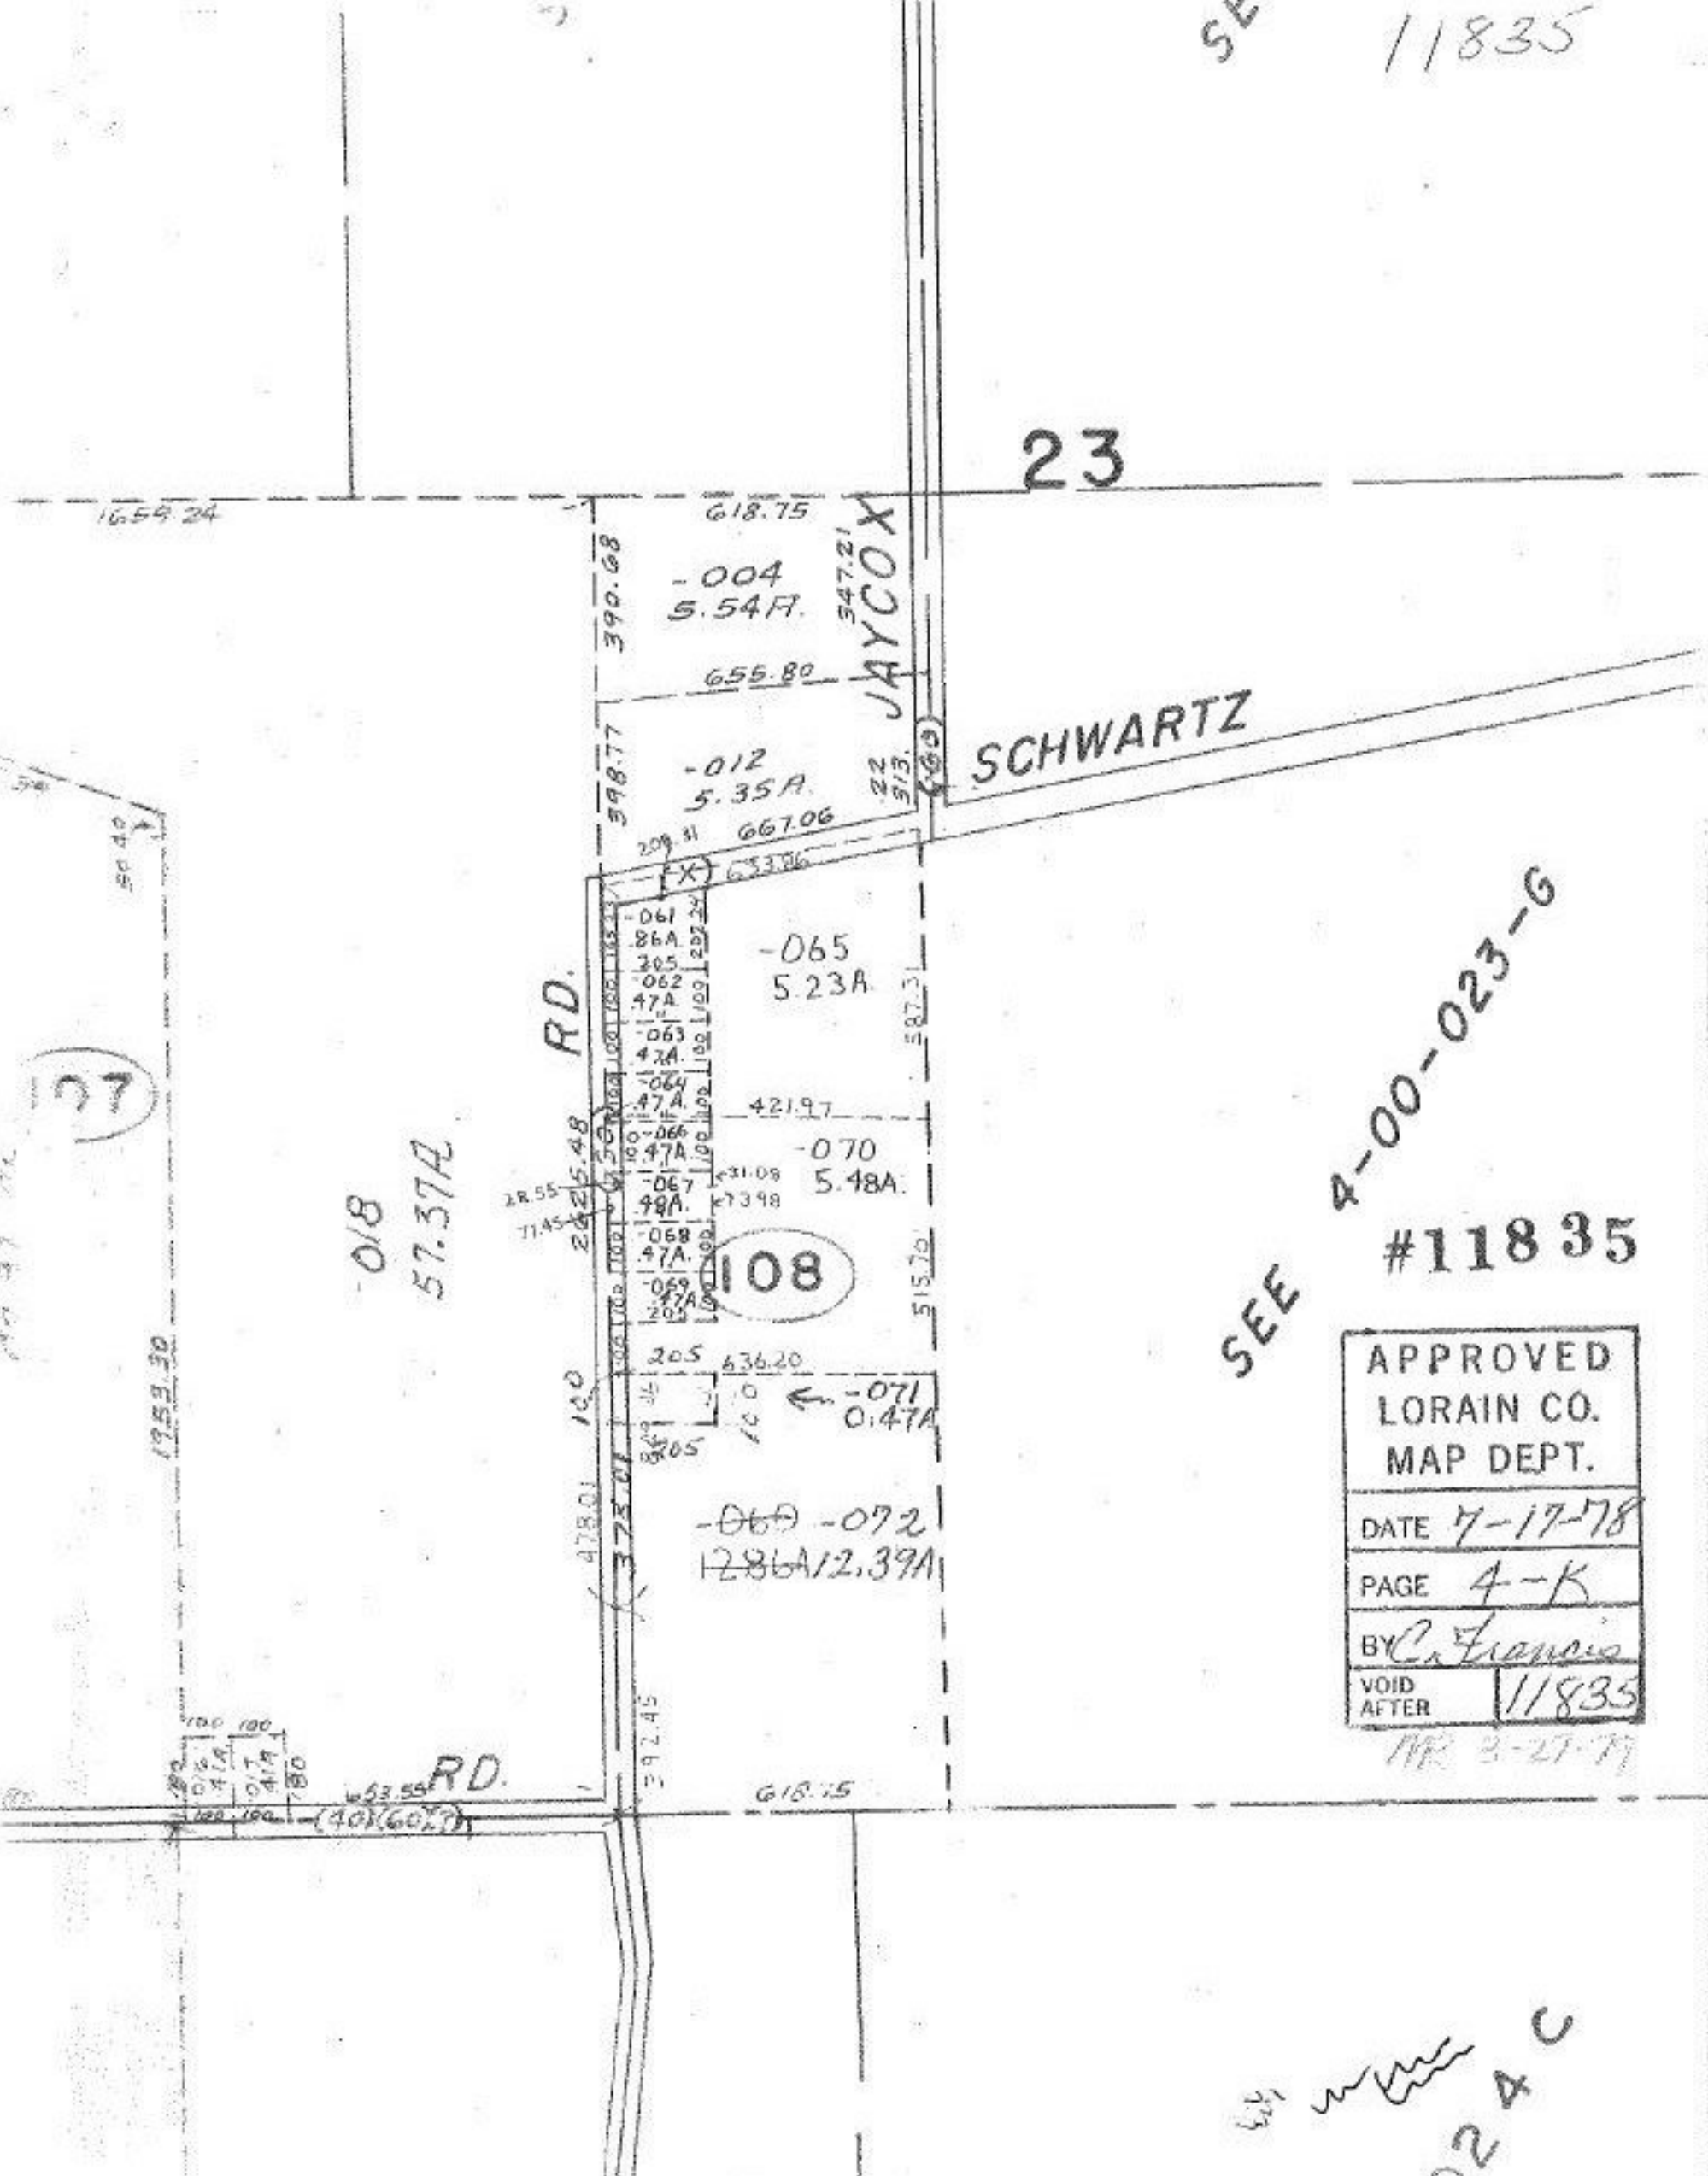

SEE 4-00-023-G  
#11835

APPROVED
LORAIN CO.
MAP DEPT.
DATE 7-17-78
PAGE 4-K
BY C. Francis
VOID AFTER 11835

MAR 3-27-79

024C