


11837

MOORE

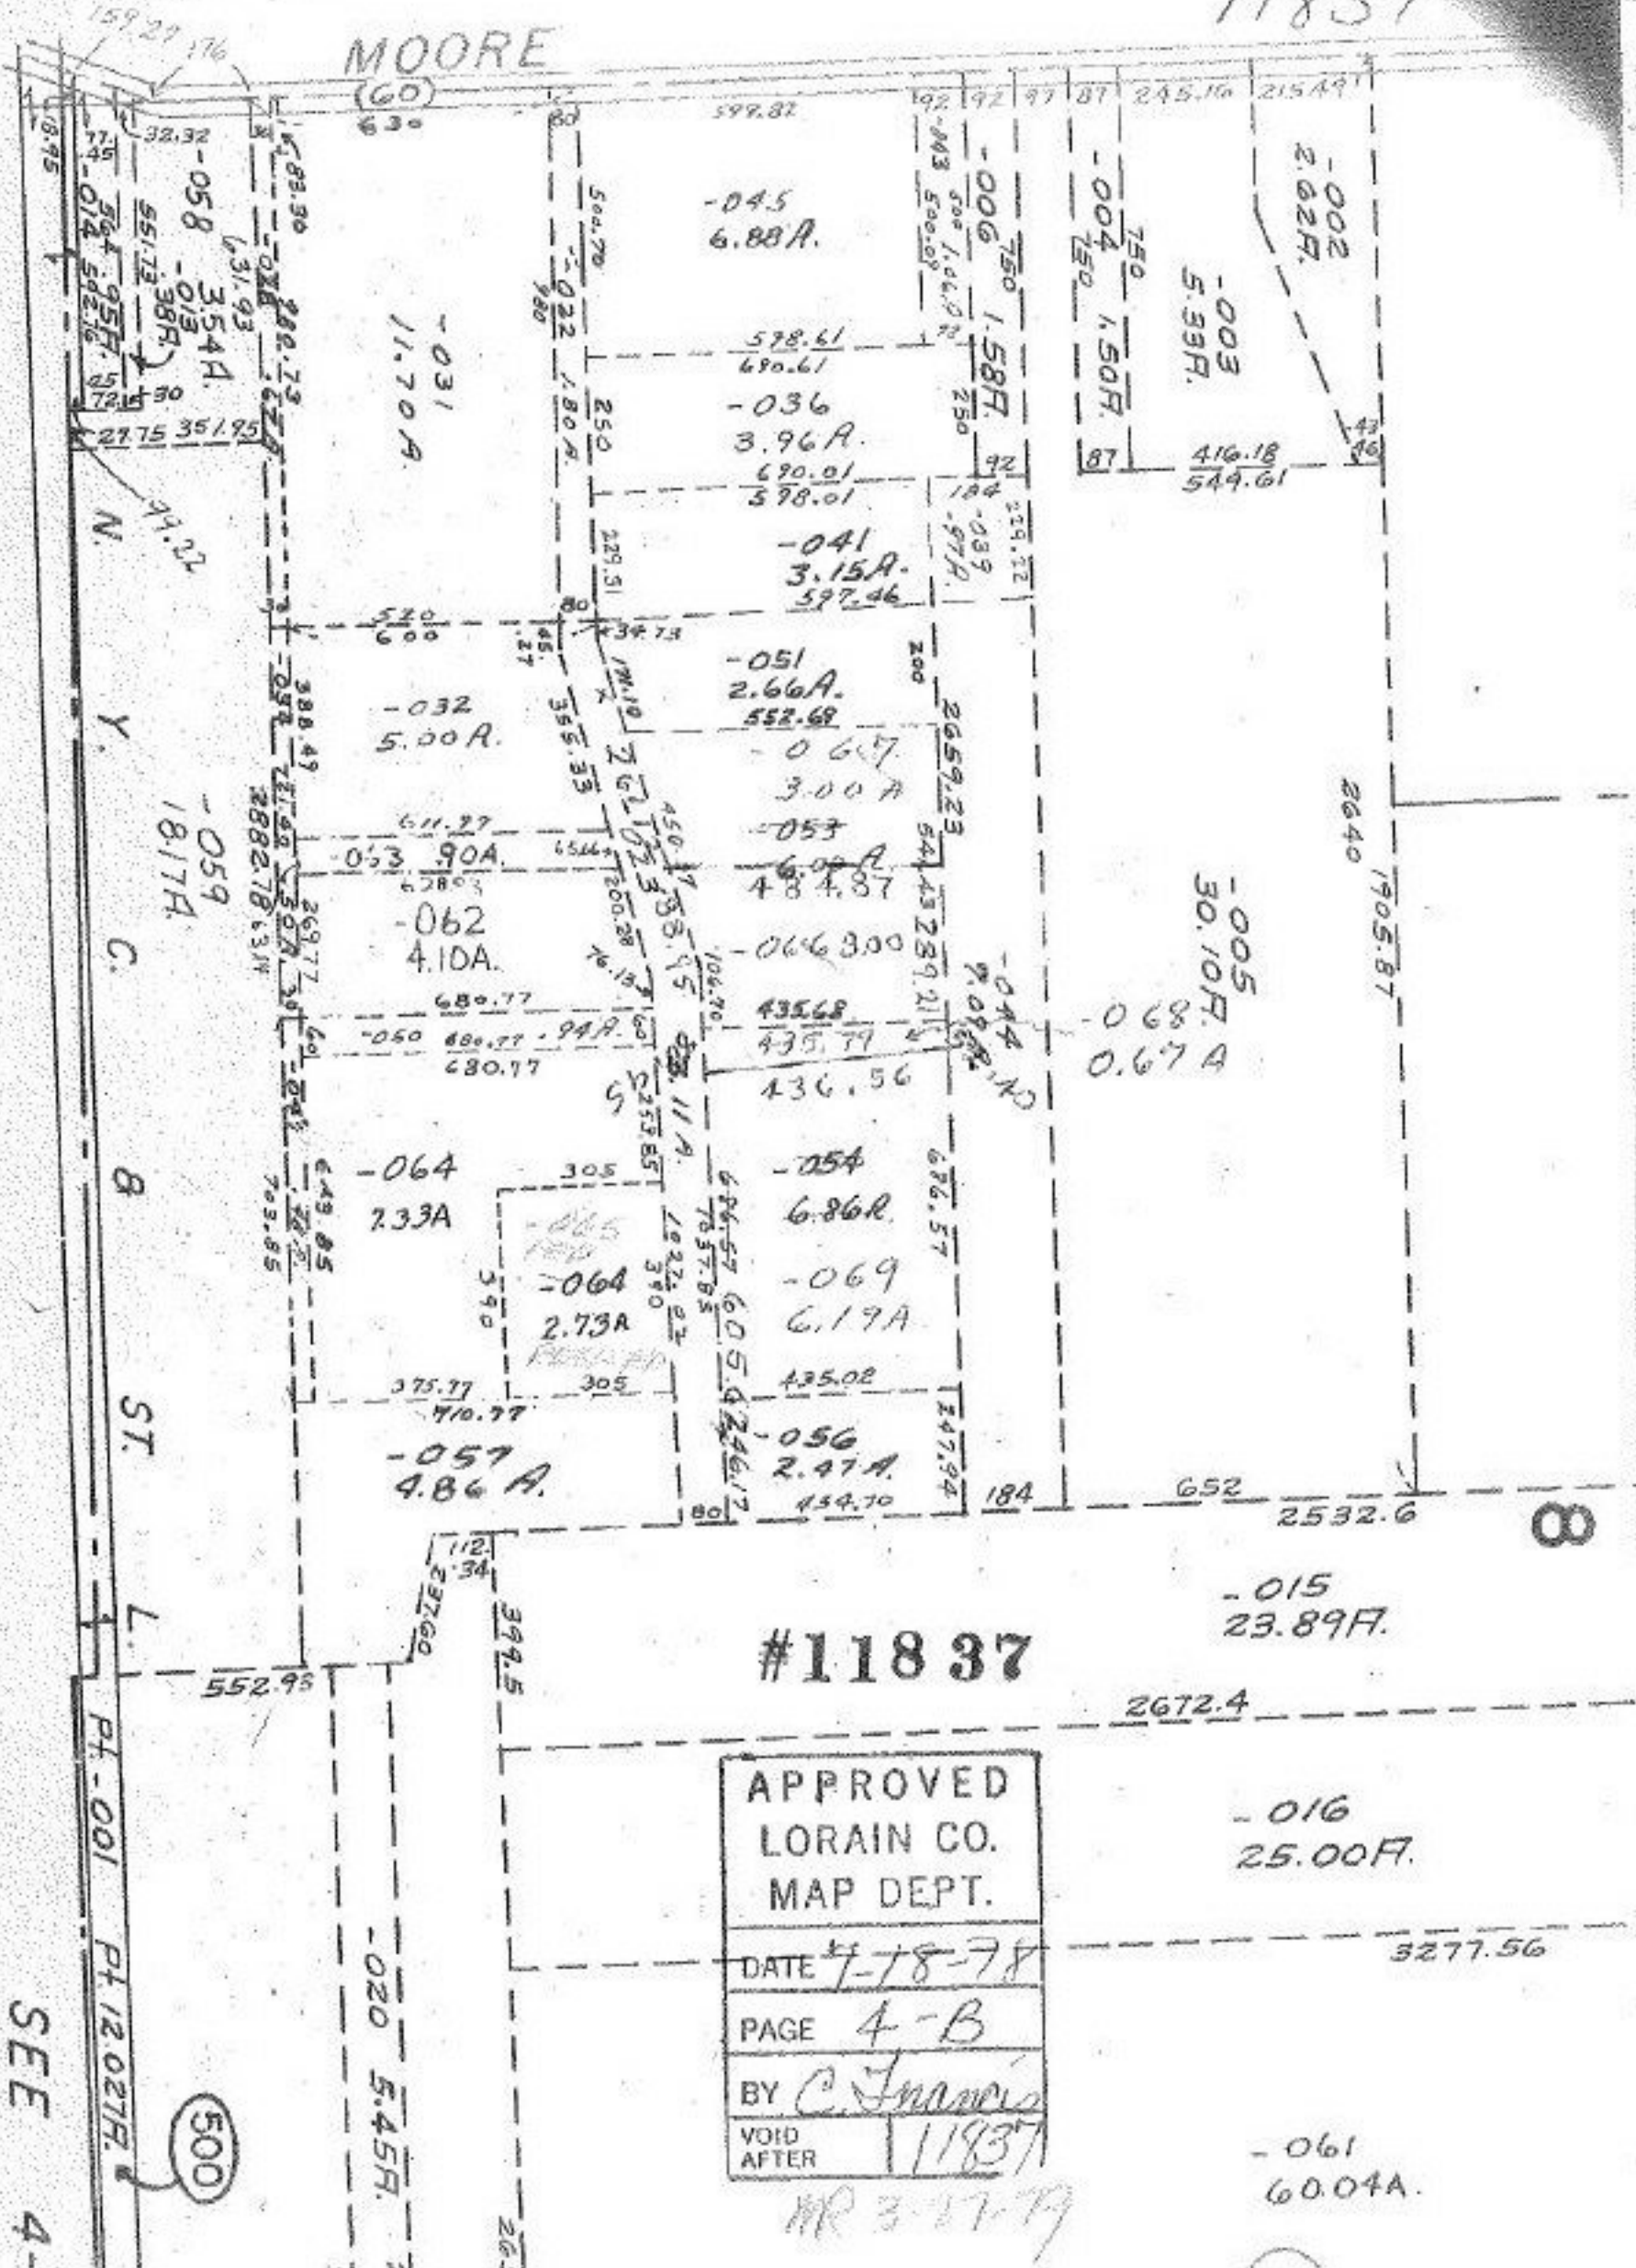

#11837

APPROVED  
LORAIN CO.  
MAP DEPT.

DATE 4-18-78

PAGE 4-B

BY C. Francis

VOID AFTER 11837

MR 3-27-79

SEE 4-

500

8