


SEE 2-01-003-J

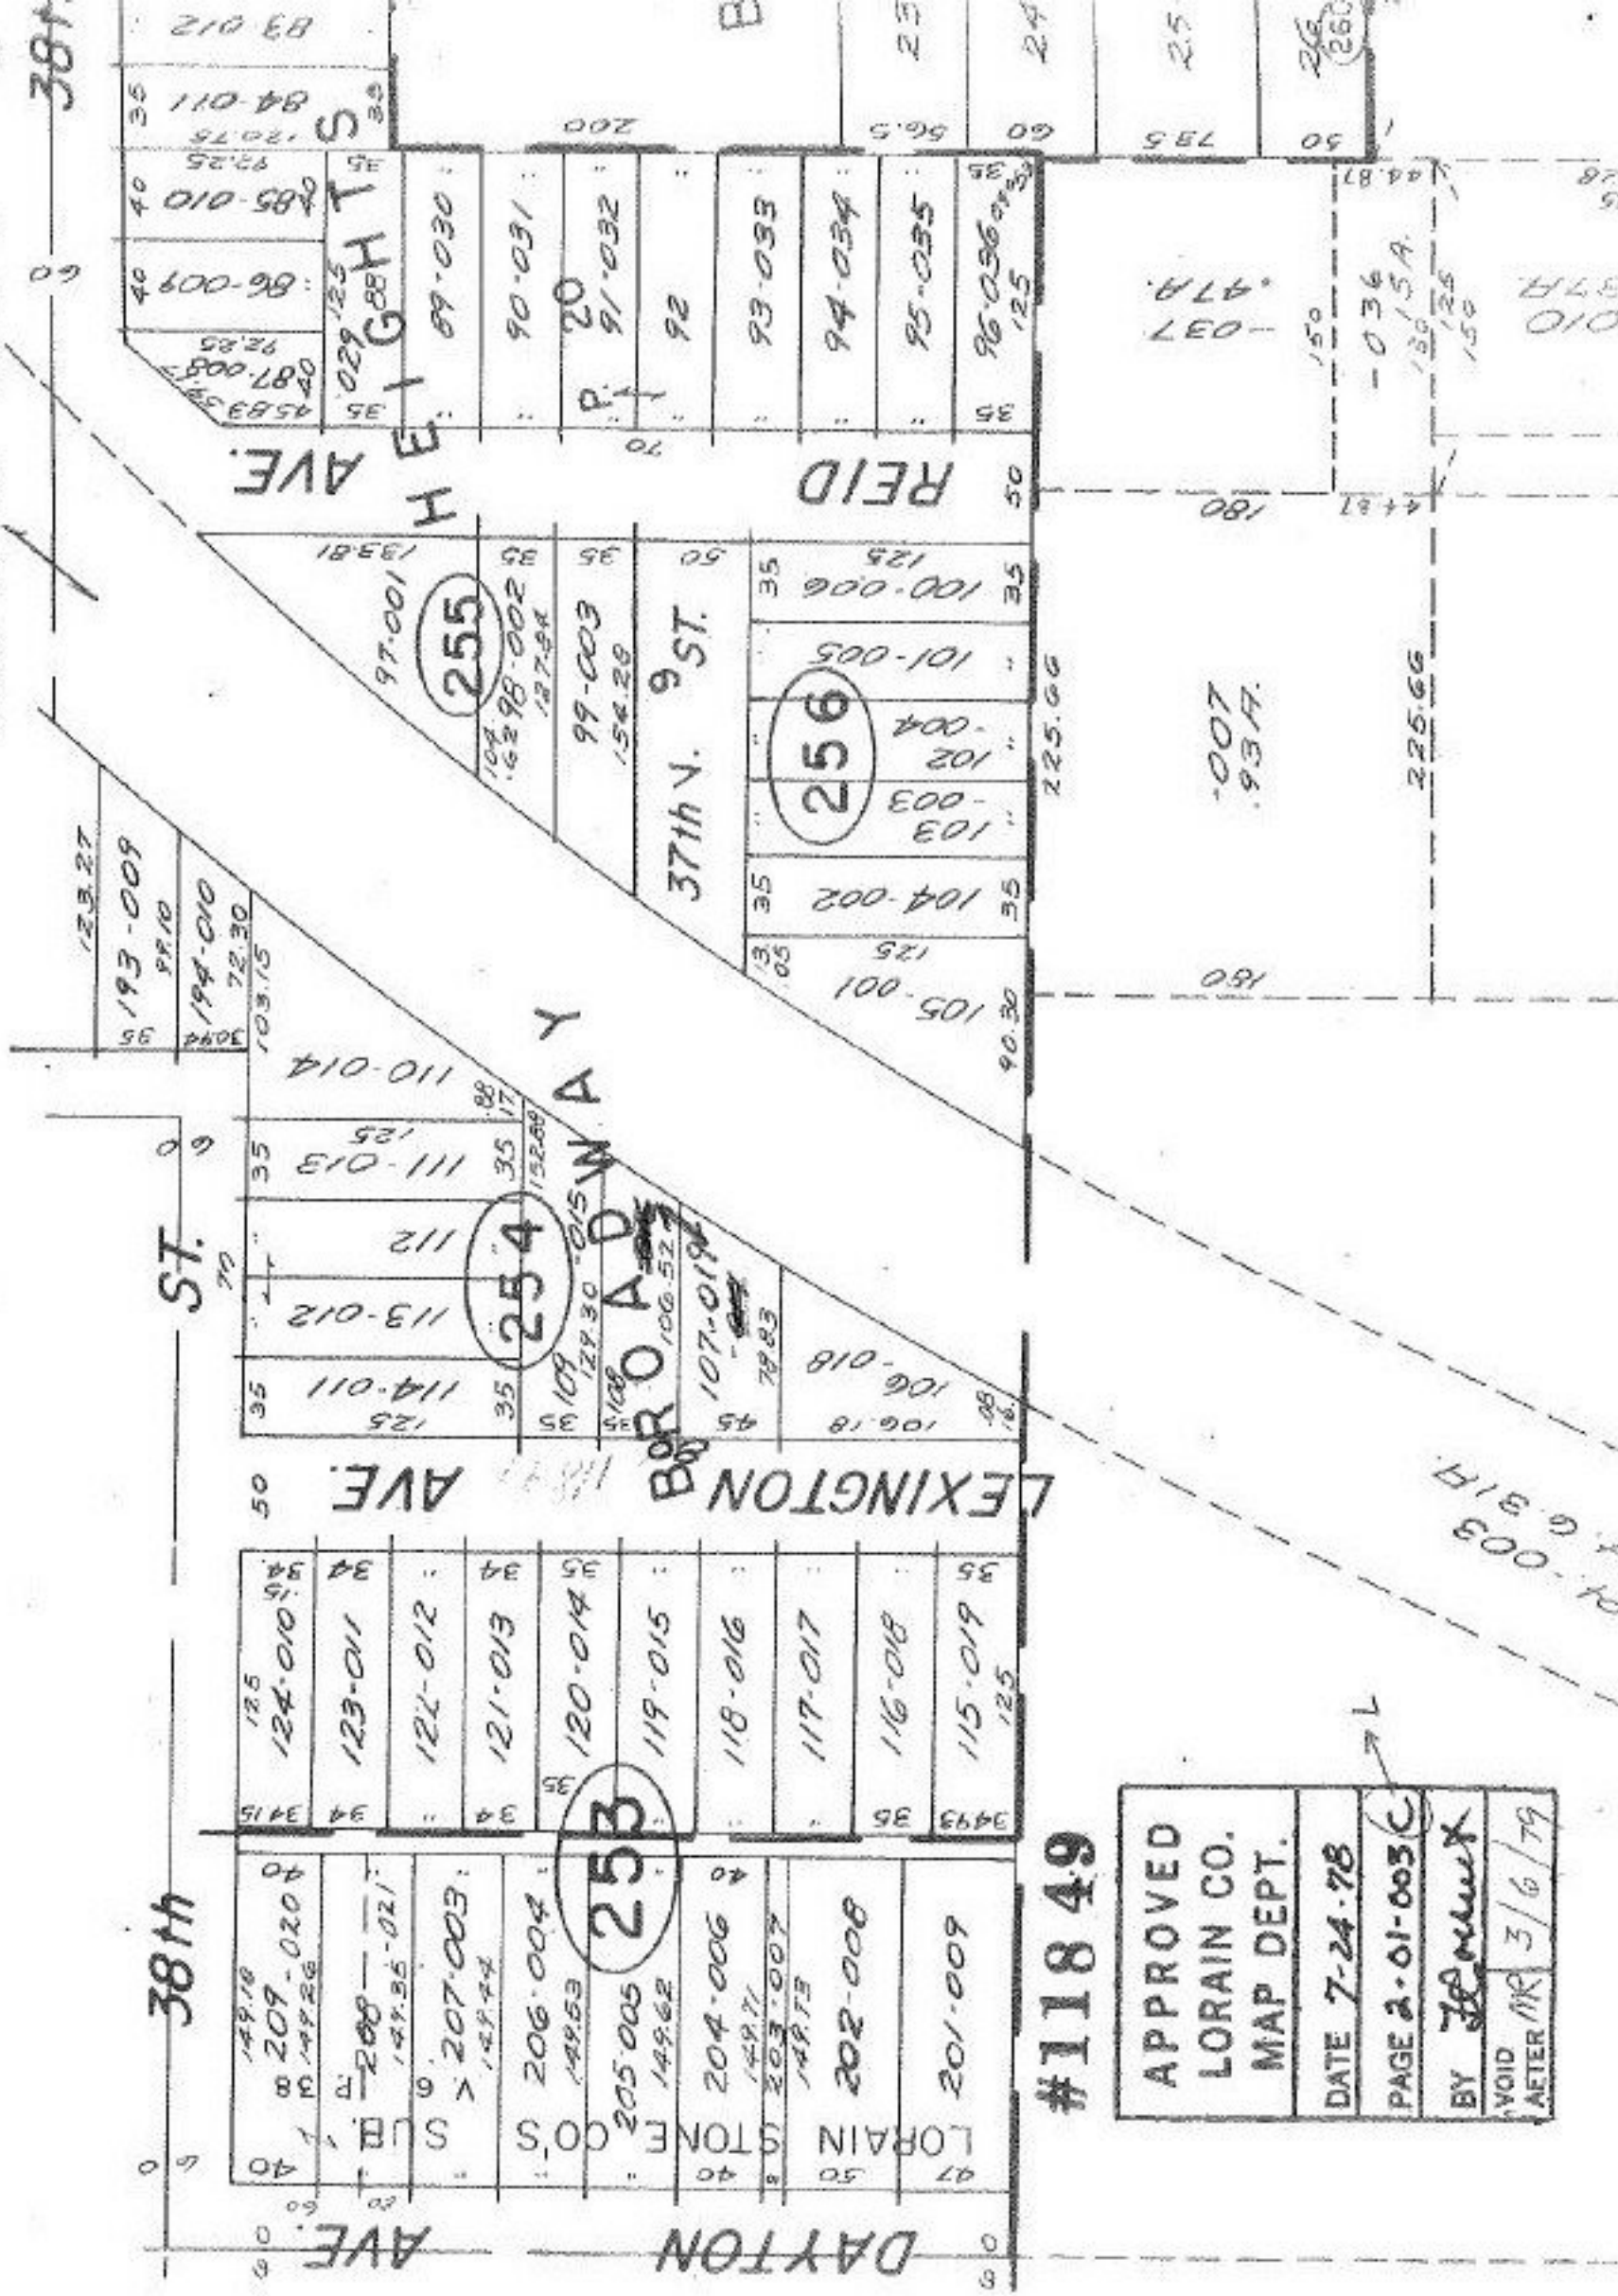

#11849

APPROVED LORAIN CO. MAP DEPT.
DATE 7-24-78
PAGE 2-01-003(C)
BY J. J. [Signature]
VOID AFTER MR 3/6/79

2-01-003-J