

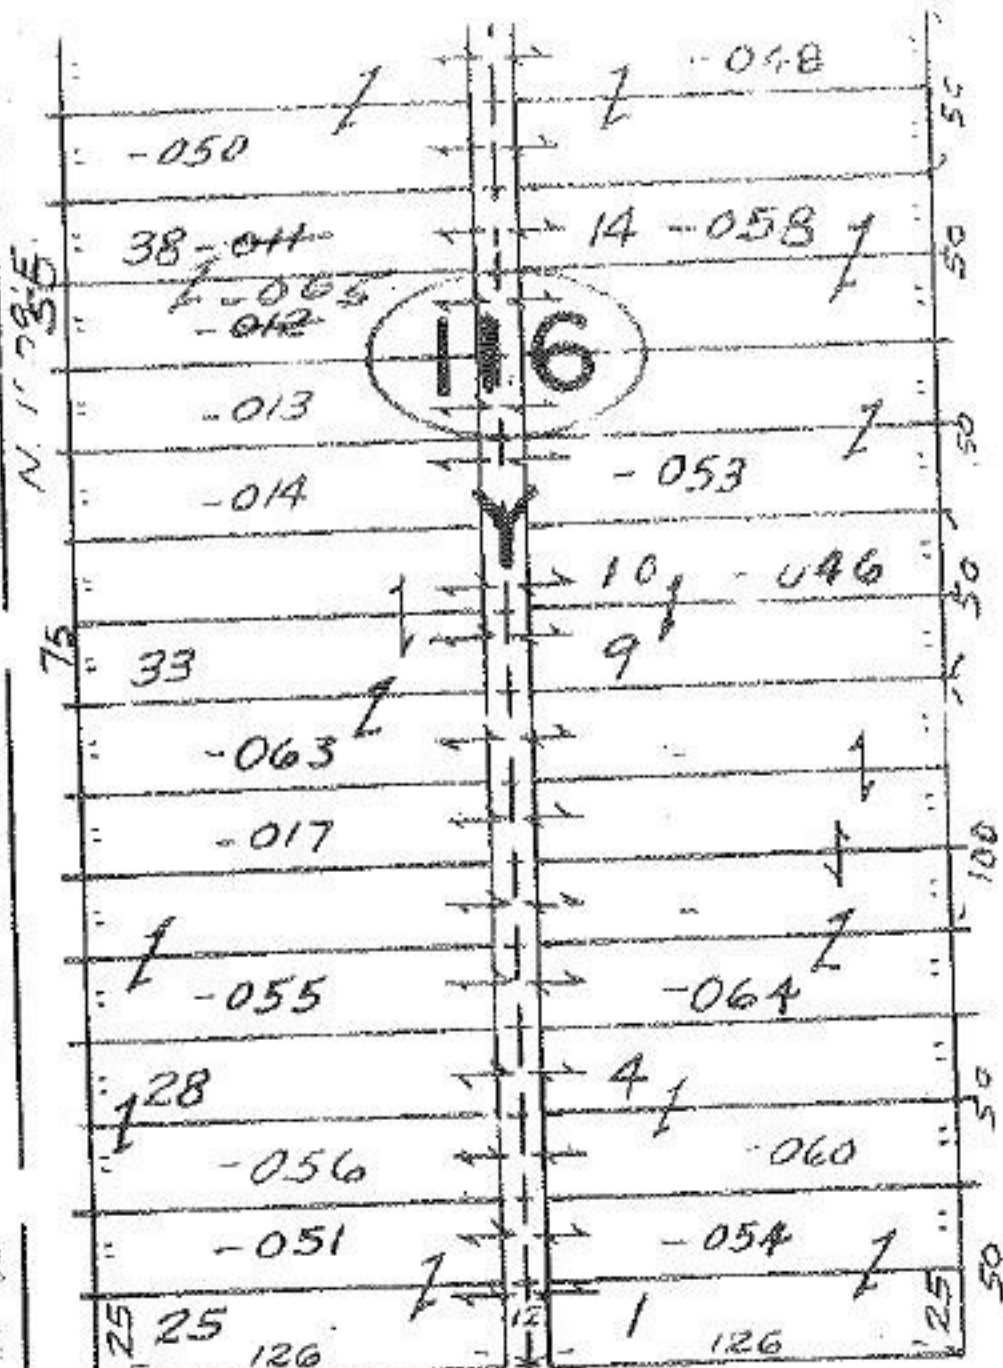
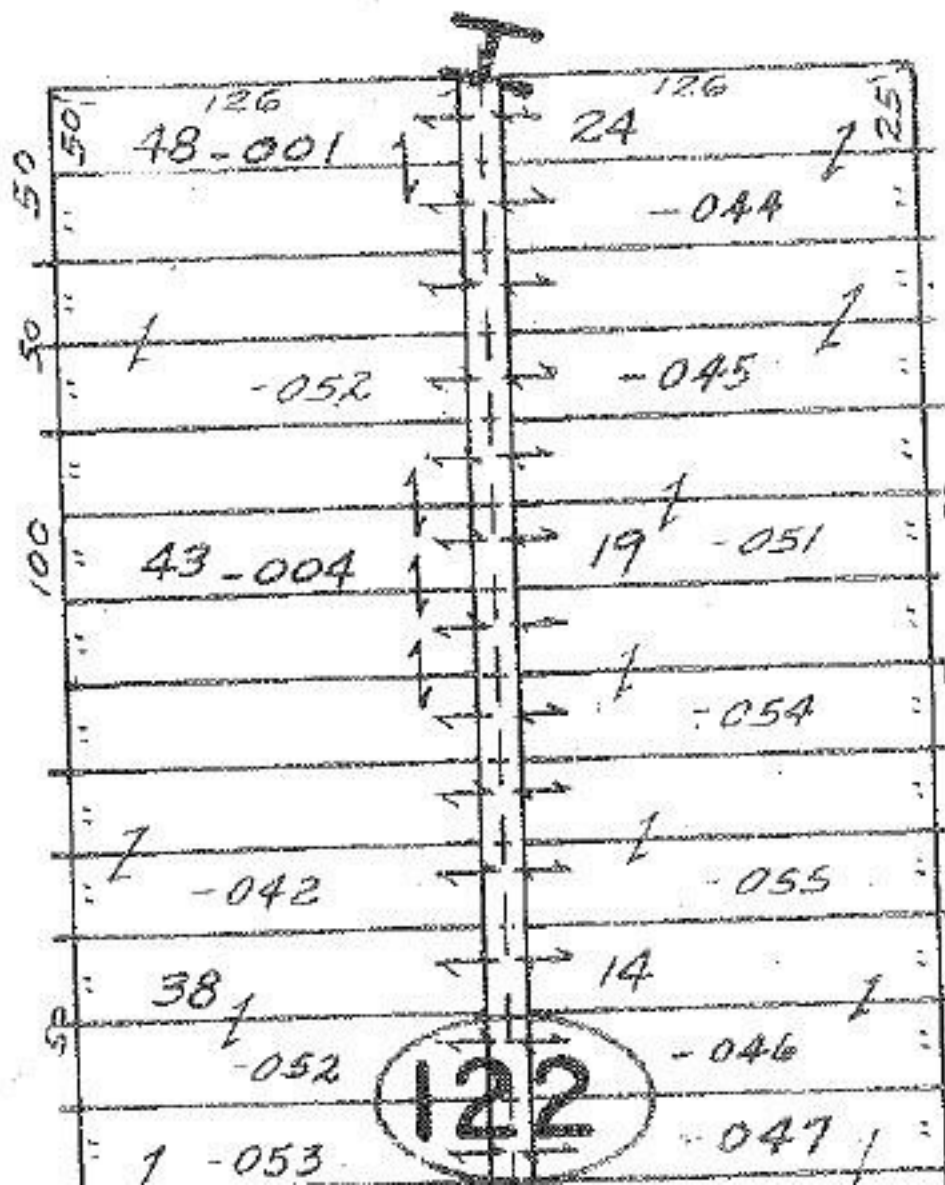


7-00-007-D

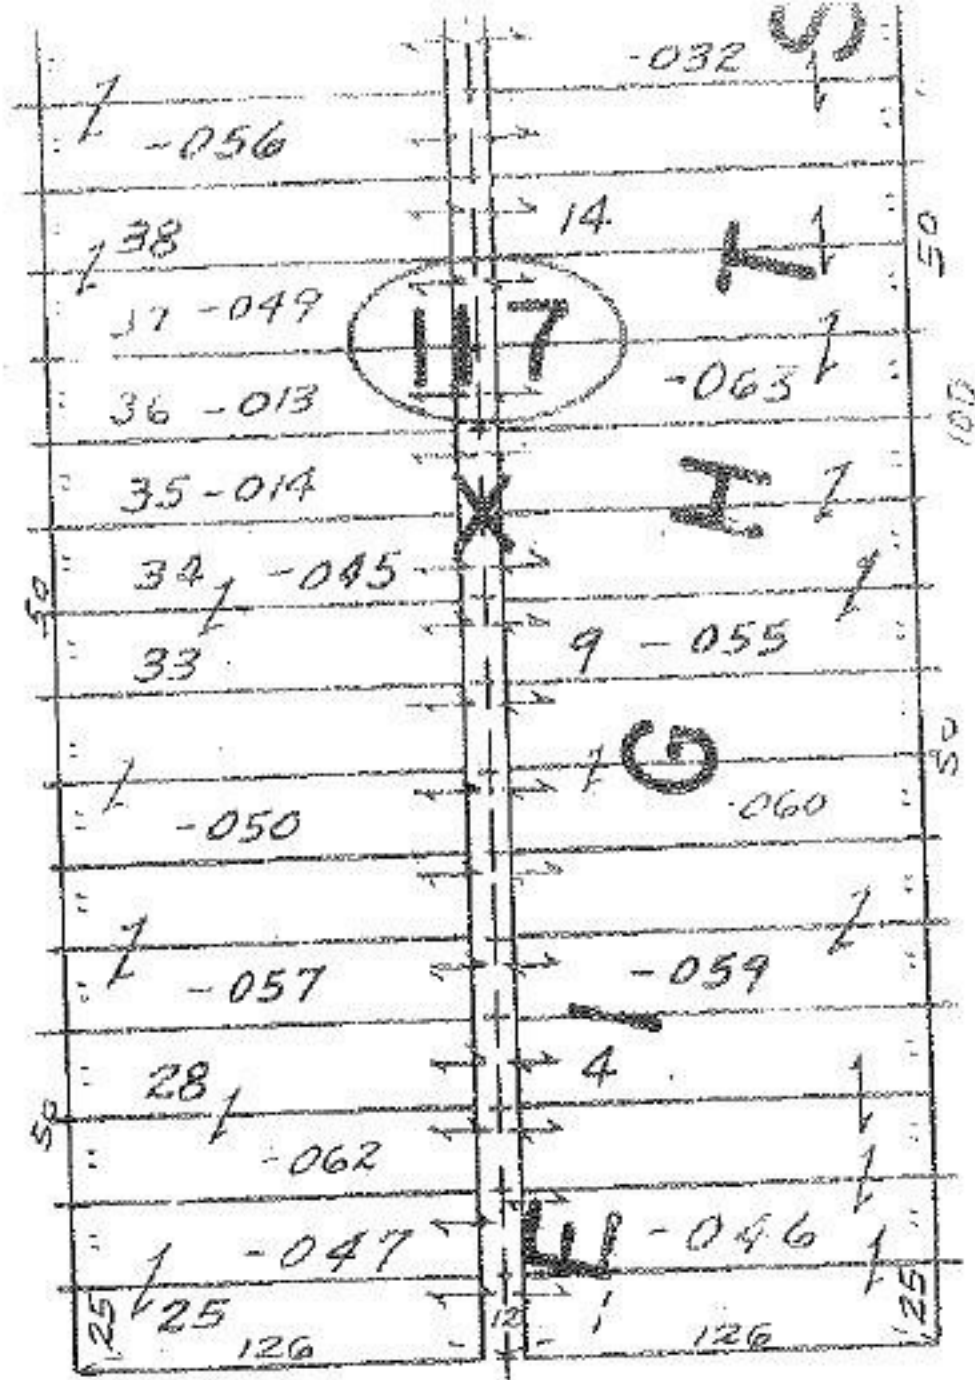

40 THERESA

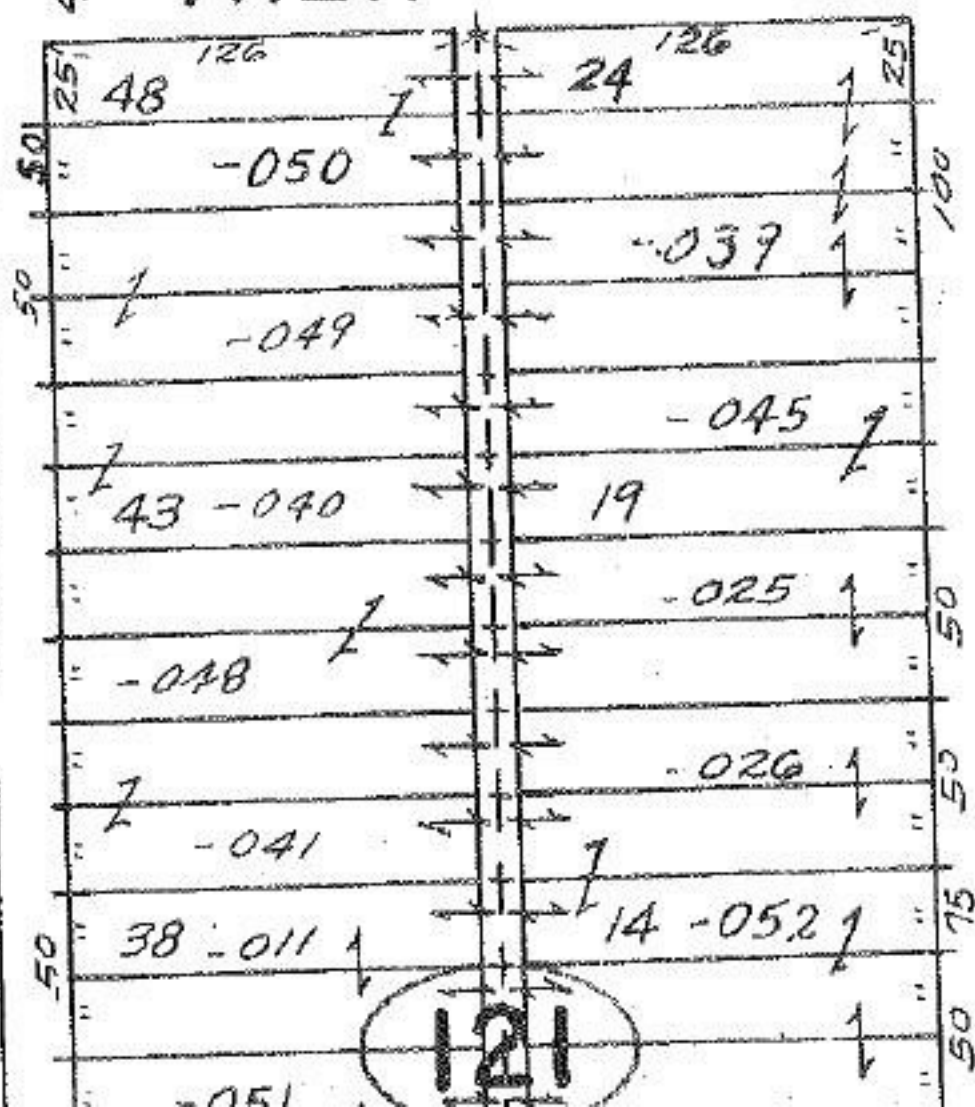

#11850

APPROVED
LOPAIN CO

E 7-00-007-C