


-010
4.30 A.

03-00-033-109-033
PH. 573 A
7.7.79

#11851

APPROVED
LORAIN CO.
MAP DEPT.
DATE 7-24-78
PAGE 3-00-033B
BY <i>J. K. Smith</i>
VOID AFTER

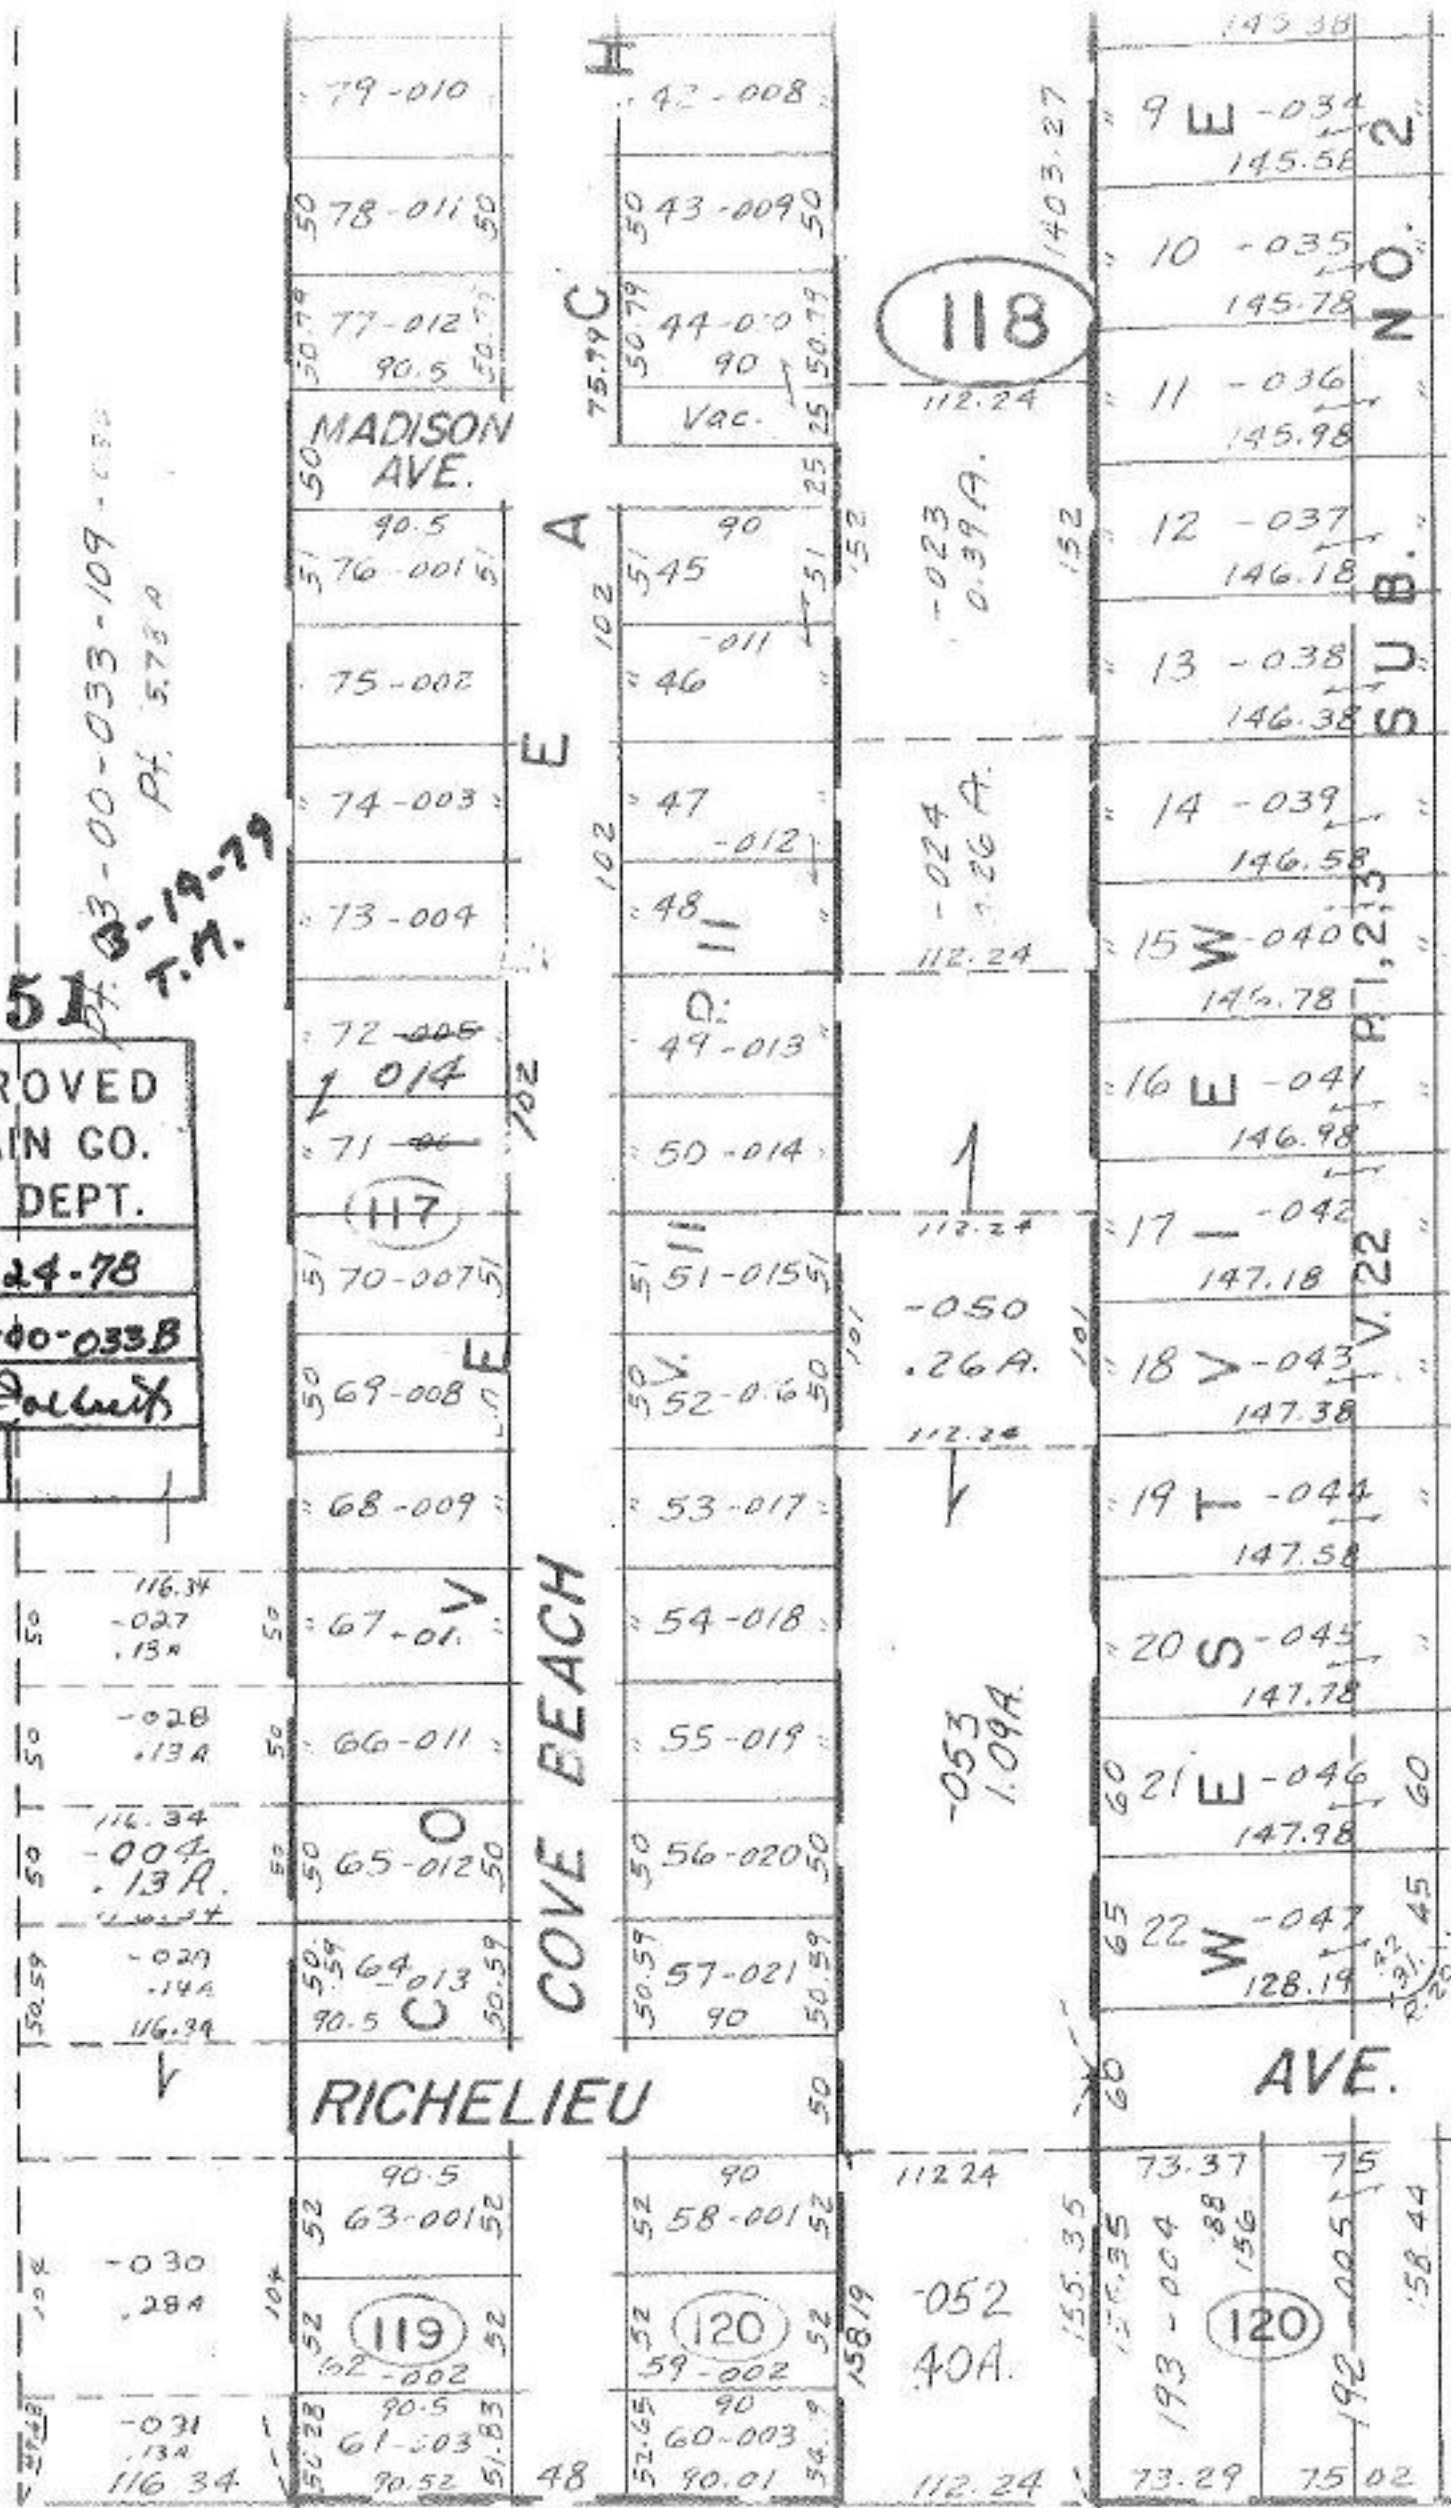

SEE 3-00-032-B

SEE 3-D 3-00-033