

3-00-040


TENNYSON

HAWTHORNE

BLVD.

HARRIET AVE

AVE 50

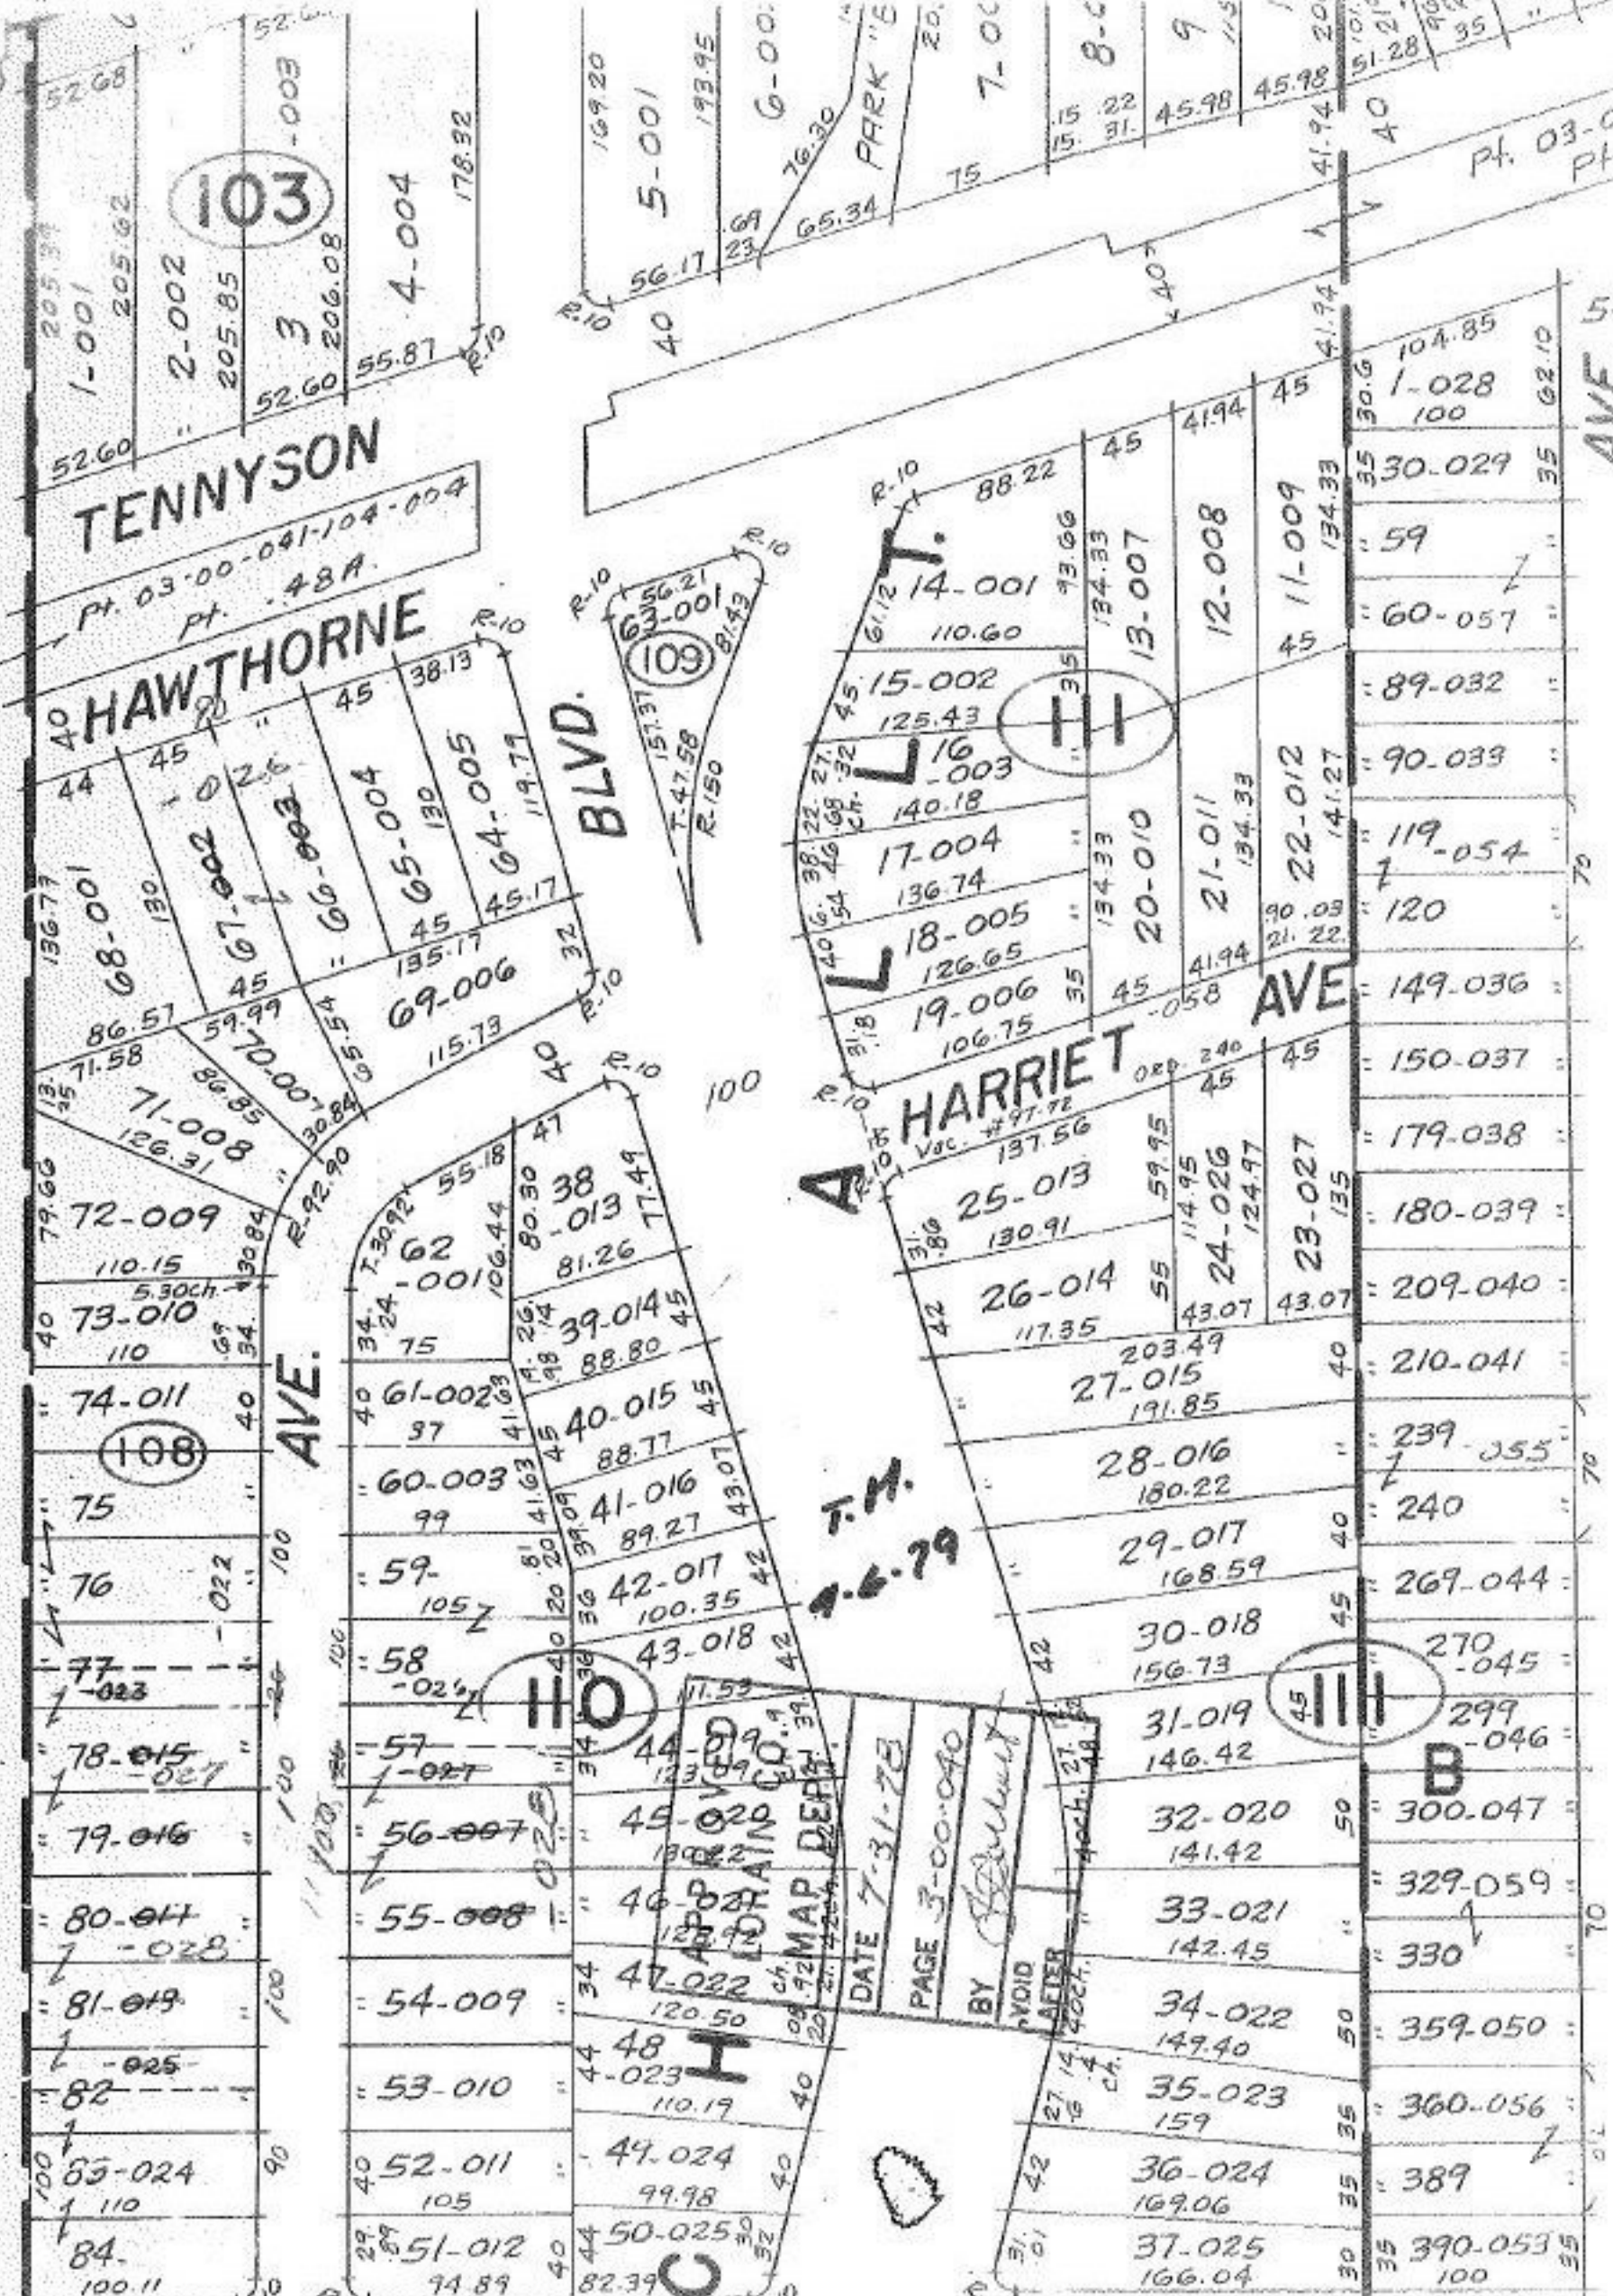

T.M.
7-6-79

B

