


115

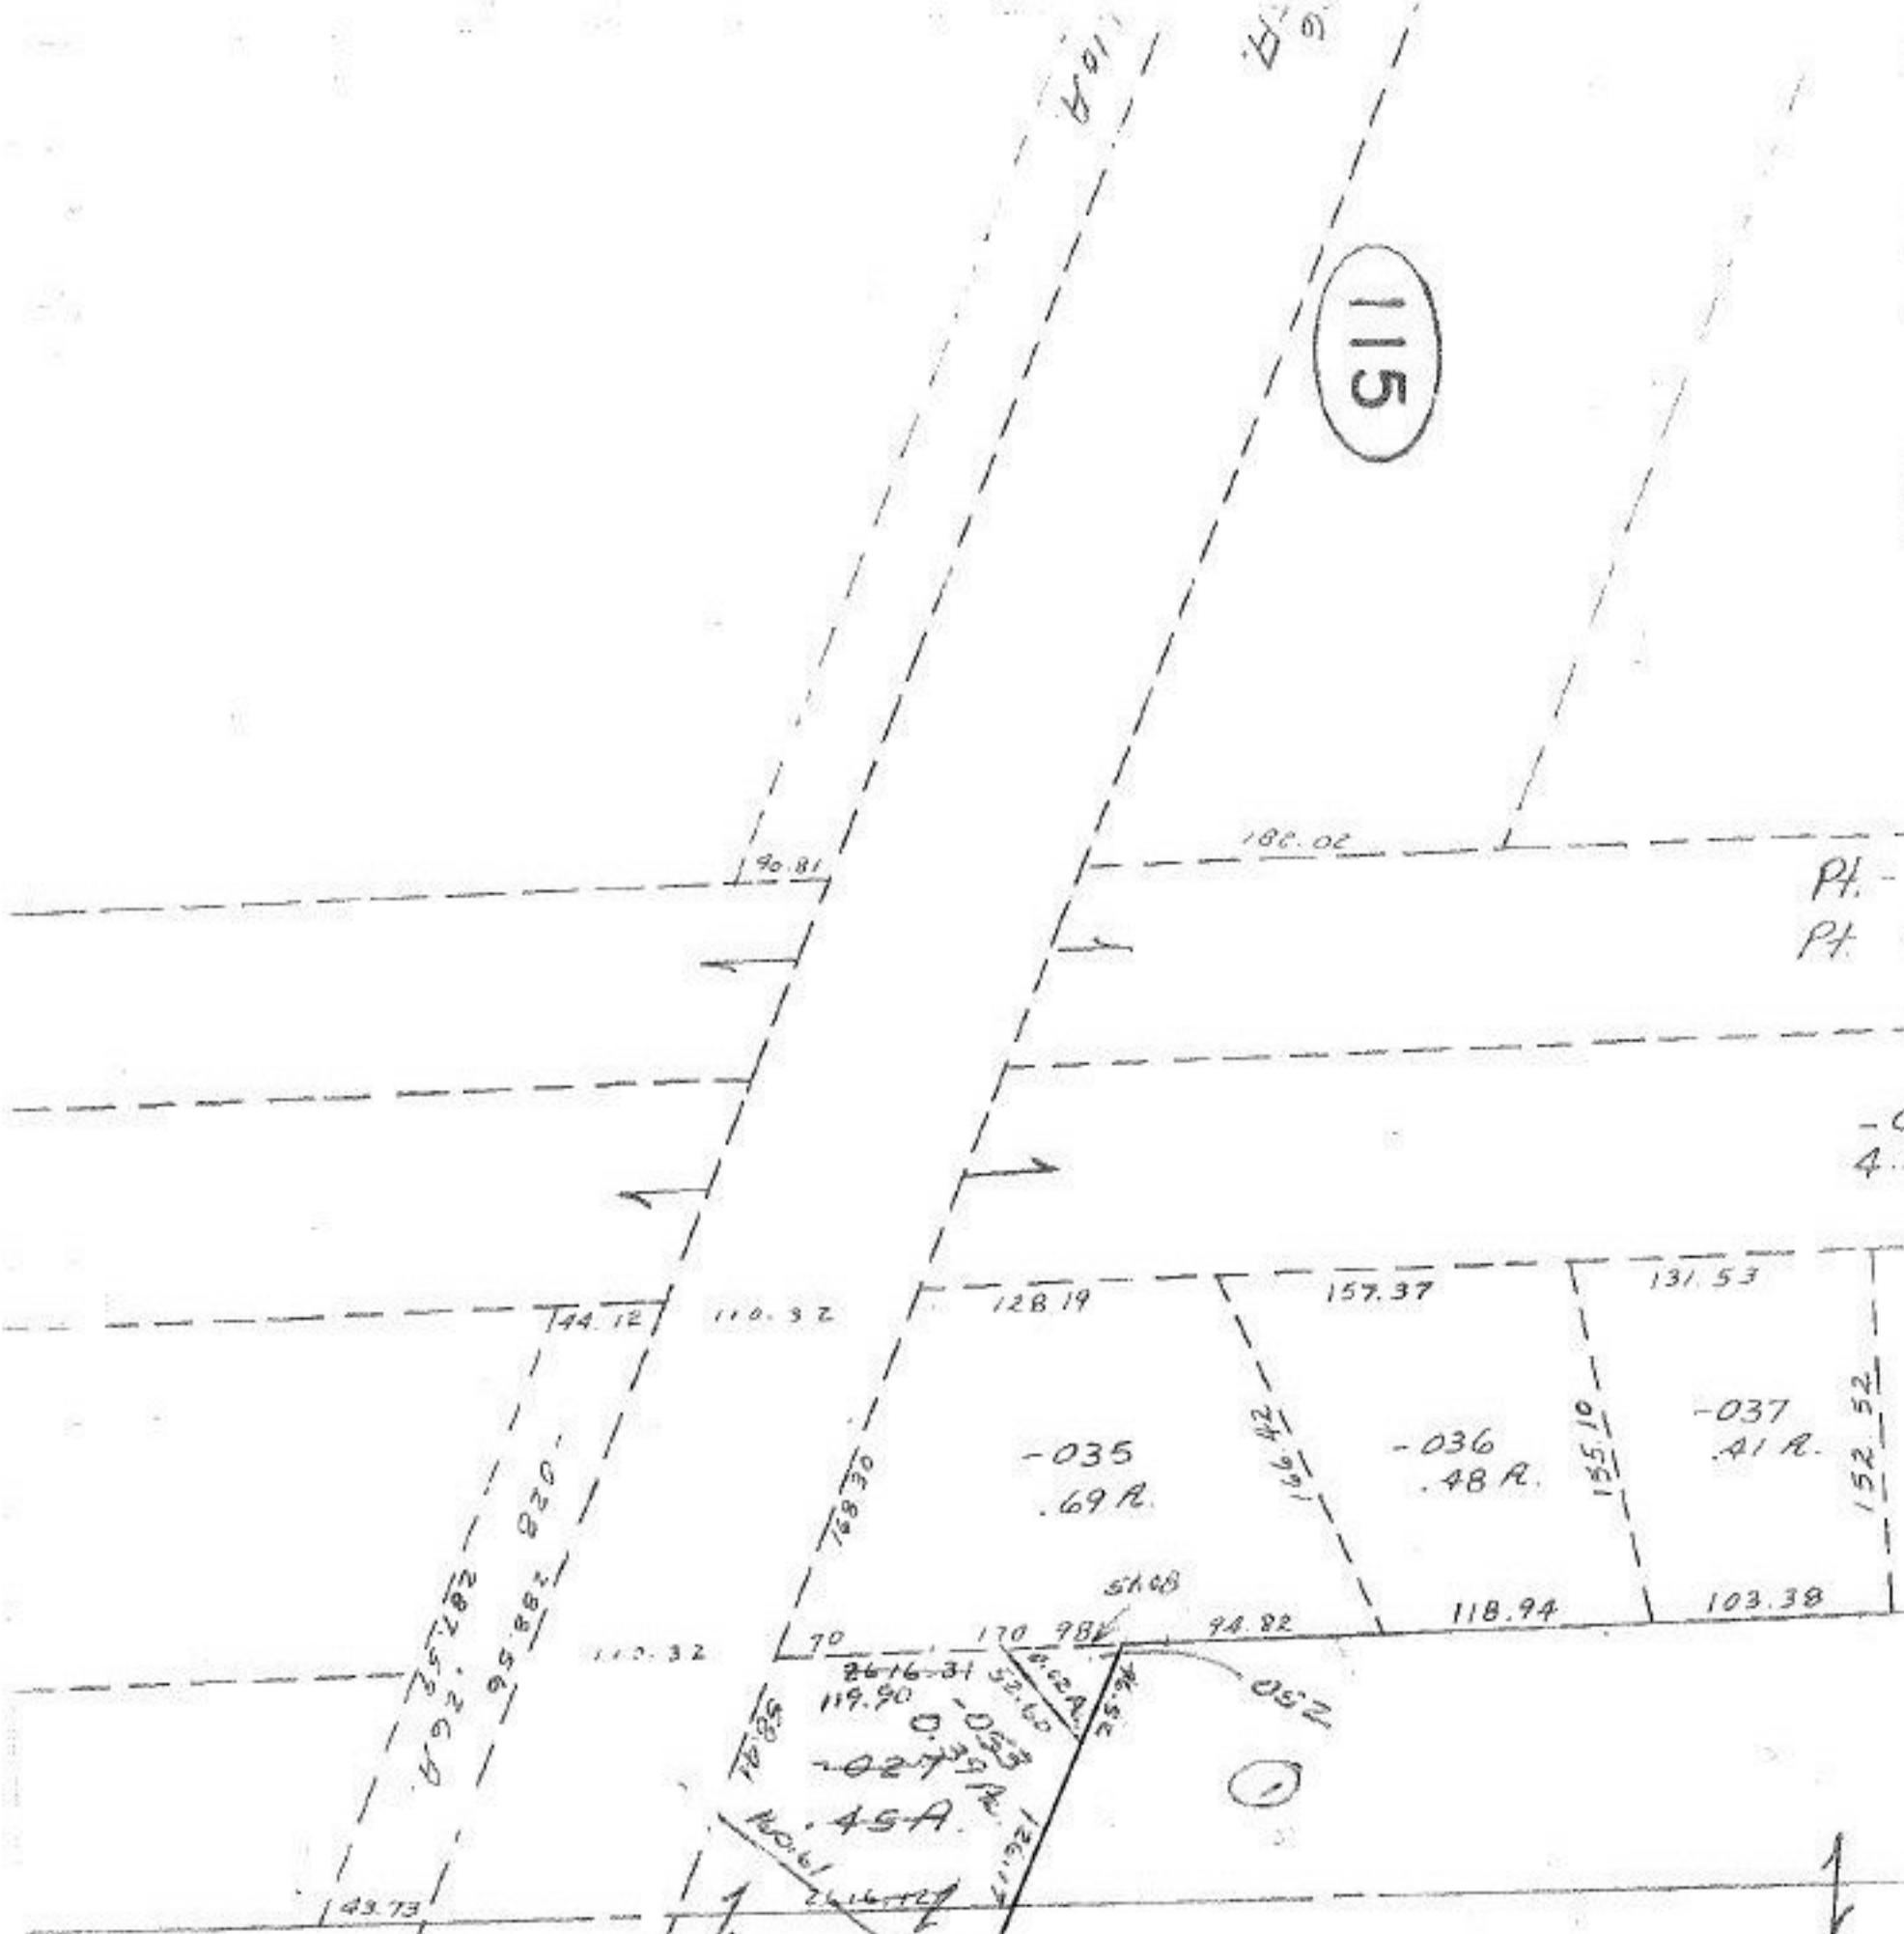

SEE 7-00-005-C

#11894	
APPROVED	
LORAIN CO.	
MAP DEPT.	
DATE	8-3-78
PAGE	7-00-008 D
BY	<i>[Signature]</i>
VOID AFTER	<i>[Signature]</i>

7-00-008 D