

# 11897

58

2241.90

-001  
3.78 A.  
-012  
5.02 A.

#11897

APPROVED  
LORAIN CO.  
MAP DEPT.

T.M.  
3-12-79

DATE 2-11-78

PAGE 9 BEE

BY T.M. Main

VOID AFTER

-003  
74.00 A.  
OL 6  
3.78 Ac.  
+ 1.16 Ac.

11899  
11897




ROBT. E.  
HASENFUE

2733.52

6


-009  
33.97 A.

AL ACRES IN OL 6.  
6.00 Ac.

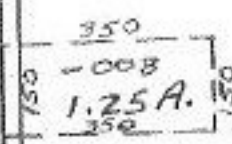

-005  
22.00 A.

Deed - .98  
5.02 Remainder

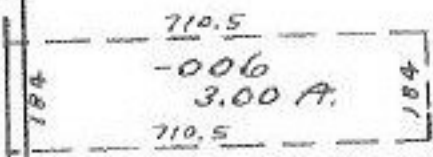

09-00-006-000-001 3.78 Ac.  
09-00-005-000-003 14.00 Ac.  
013 4.20 Ac.  
25.00 A.

21.98 Ac.  
- 6.65  
15.33

1.63  
5.02  
6.65

-001  
50.00 A.

CC  
33333EEEE

1110  
C  
23

16 -002  
67.00 A.