


#11903

SEE 18-00-028-C

18 #11903

W. MAIN ST.

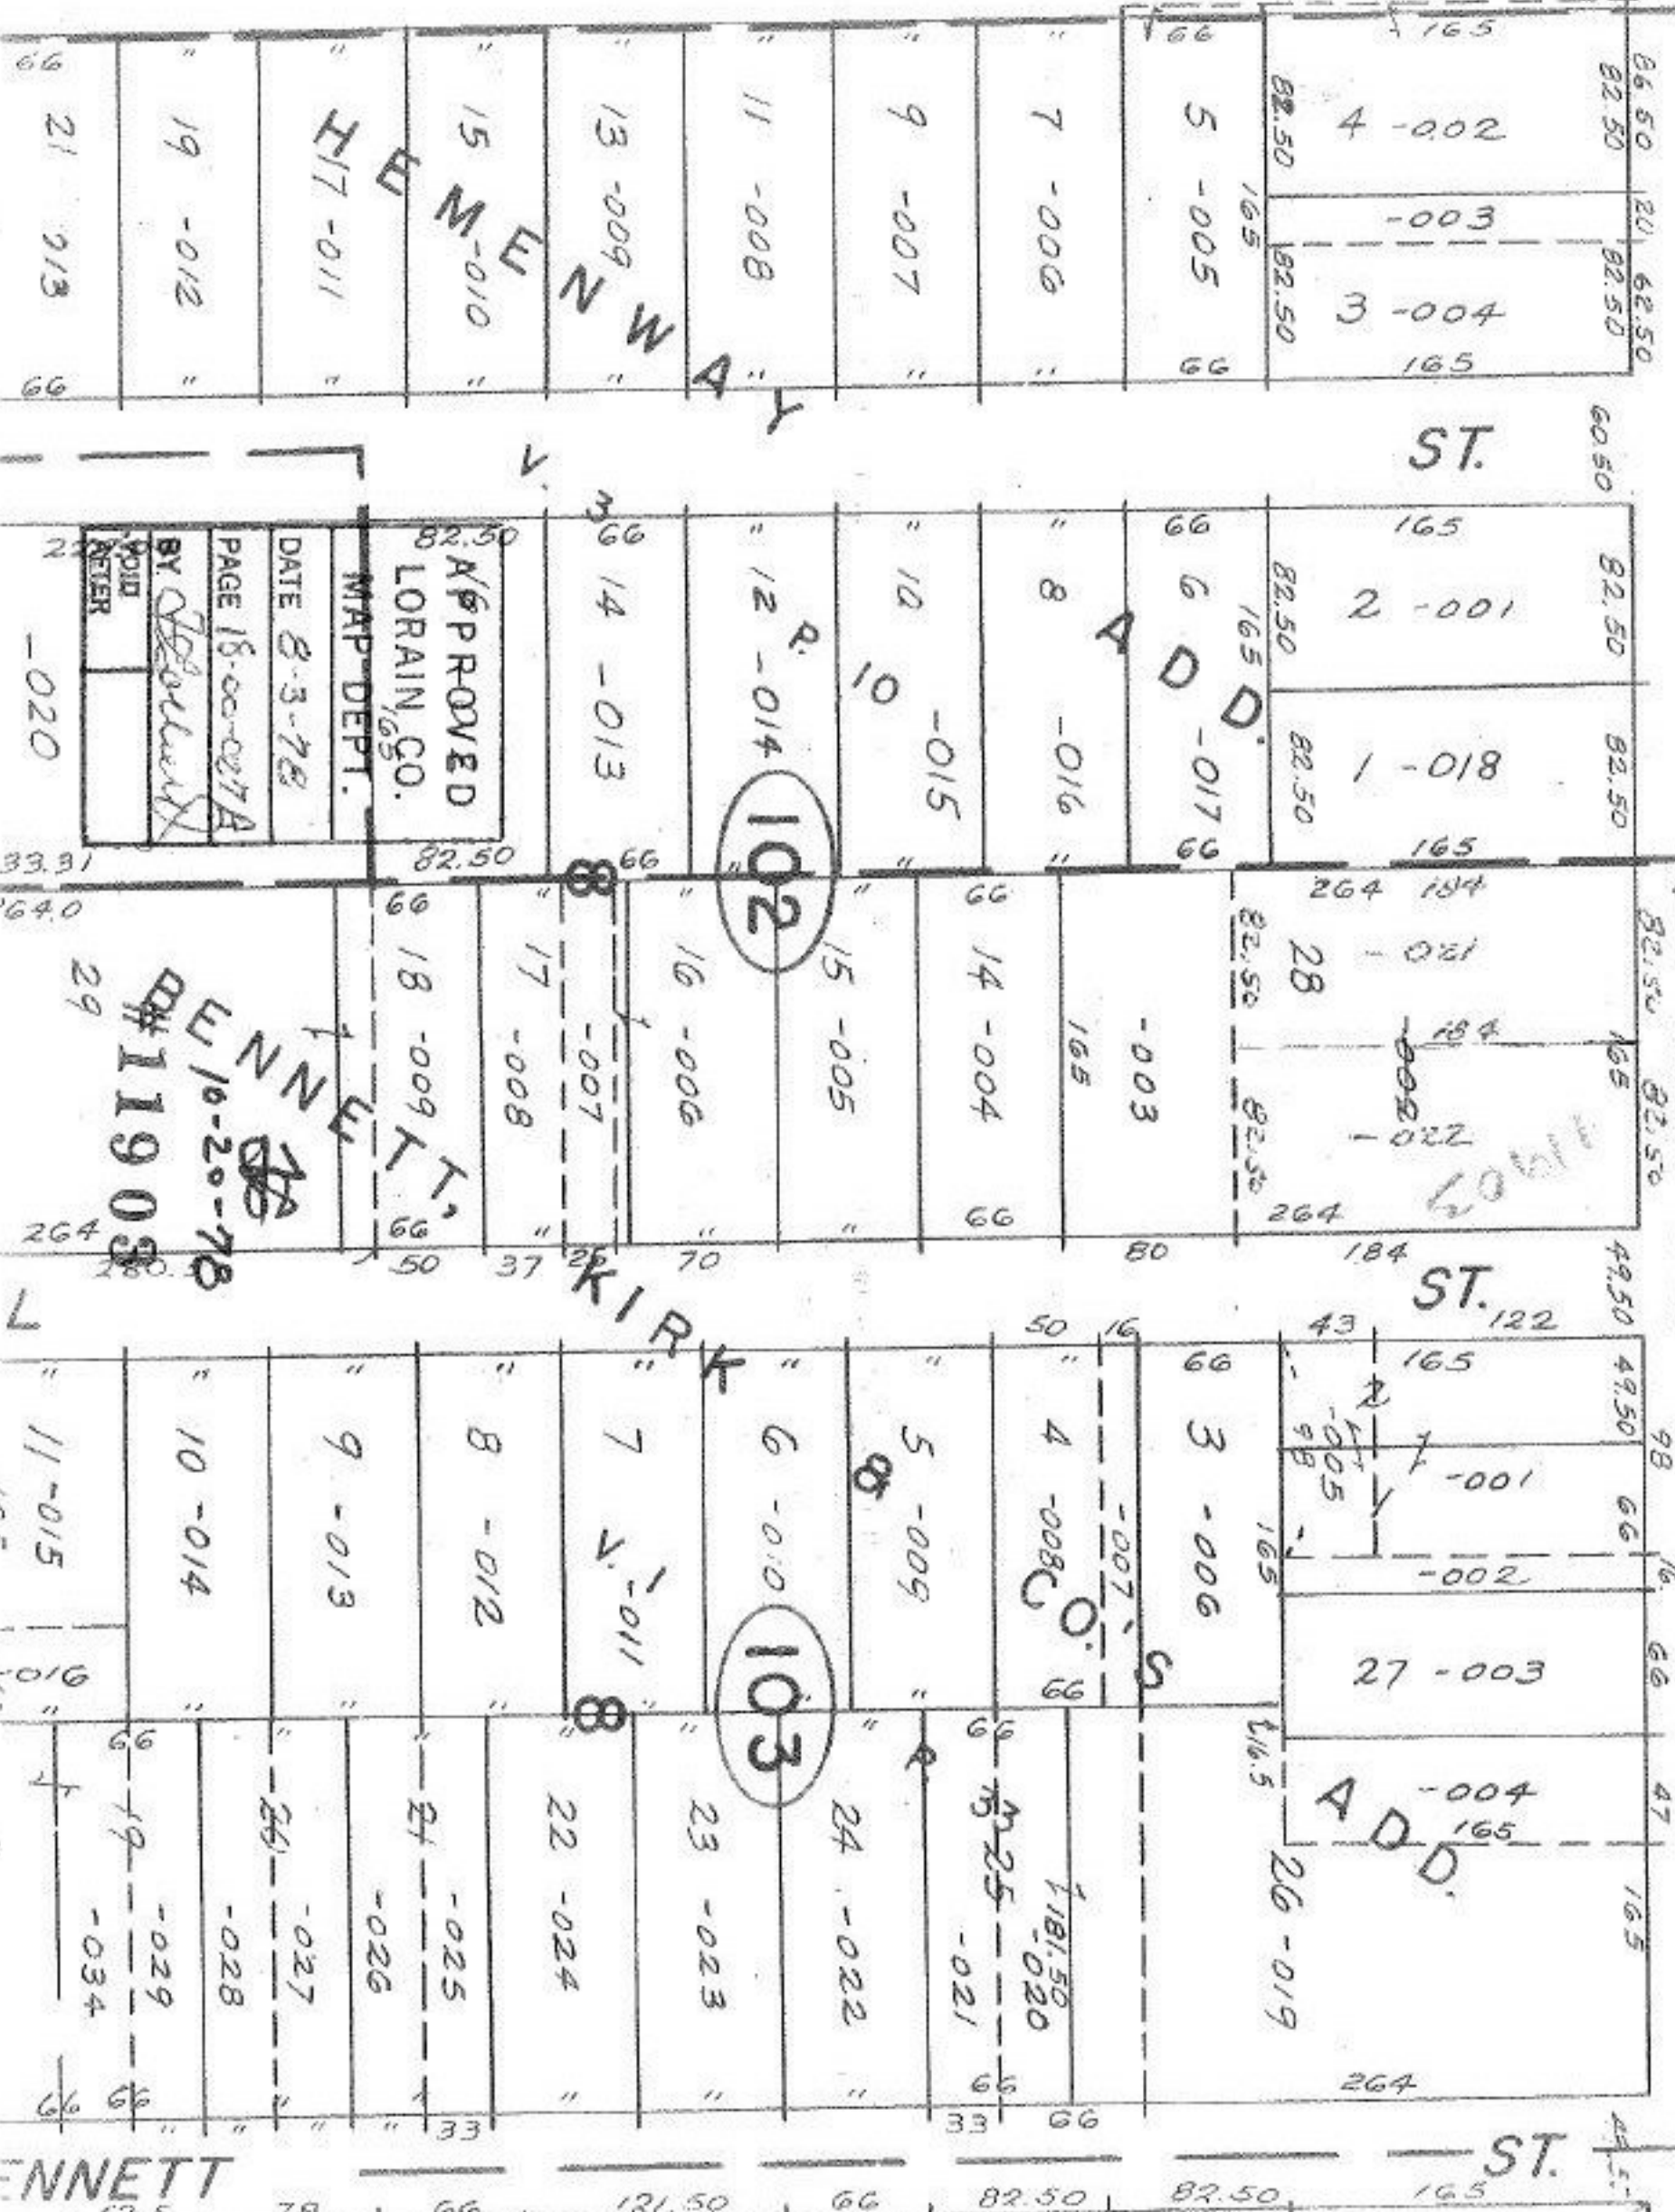

APPROVED
 LORAIN CO.
 MAP DEPT.
 DATE 8-3-78
 PAGE 18-00-027A
 BY [Signature]
 VOID AFTER

APPROVED
 LORAIN CO.
 MAP DEPT.
 DATE 8-3-78
 PAGE 18-00-027A
 BY [Signature]
 VOID AFTER

ANNETT ST.