


#1194

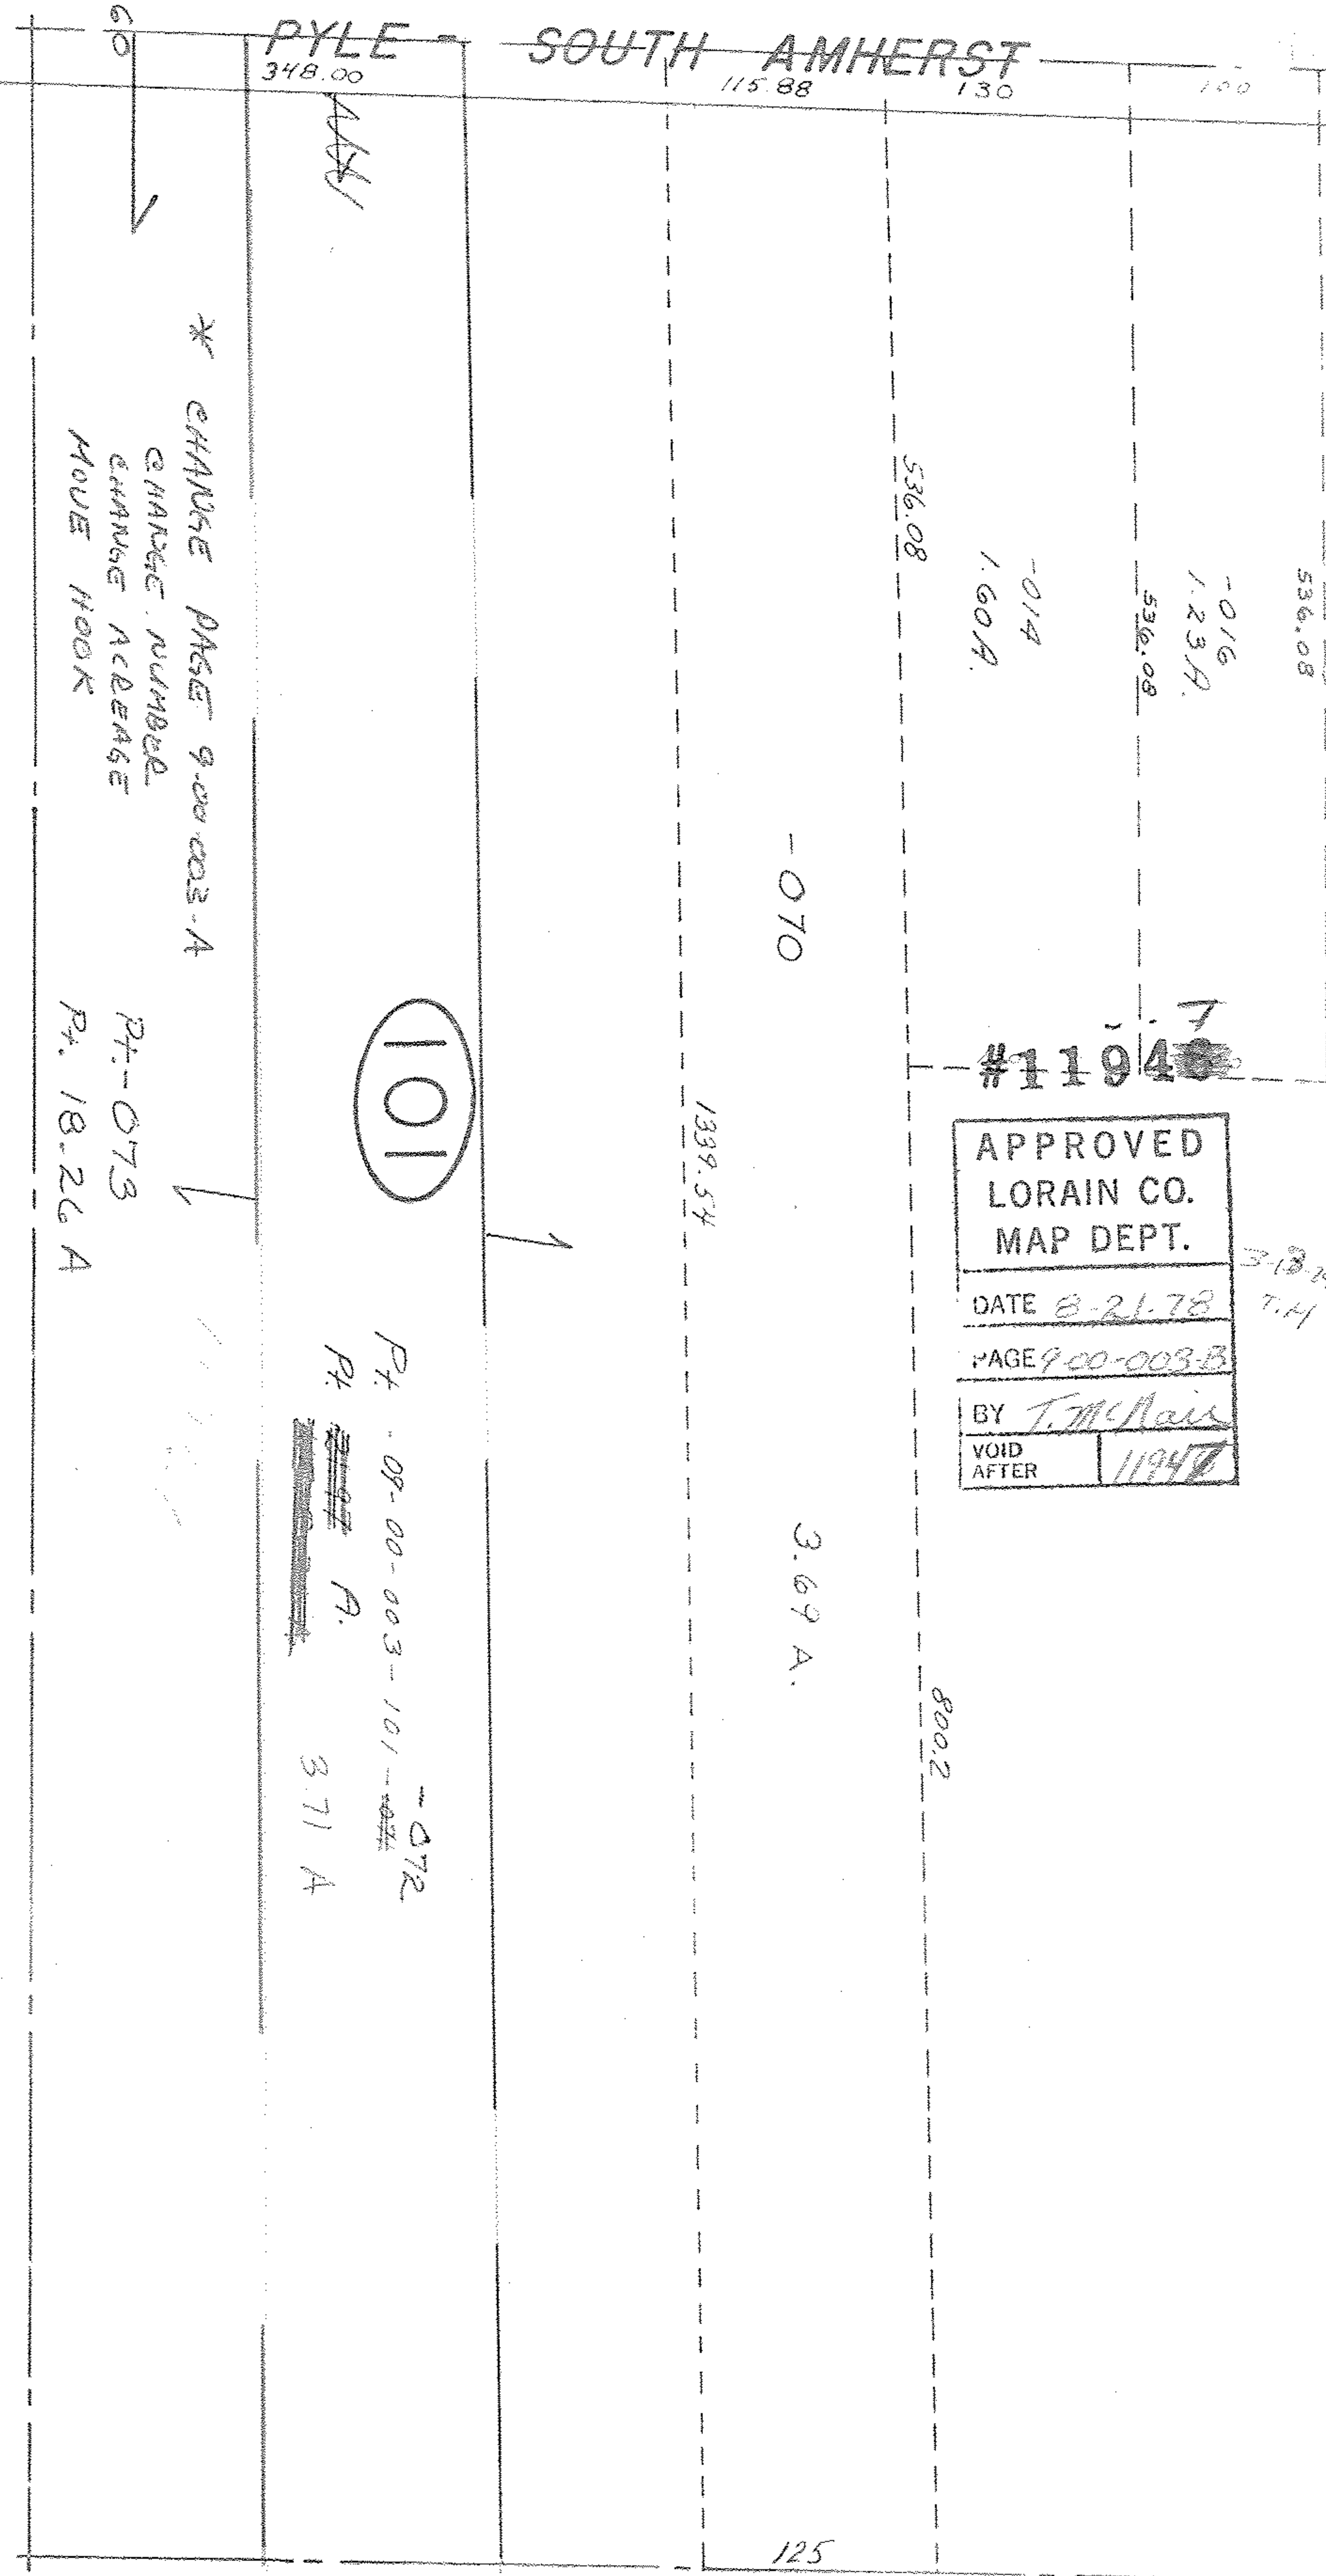

PYLE
348.00

SOUTH AMHERST
115.88 130

100

536.08

-016
1.23 A.

536.08

-014
1.60 A.

536.08

-070

1339.54

APPROVED LORAIN CO. MAP DEPT.	
DATE	8-21-78
PAGE	9-00-003-B
BY	T. McHair
VOID AFTER	1194

3-12-78
T.H.

800.2

3.69 A.

125

101

Pt. - 08-00-003-101-~~072~~

Pt. ~~072~~ A. 3.71 A

* CHANGE PAGE 9-00-003-A

CHANGE NUMBER

CHANGE AVERAGE

MOVE HOOK

Pt. - 073

Pt. 18.26 A

SEE 9-00-013-B

60