


#11963

#11963

APPROVED LORAIN CO. MAP DEPT.	
DATE	8-22-78
PAGE	12-H
BY	T.M. [Signature]
VOID AFTER	

MAR 19 1979

[Signature]

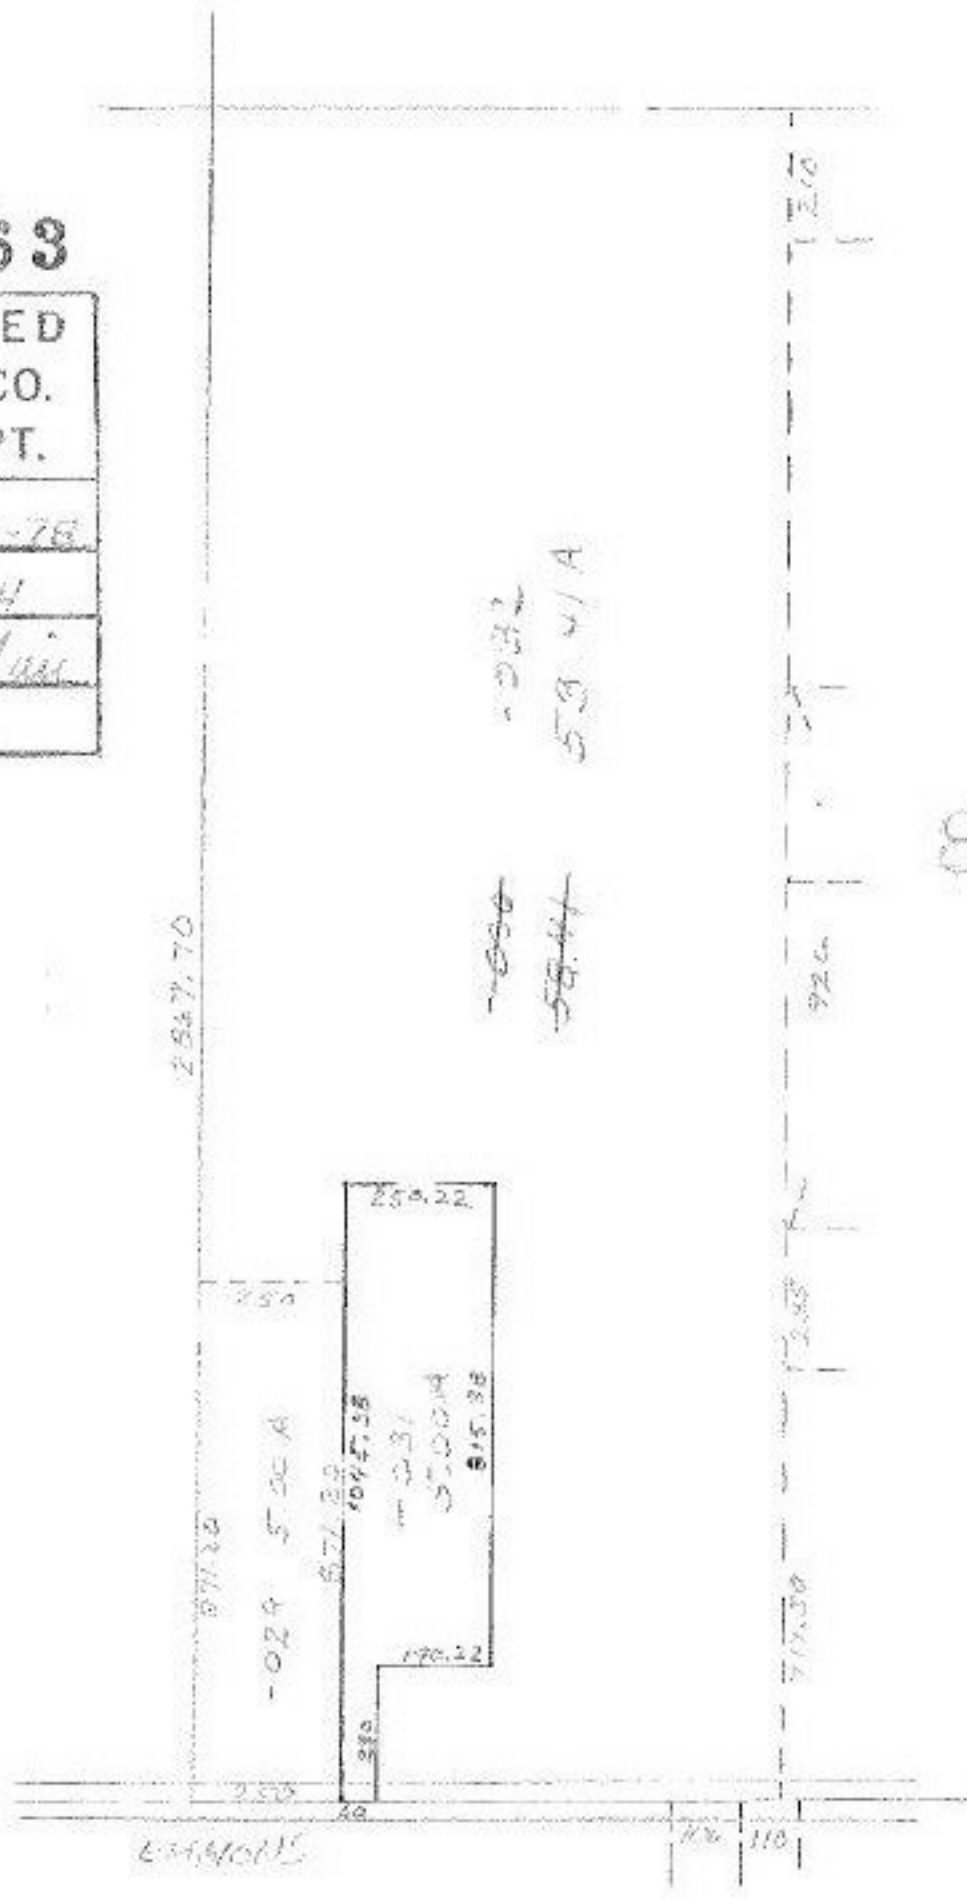

~~029~~ 5.20 A

571.22

00