


# 11978

801.48

PARSONS

RD.

(60)

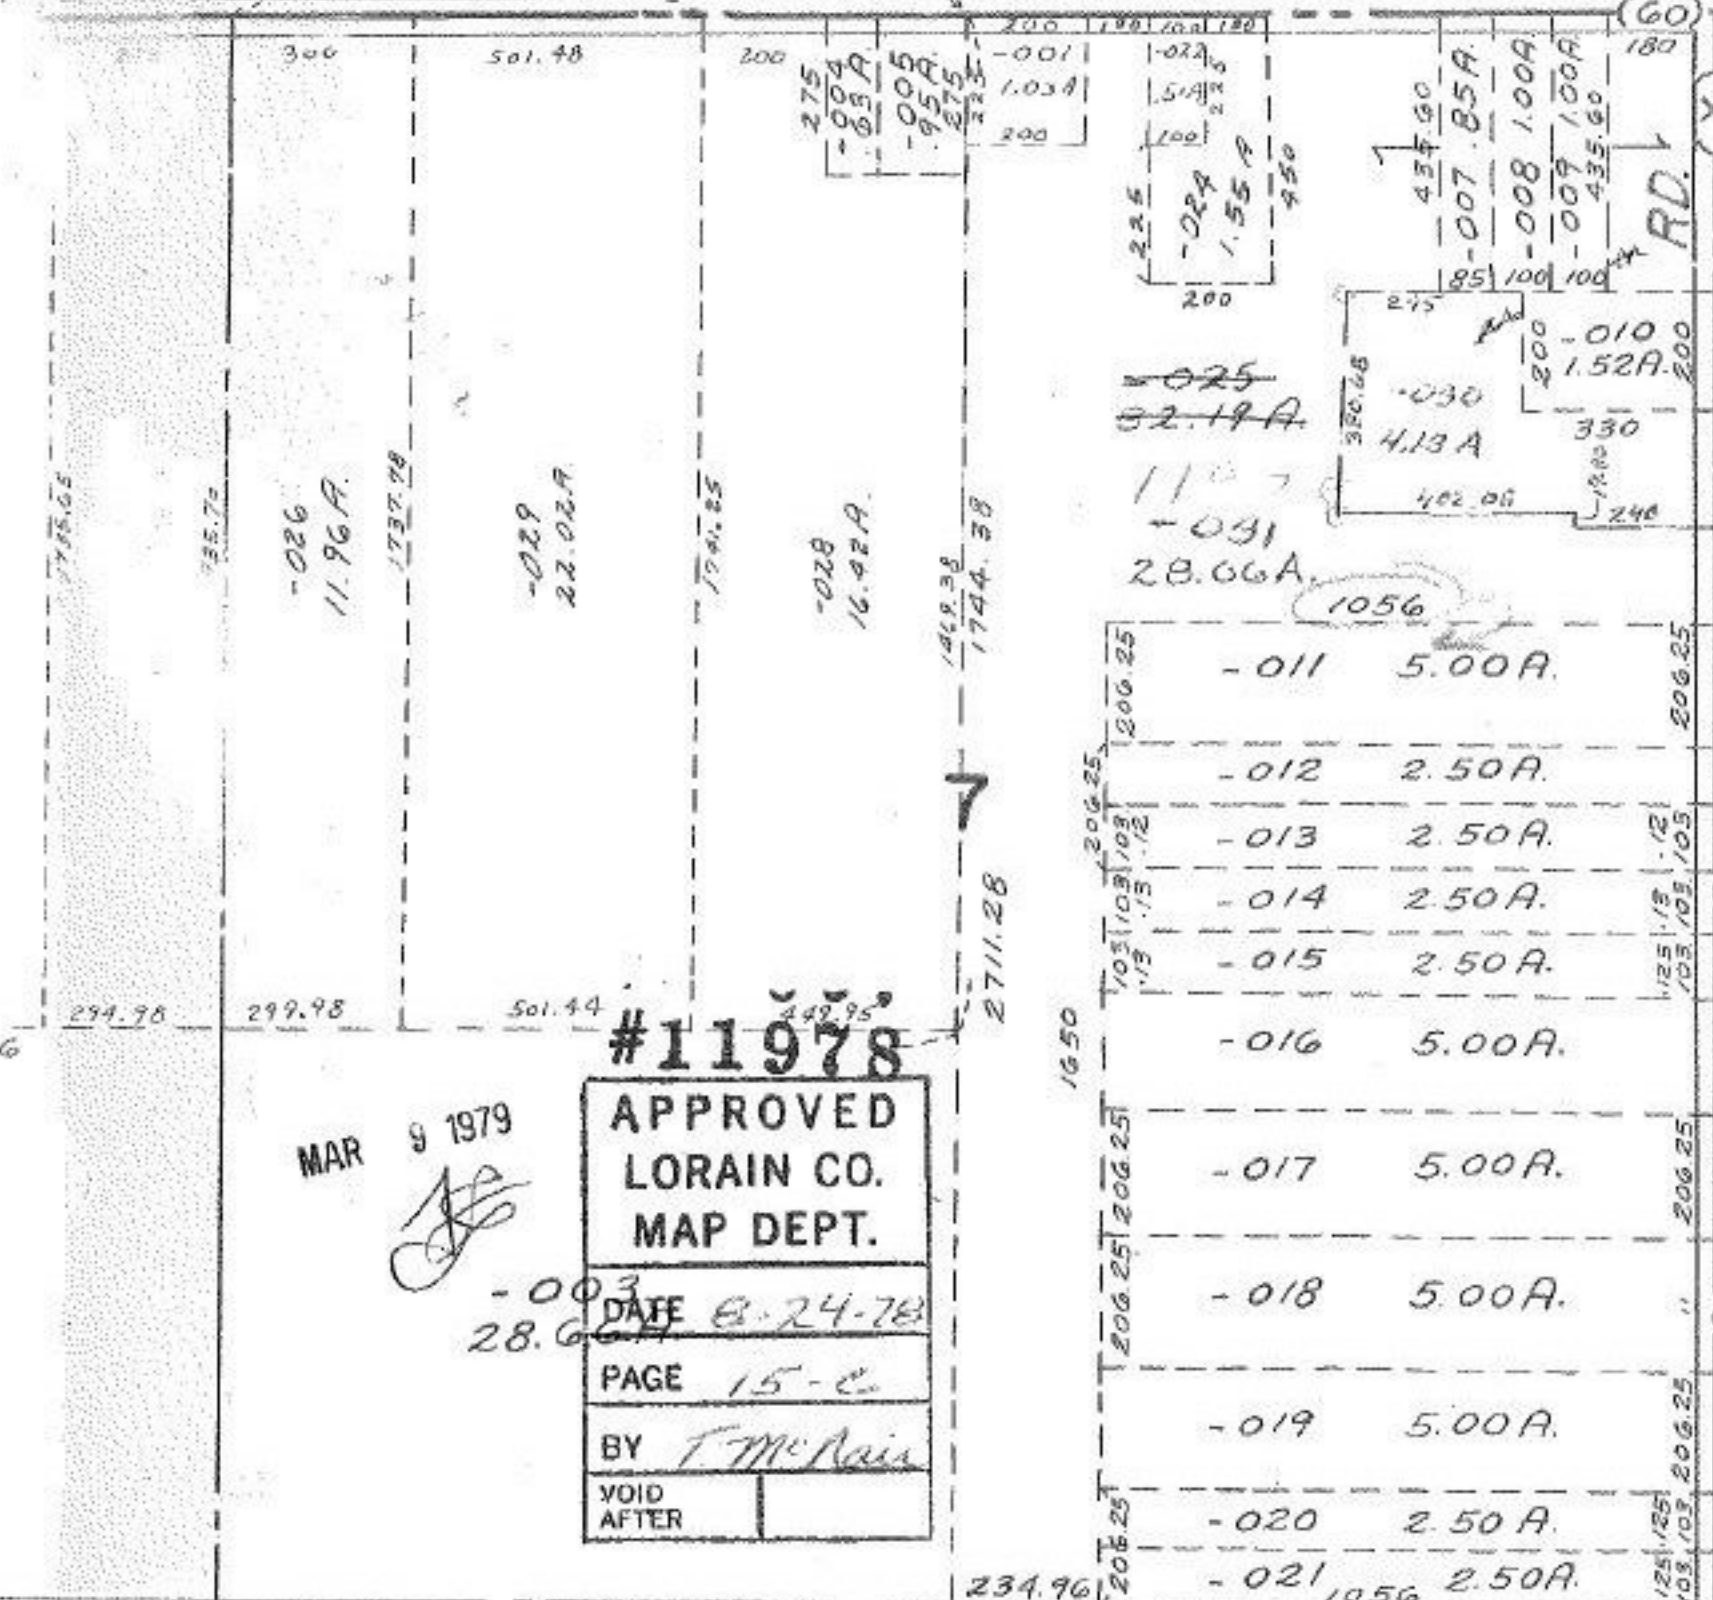

MAR 9 1979

*[Signature]*

#11978

APPROVED  
LORAIN CO.  
MAP DEPT.

-003  
DATE 8-24-78  
28.66A

PAGE 15-C

BY F. McRae

VOID  
AFTER

-001  
101.00A.