


11986

KOLBE

100.11

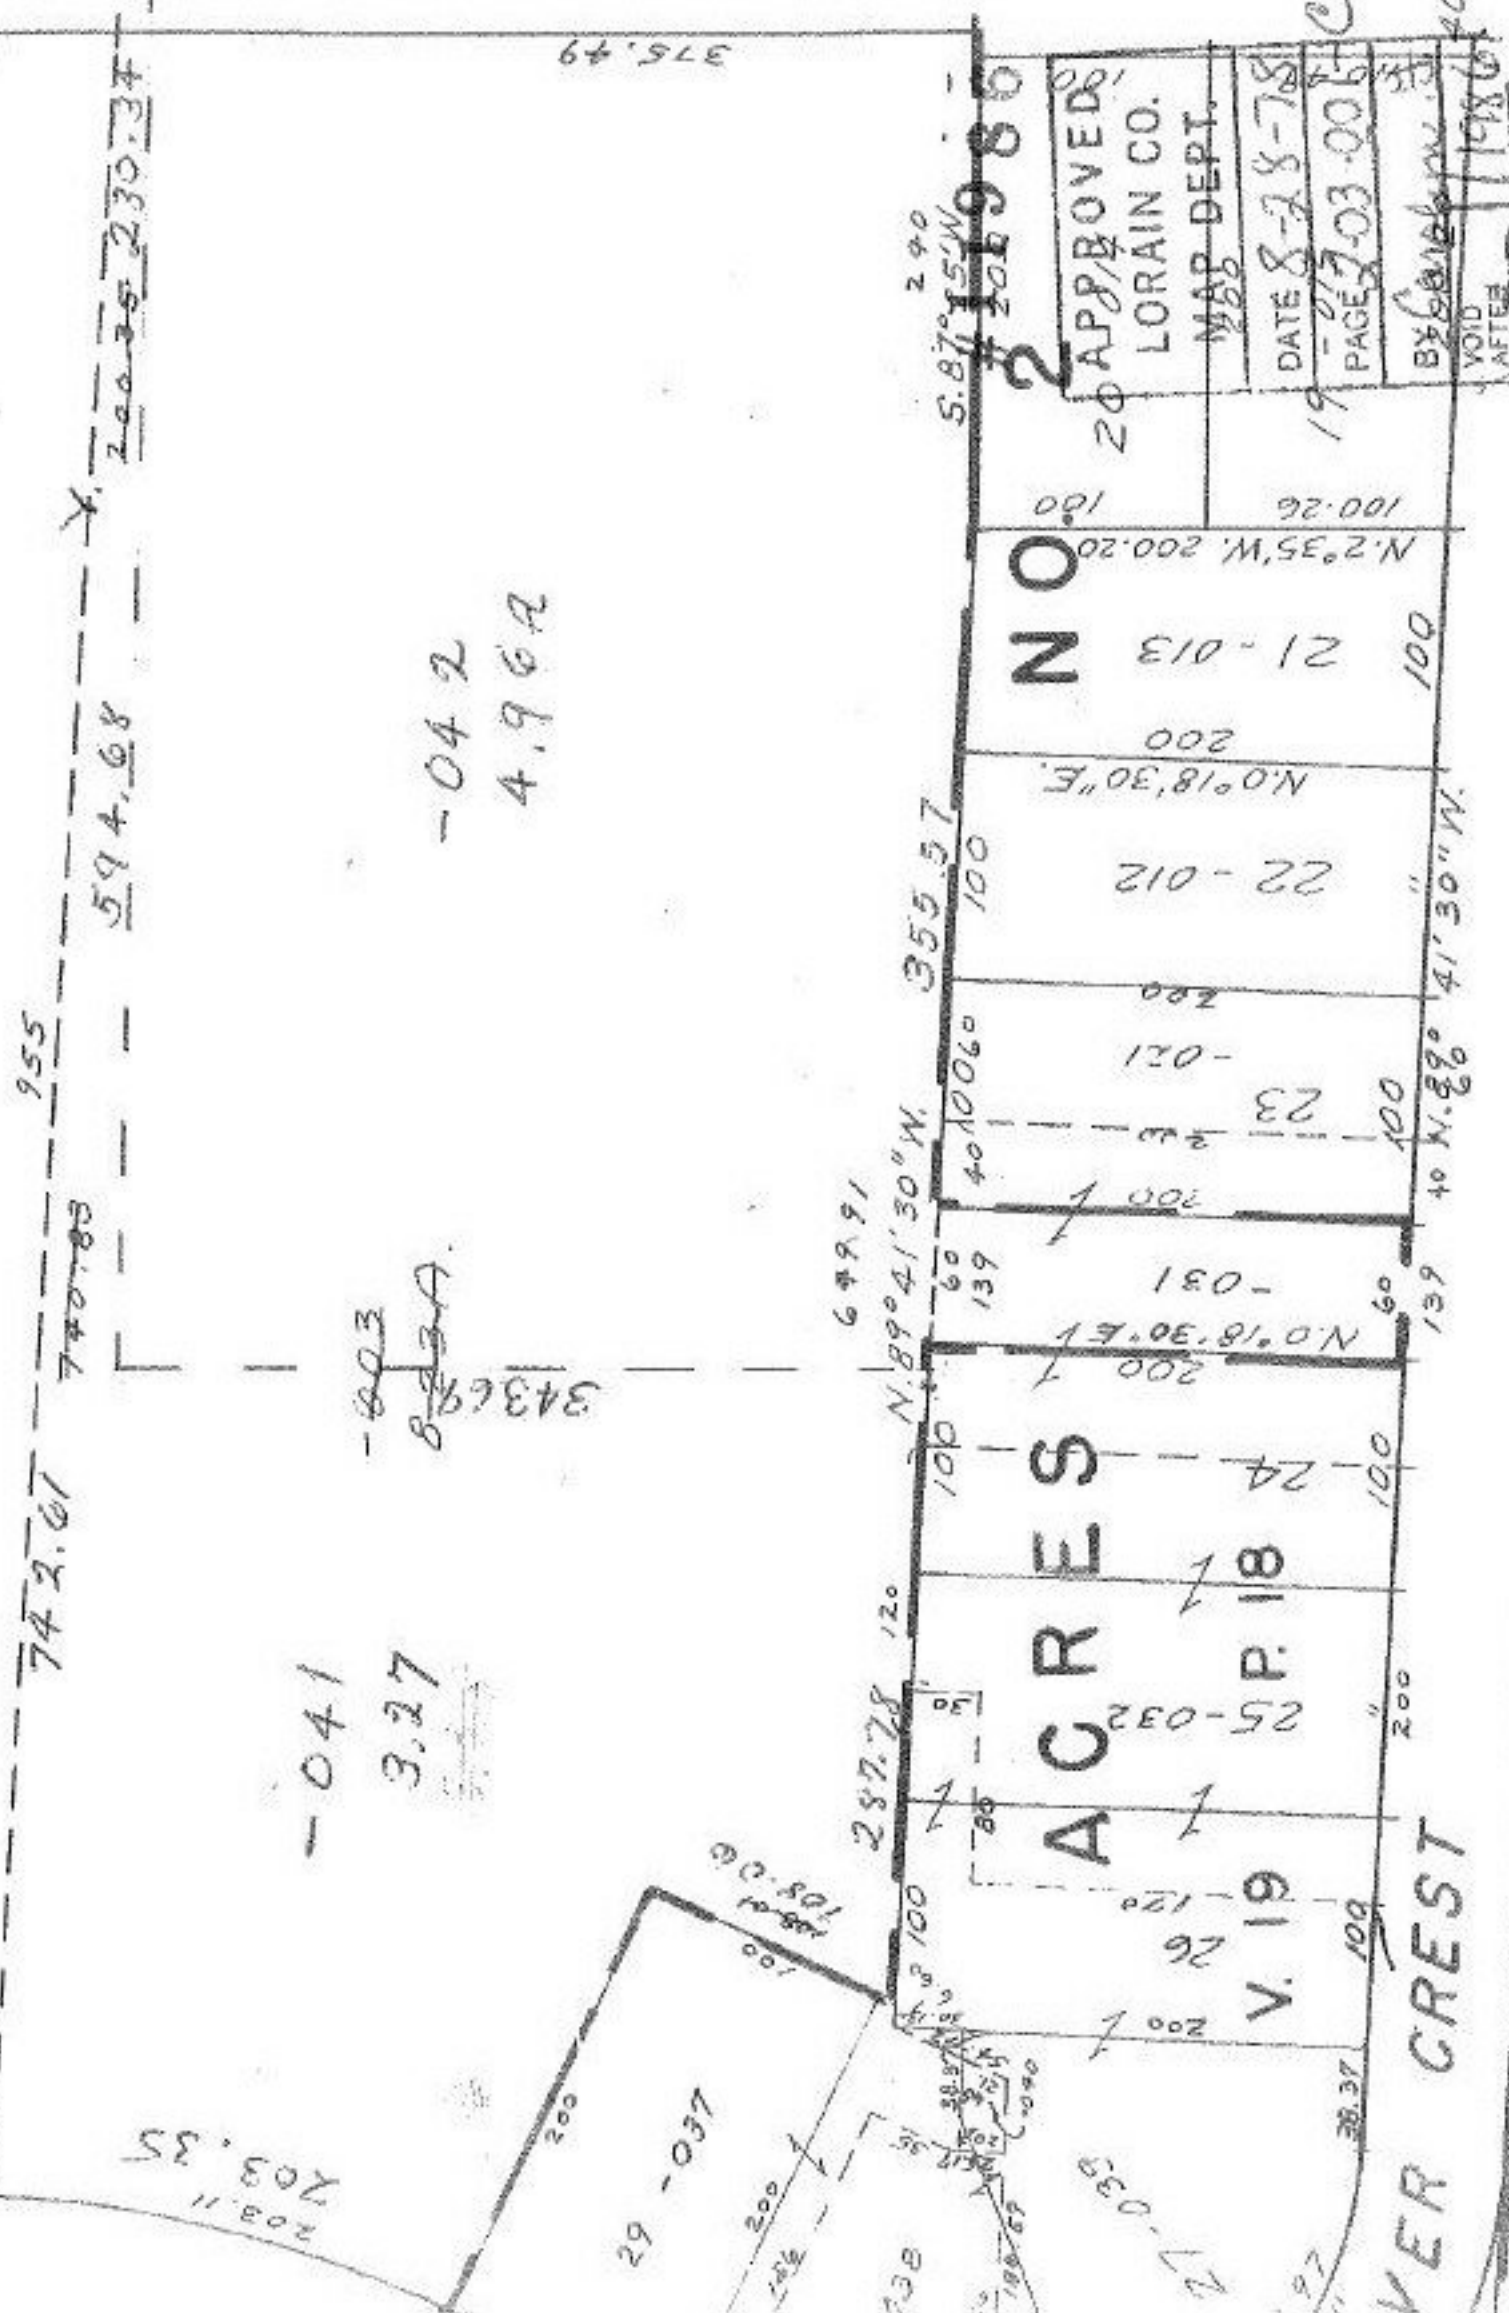

-042
4.96A

~~-003~~
8.23A
3436A

-041
3.27

NO 2 APPROVED
LORAIN CO.
MAB DEPT.
DATE 8-28-78
PAGE 2-03-006
BY [Signature]
VOID AFTER 11/19/80
DR.

105A

203.11
203.35

29-037

ACRES

V.19

VER CREST

18.922
276.81