

335.44

100

100

100

58

100

100

700.49

-080
5.13A

633.16

340.84

SR 11656
11669

PT. -089

~~PT. 067 - PT. 081 - 083~~

PT. 47.09A

~~PT. 53.28A PT. 48.15A 47.62A~~


#11988

APPROVED	
LORAIN CO.	
MAP DEPT.	
DATE	8-28-78
PAGE	10-00-024-B
BY	Carolyn
VOID AFTER	11988

8-9-79

Page Changed
10-00-024-F

SEE 10-00-024-F

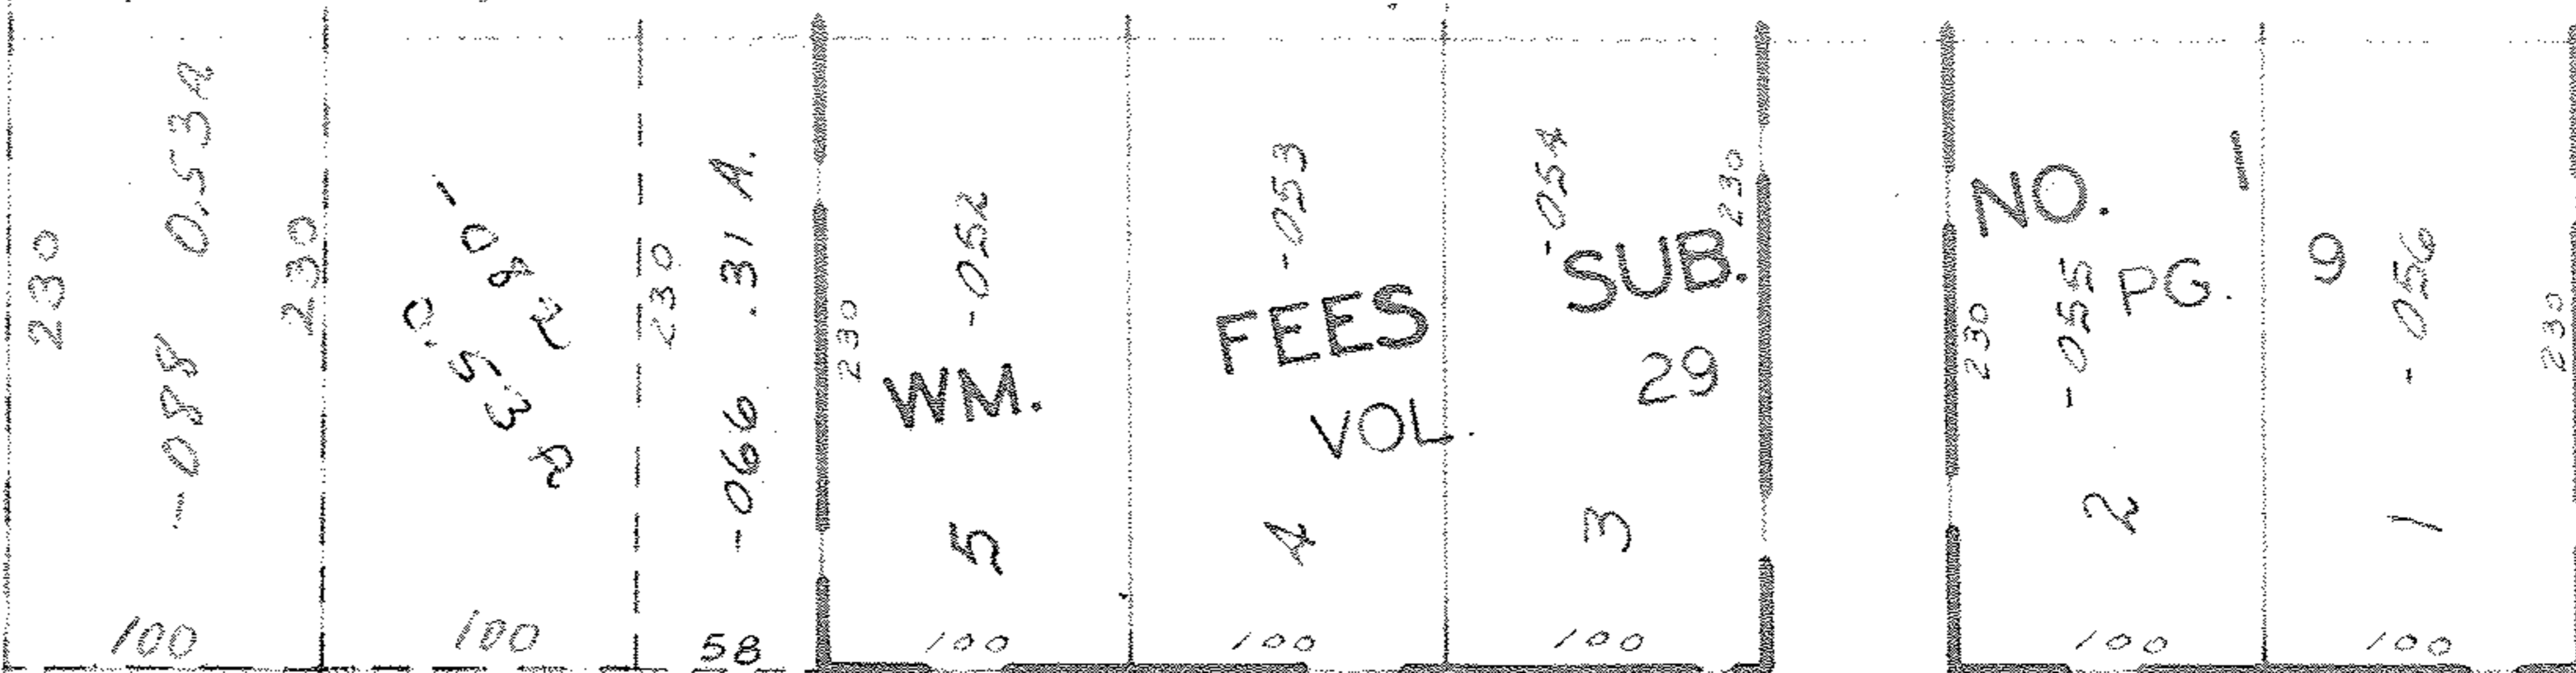

1872 89

153726