

#11997

~~11997~~


#11997

APPROVED
LORAIN CO.
MAP DEPT.
DATE 8 30 78
PAGE 5-00-062-A
BY T. McNeil
VOID AFTER

H.T.

MAY 9 1979

613 90

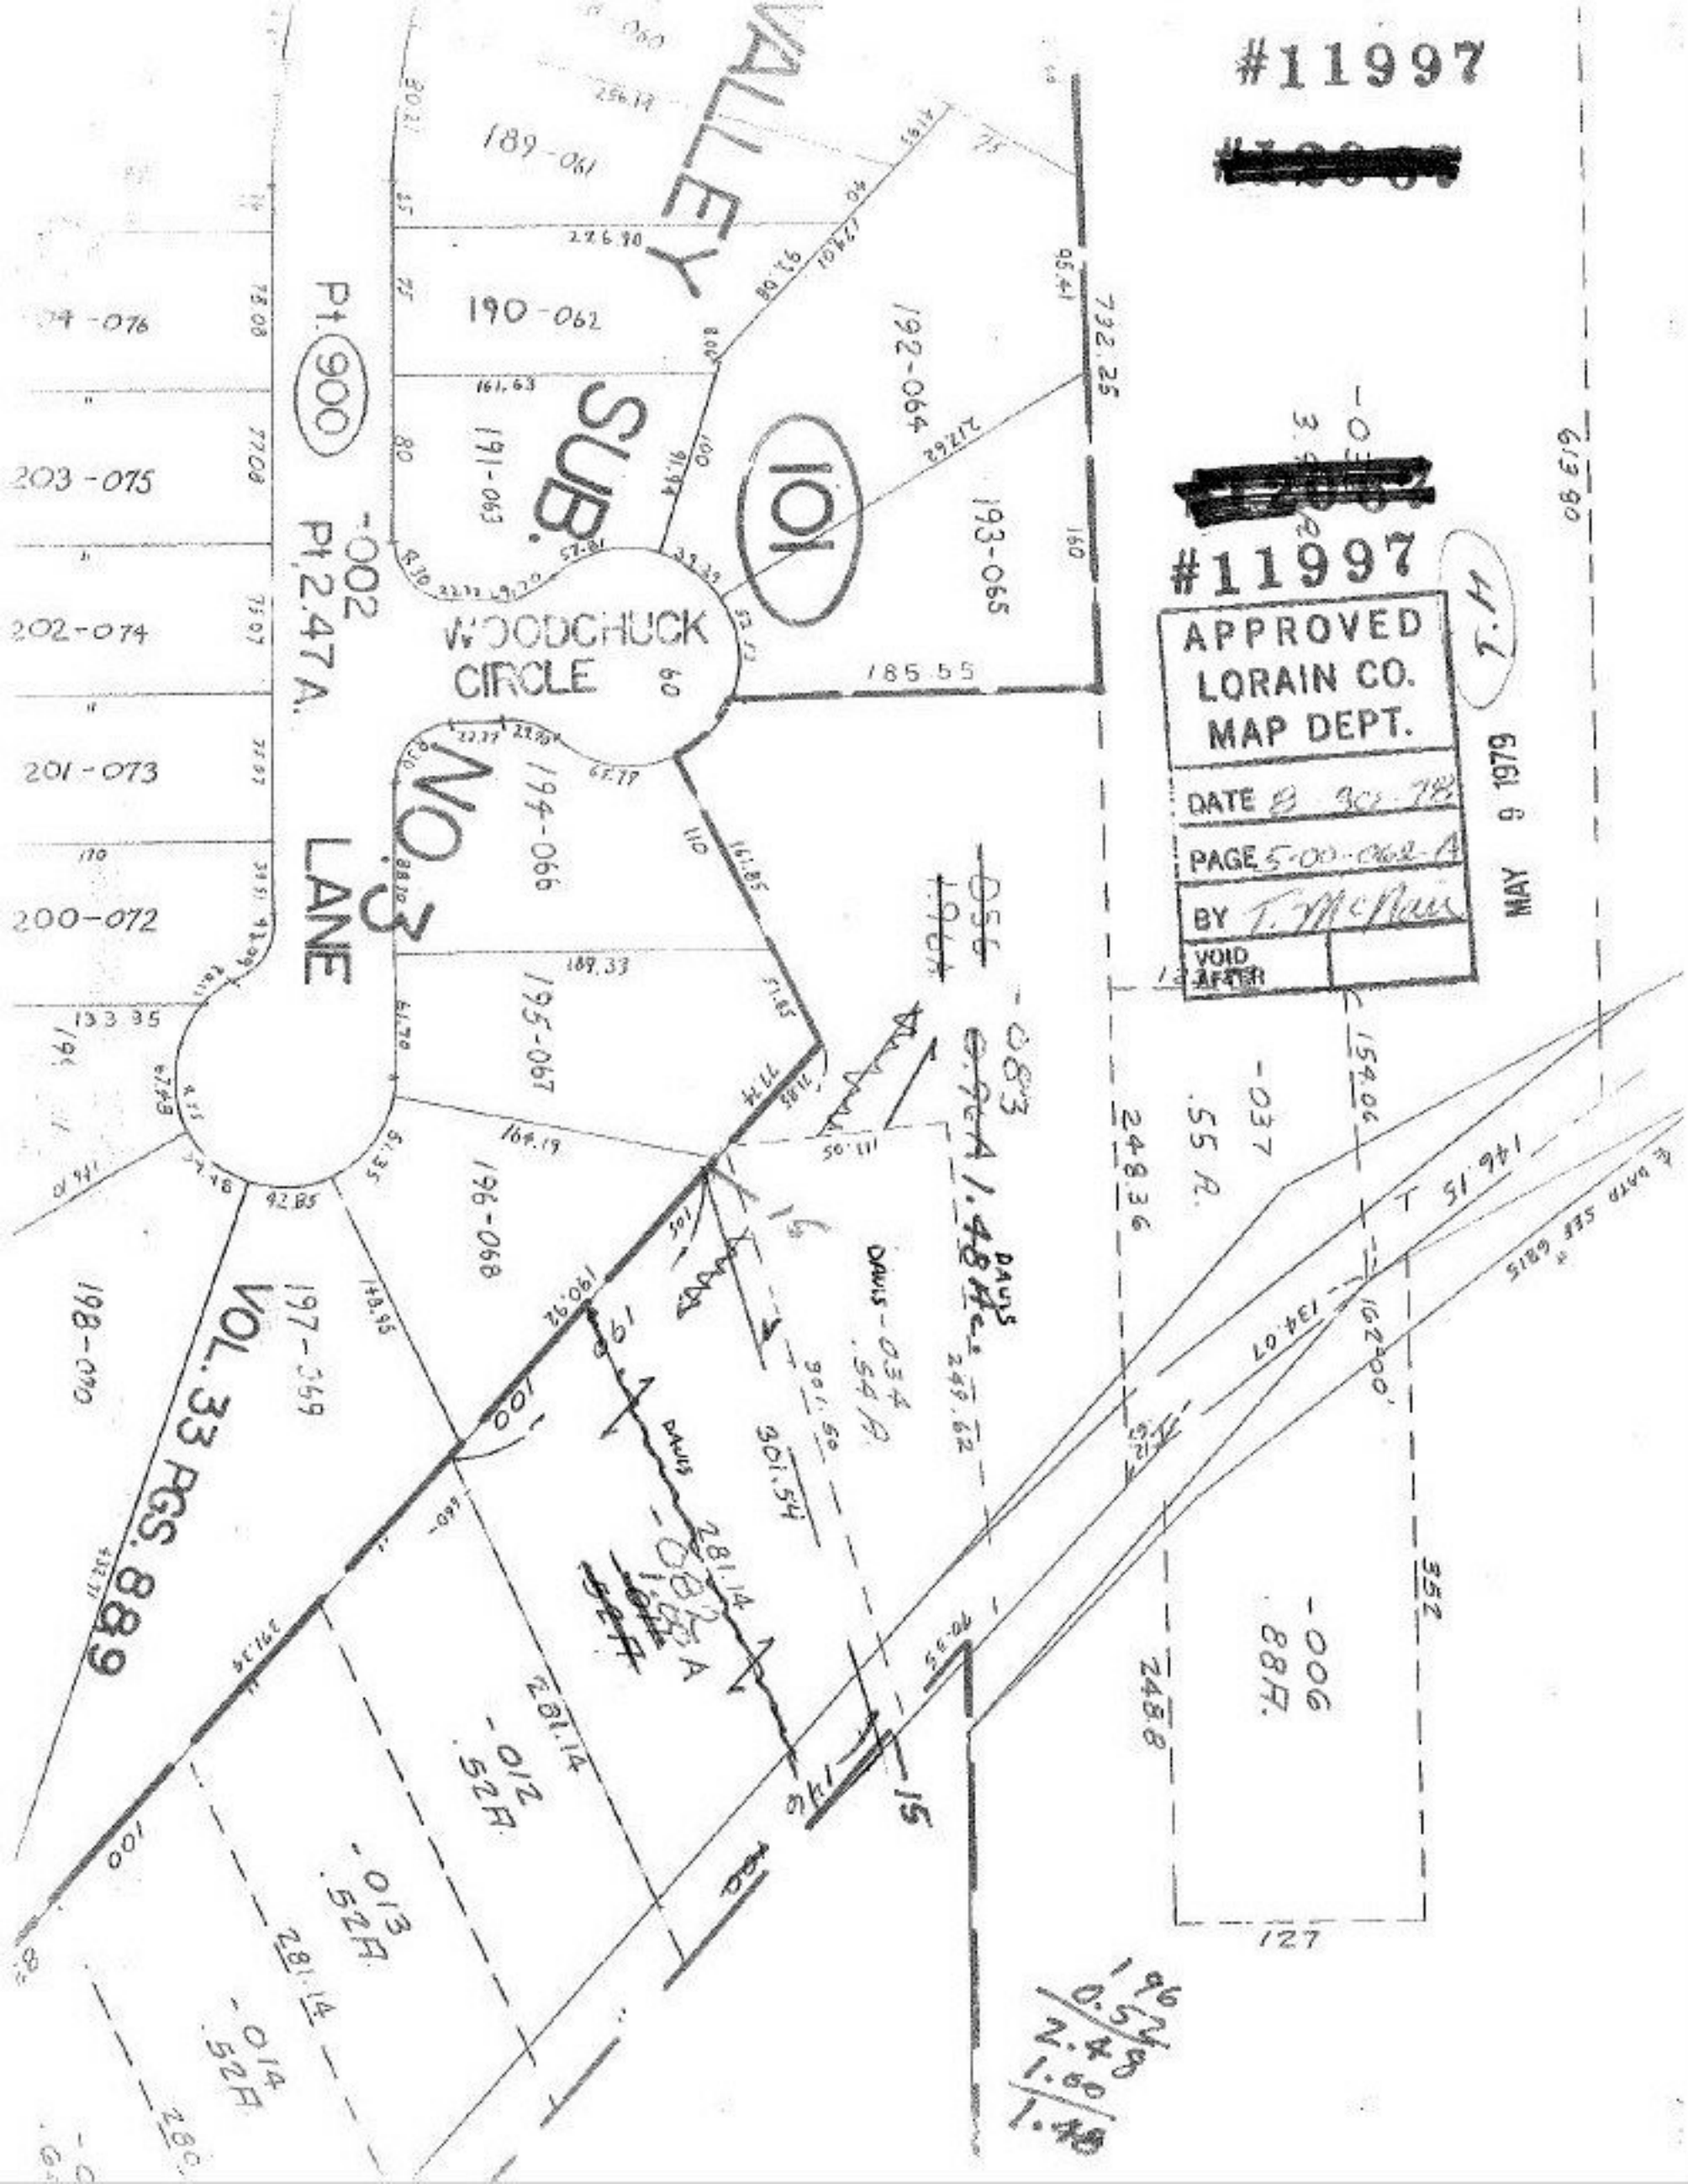

Pt. 900

Pt. 2.47 A.

LANE

VOL. 33 PGS. 889

101

WOODCHUCK CIRCLE

NO 3

DWS - 034 .54 A. 1.48 A. 249.62

DWS - 034 .54 A.

248.36

.55 A.

006 887

196 10/5/78 10/4/78 10/1/78